



west virginia department of environmental protection

Office of Oil and Gas
601 57th Street SE
Charleston, WV 25304
(304) 926-0450
(304) 926-0452 fax

Earl Ray Tomblin, Governor
Randy C. Huffman, Cabinet Secretary
www.dep.wv.gov

April 06, 2016

WELL WORK PERMIT

Horizontal 6A Well

This permit, API Well Number: 47-900178, issued to SWN PRODUCTION COMPANY, LLC, is evidence of permission granted to perform the specified well work at the location described on the attached pages and located on the attached plat, subject to the provisions of Chapter 22 of the West Virginia Code of 1931, as amended, and all rules and regulations promulgated thereunder, and to all conditions and provisions outlined in the pages attached hereto. Notification shall be given by the operator to the Oil and Gas Inspector at least 24 hours prior to the construction of roads, locations, and/or pits for any permitted work. In addition, the well operator shall notify the same inspector 24 hours before any actual well work is commenced and prior to running and cementing casing. Spills or emergency discharges must be promptly reported by the operator to 1-800-642-3074 and to the Oil and Gas inspector.

Please be advised that form WR-35, Well Operators Report of Well Work is to be submitted to this office within 90 days completion of permitted well work, as should form WR-34 Discharge Monitoring Report within 30 days of discharge of pits, if applicable. Failure to abide by all statutory and regulatory provisions governing all duties and operations hereunder may result in suspension or revocation of this permit and, in addition, may result in civil and/or criminal penalties being imposed upon the operators.

In addition to the applicable requirements of this permit, and the statutes and rules governing oil and gas activity in WV, this permit may contain specific conditions which must be followed. Permit conditions are attached to this cover letter.

Per 35CSR-4-5.2.g this permit will expire in two (2) years from the issue date unless permitted well work is commenced. If there are any questions, please feel free to contact me at (304) 926-0499 ext. 1654.

James Martin
Chief

Operator's Well No: RUSSELL HERVEY BRK 1H
Farm Name: HERVEY, RUSSELL D. & LISA K.

API Well Number: 47-900178

Permit Type: Horizontal 6A Well

Date Issued: 04/06/2016

Promoting a healthy environment.

04/08/2016

PERMIT CONDITIONS 4700001170

West Virginia Code § 22-6A-8(d) allows the Office of Oil and Gas to place specific conditions upon this permit. Permit conditions have the same effect as law. Failure to adhere to the specified permit conditions may result in enforcement action.

CONDITIONS

1. This proposed activity may require permit coverage from the United States Army Corps of Engineers (USACE). Through this permit, you are hereby being advised to consult with USACE regarding this proposed activity.
2. If the operator encounters an unanticipated void, or an anticipated void at an unanticipated depth, the operator shall notify the inspector within 24 hours. Modifications to the casing program may be necessary to comply with W. Va. Code § 22-6A-5a (12), which requires drilling to a minimum depth of thirty feet below the bottom of the void, and installing a minimum of twenty (20) feet of casing. Under no circumstance should the operator drill more than one hundred (100) feet below the bottom of the void or install less than twenty (20) feet of casing below the bottom of the void.
3. When compacting fills, each lift before compaction shall not be more than 12 inches in height, and the moisture content of the fill material shall be within limits as determined by the Standard Proctor Density test of the actual soils used in specific engineered fill, ASTM D698, Standard Test Method for Laboratory Compaction Characteristics of Soil Using Standard Effort, to achieve 95 % compaction of the optimum density. Each lift shall be tested for compaction, with a minimum of two tests per lift per acre of fill. All test results shall be maintained on site and available for review.
4. Operator shall install signage per § 22-6A-8g (6) (B) at all source water locations included in their approved water management plan within 24 hours of water management plan activation.
5. Oil and gas water supply wells will be registered with the Office of Oil and Gas and all such wells will be constructed and plugged in accordance with the standards of the Bureau for Public Health set forth in its Legislative rule entitled *Water Well Regulations*, 64 C.S.R. 19. Operator is to contact the Bureau of Public Health regarding permit requirements. In lieu of plugging, the operator may transfer the well to the surface owner upon agreement of the parties. All drinking water wells within fifteen hundred feet of the water supply well shall be flow tested by the operator upon request of the drinking well owner prior to operating the water supply well.
6. Pursuant to the requirements pertaining to the sampling of domestic water supply wells/springs the operator shall, no later than thirty (30) days after receipt of analytical data provide a written copy to the Chief and any of the users who may have requested such analyses.
7. If any explosion or other accident causing loss of life or serious personal injury occurs in or about a well or well work on a well, the well operator or its contractor shall give notice, stating the particulars of the explosion or accident, to the oil and gas inspector and the Chief, within 24 hours of said accident.
8. During the casing and cementing process, in the event cement does not return to the surface, the oil and gas inspector shall be notified within 24 hours.
9. The operator shall provide to the Office of Oil and Gas the dates of each of the following within 30 days of their occurrence: completion of construction of the well pad, commencement of drilling, cessation of drilling, completion of any other permitted well work, and completion of the well. Such notice shall be provided by sending an email to DEPOOGNotify@wv.gov.

SWN

Southwestern Energy®

PO Box 1300
Jane Lew, WV 26378
PHONE: (832) 796-1610

January 14, 2016

Ms. Laura Adkins
Office of Oil & Gas
601 57th Street
Charleston, WV 25304

4700900170

RE: Proposed New Well Russell Hervey BRK 3H & Russell Hervey BRK 1H


Dear Ms. Adkins

Enclosed please find the Well Work Permit Applications for the above captioned wells. These wells are situated on the Hervey's property, in Buffalo District, Brooke County, West Virginia.

If you have any questions or desire additional information, please me at 304-884-1614

Thank you.

Sincerely,

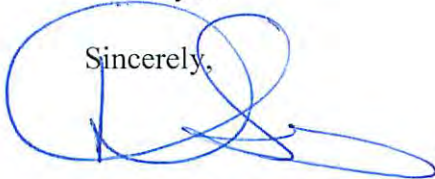

Dee Southall
Regulatory Supervisor
Southwestern Energy Production Company, LLC
PO Box 1300
Jane Lew, WV 26378

RECEIVED
Office of Oil and Gas
JAN 15 2016
RECEIVED
Office of Oil and Gas
FEB 1 2016
WV Department of Environmental Protection
WV Department of Environmental Protection

The Right People doing the Right Things,
wisely Investing the cash flow from
our underlying Assets, will create Value+

04/08/2016

STATE OF WEST VIRGINIA
DEPARTMENT OF ENVIRONMENTAL PROTECTION, OFFICE OF OIL AND GAS
WELL WORK PERMIT APPLICATION

1) Well Operator: SWN Production Co., LLC 494512924 009-Brooke 1-Buffalo 620-Stuebenville
Operator ID County District Quadrangle

2) Operator's Well Number: Russell Hervey BRK 1H Well Pad Name: Russell Hervey Pad

3) Farm Name/Surface Owner: Russell D. Hervey Public Road Access: Pierce Run Road ^{D3} Gendol Ridge Rd.

4) Elevation, current ground: 1166' Elevation, proposed post-construction: 1166'

5) Well Type (a) Gas Oil _____ Underground Storage _____

Other _____

(b) If Gas Shallow Deep _____

Horizontal _____

6) Existing Pad: Yes or No yes *E-7880 10-28-15*

7) Proposed Target Formation(s), Depth(s), Anticipated Thickness and Associated Pressure(s):
Target Formation- Marcellus, Target Top TVD- 5868', Target Base TVD- 5912' Anticipated Thickness- 44', Associated Pressure- 3526

8) Proposed Total Vertical Depth: 5870'

9) Formation at Total Vertical Depth: Marcellus

10) Proposed Total Measured Depth: ~~12,411'~~ 13,805' BW

11) Proposed Horizontal Leg Length: 7162

12) Approximate Fresh Water Strata Depths: 277'

13) Method to Determine Fresh Water Depths: from nearby water wells

14) Approximate Saltwater Depths: 1100'

15) Approximate Coal Seam Depths: 287'

16) Approximate Depth to Possible Void (coal mine, karst, other): None that we are aware of.

17) Does Proposed well location contain coal seams directly overlying or adjacent to an active mine? Yes _____ No

(a) If Yes, provide Mine Info: Name: _____
Depth: _____
Seam: _____
Owner: _____

18)

CASING AND TUBING PROGRAM

TYPE	Size (in)	New or Used	Grade	Weight per ft. (lb/ft)	FOOTAGE: For Drilling (ft)	INTERVALS: Left in Well (ft)	CEMENT: Fill-up (Cu. Ft.)/CTS
Conductor	20"	New	H-40	94#	100'	100'	CTS
Fresh Water	13 3/8"	New	H-40	54.5# 48#	377'	377'	355 sx/CTS
Coal	9 5/8"	New	J-55	40# 30#	2015'	2015'	776 sx/CTS
Intermediate	7"	New	J-55	20#	If Needed	If Needed	If Needed/As Needed
Production	5 1/2"	New	HCP-110	20#	13,865'	13,865'	Lead 833 sx tall 1001 sx/1007 inside ltr
Tubing	2 3/8"	New	P-110	4.7#	Approx. 5870'	Approx. 5870'	
Liners							

E. J. H. 10-28-15

TYPE	Size (in)	Wellbore Diameter (in)	Wall Thickness (in)	Burst Pressure (psi)	Max. Associated Surface Pressure (psi)	Cement Type	Cement Yield (cu. ft./k)
Conductor	20"	30"	0.25	2120	81	Class A	1.19/50% Excess
Fresh Water	13 3/8"	17.5"	0.380	2740	633	Class A	1.19/50% Excess
Coal	9 5/8"	12 1/4"	0.395	3950	1768	Class A	1.19/50% Excess
Intermediate	7"	8 3/4"	0.317	4360	3250	Class A	1.20/15% Excess
Production	5 1/2"	8 3/4"	0.361	12360	9500	Class A	1.20/15% Excess
Tubing	2 3/8"	4.778"	0.190				
Liners							

PACKERS

Kind:	10K Arrowset AS1-X			
Sizes:	5 1/2"			
Depths Set:				

470090072
 RECEIVED
 Office of Oil and Gas
 FEB 17 2016
 WV Department of
 Environmental Protection
 RECEIVED
 Office of Oil and Gas
 JAN 15 2016
 Page 2 of 3
 WV Department of
 Environmental Protection
 04/08/2016

19) Describe proposed well work, including the drilling and plugging back of any pilot hole:

Drill and stimulate any potential zones between and including the Benson to Marcellus. **If we should encounter a void place basket above and below void area- balance cement to bottom of void and grout from basket to surface. Run casing not less than 50' below void nor more than 100' below void. (*If freshwater is encountered deeper than anticipated it must be protected, set casing 50'-70' below and cts.)

20) Describe fracturing/stimulating methods in detail, including anticipated max pressure and max rate:

Well will be perforated within the target formation and stimulated with a slurry of water, sand, and chemical additives at a high rate. This will be performed in stages with the plug and perf method along the wellbore until the entire lateral has been stimulated within the target formation. All stage plugs are then drilled out and the well is flowed back to surface. The well is produced through surface facilities consisting of high pressure production unites, vertical separation units, water and oil storage tanks. Max press and anticipated max rate- 9000 lbs @ 80 barrels a minute.

21) Total Area to be disturbed, including roads, stockpile area, pits, etc., (acres): 27.7

22) Area to be disturbed for well pad only, less access road (acres): 9.9

23) Describe centralizer placement for each casing string:

All casing strings will be ran with a centralizer at a minimum of 1 per every 3 joints of casing.

4700900150

24) Describe all cement additives associated with each cement type:

See Attachment ***

25) Proposed borehole conditioning procedures:

All boreholes will be conditioned with circulation and rotation for a minimum of one bottom up and continuing until operator is satisfied with borehole conditions.

*Note: Attach additional sheets as needed.

RECEIVED
Office of Oil and Gas
FEB 15 2016
RECEIVED
WV Department of
Environmental Protection
Office of Oil and Gas
JAN 15 2016
WV Department of
Environmental Protection
page 1 of 3
04/08/2016

Schlumberger Cement Additives

	Product Name	Product Use	Chemical Name	CAS Number
Surface	S001	accelerator	calcium chloride	10043-52-4
Intermediate	S001	accelerator	calcium chloride	10043-52-4
Kick Off Plug	D080	dispersant	sodium polynaphthalene sulfonate	9008-63-3
	D801	retarder	aromatic polymer derivative	proprietary
	D047	antifoam	polypropylene glycol	25322-69-4
Production-Lead	D167	fluid loss	aliphatic amide polymer	proprietary
	D154	extender	non-crystalline silica	7631-86-9
	D400	gas migration	boric acid	10043-35-3
	D046	antifoam	polypropylene glycol	25322-69-4
			fullers earth (attapulgate)	8031-18-3
	D201	retarder	chrystalline silica	14808-60-7
			metal oxide	proprietary
D202	dispersant	sulphonated synthetic polymer	proprietary	
		formaldehyde (impurity)	proprietary	
Production-Tail	D046	antifoam	polypropylene glycol	25322-69-4
			fullers earth (attapulgate)	8031-18-3
	D167	fluid loss	aliphatic amide polymer	proprietary
	D065	dispersant	sodium polynaphthalene sulfonate	9008-63-3
			sodium sulfate	7757-82-6
	D201	retarder	chrystalline silica	14808-60-7
			metal oxide	proprietary
D153	anti-settling	chrystalline silica	14808-60-7	

4700900170

RECEIVED
Office of Oil and Gas
FEB 17 2016


RECEIVED
Office of Oil and Gas
JAN 15 2016

RECEIVED
Office of Oil and Gas
JAN 08 2016

Southwestern Energy Company

Proposed Drilling Program

Well: RUSSELL HERVEY BRK 1 Re-entry Rig: 0
 Field: PANHANDLE FIELD Prospect: PANHANDLE
 County: BROOKE State: WV
 SHL: 40.2582 Latitude -80.55665 Longitude
 BHL: 40.2765 Latitude -80.57038 Longitude
 KB Elev: 1,191 ft MSL KB: 26 ft AGL GL Elev: 1,165 ft MSL

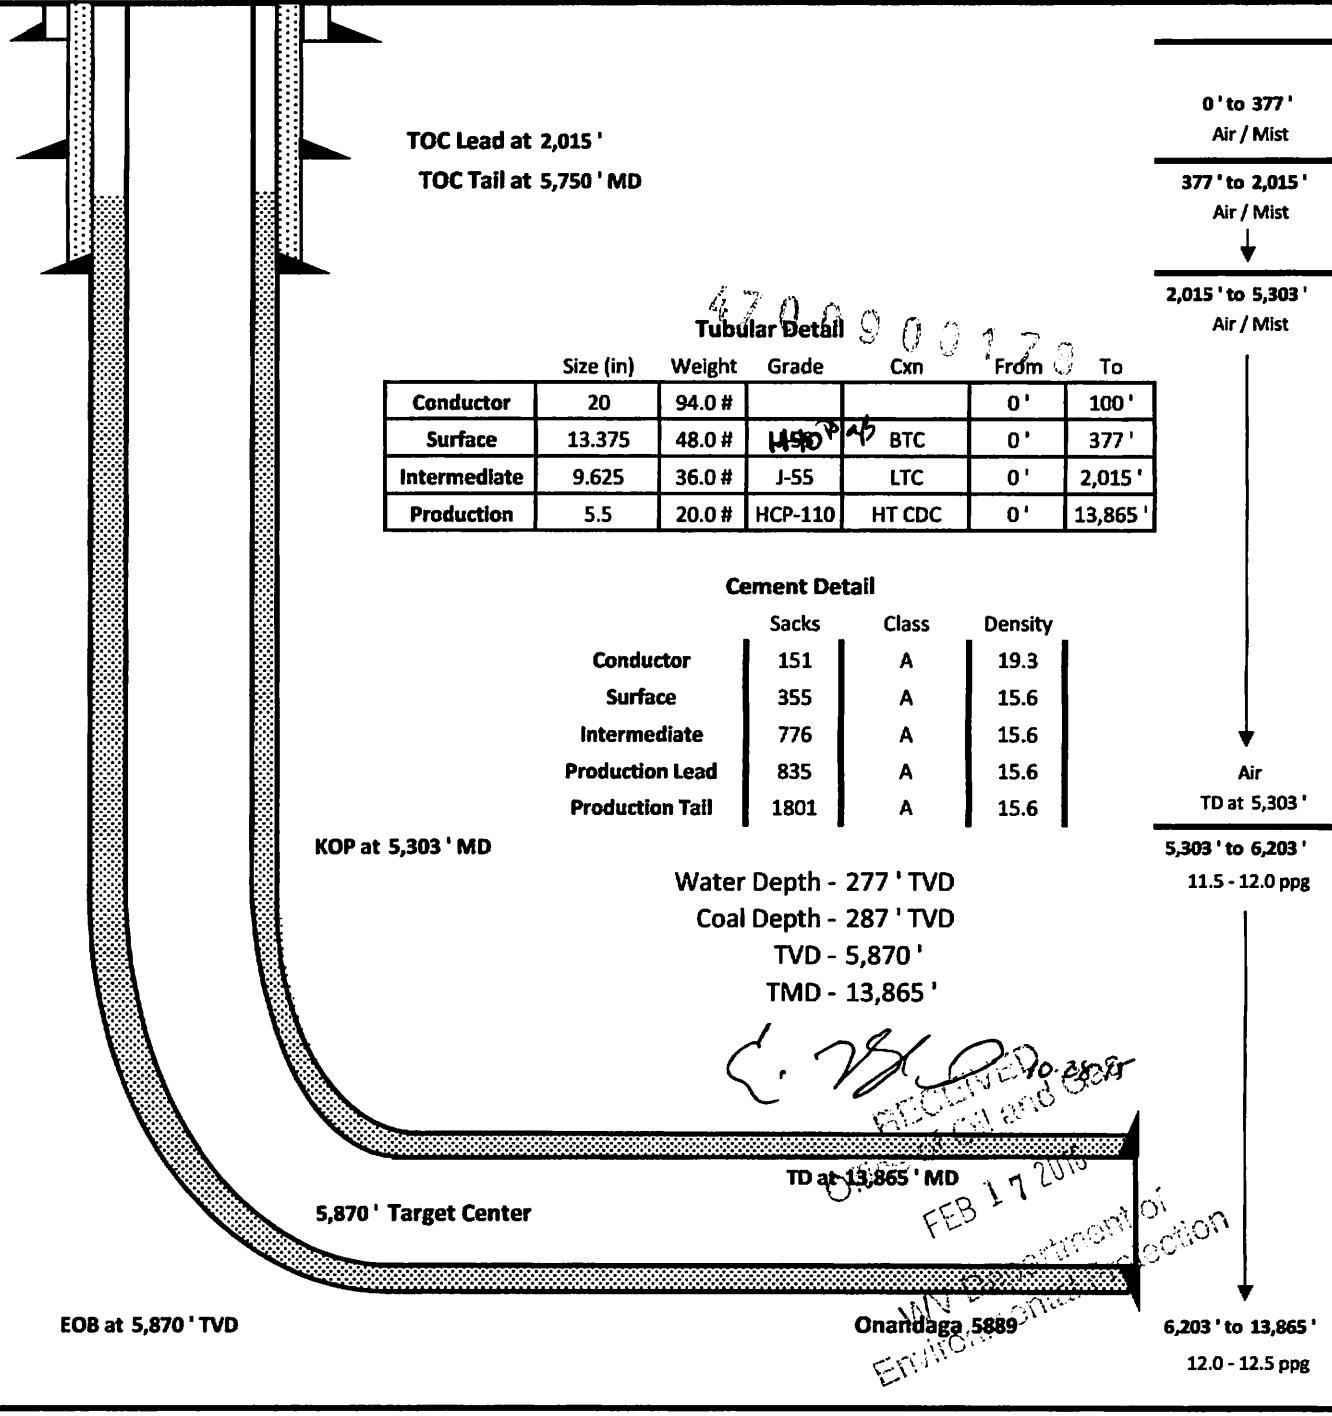

TOC Lead at 2,015'
 TOC Tail at 5,750' MD

4700900170
 Tubular Detail

	Size (in)	Weight	Grade	Cxn	From	To
Conductor	20	94.0 #			0'	100'
Surface	13.375	48.0 #	MS P 45	BTC	0'	377'
Intermediate	9.625	36.0 #	J-55	LTC	0'	2,015'
Production	5.5	20.0 #	HCP-110	HT CDC	0'	13,865'

Cement Detail

	Sacks	Class	Density
Conductor	151	A	19.3
Surface	355	A	15.6
Intermediate	776	A	15.6
Production Lead	835	A	15.6
Production Tail	1801	A	15.6

KOP at 5,303' MD

Water Depth - 277' TVD
 Coal Depth - 287' TVD
 TVD - 5,870'
 TMD - 13,865'

C. V. D.
 RECEIVED
 Office of Oil and Gas
 FEB 17 2016

TD at 13,865' MD

5,870' Target Center

EOB at 5,870' TVD

Onandaga 5889

0' to 377'
 Air / Mist

377' to 2,015'
 Air / Mist

2,015' to 5,303'
 Air / Mist

Air
 TD at 5,303'

5,303' to 6,203'
 11.5 - 12.0 ppg

6,203' to 13,865'
 12.0 - 12.5 ppg

04/08/2016

RECEIVED
 Office of Oil and Gas
 JAN 15 2016
 WV Department of
 Environmental Protection

WW-9
(9/13)

API Number 47 - 69 - _____
Operator's Well No. Russell Hervey BRK 1H

STATE OF WEST VIRGINIA
DEPARTMENT OF ENVIRONMENTAL PROTECTION
OFFICE OF OIL AND GAS

FLUIDS/ CUTTINGS DISPOSAL & RECLAMATION PLAN

Operator Name SWN Production Co., LLC OP Code 494512924

Watershed (HUC 10) Upper Ohio South Quadrangle 620- Steubenville East

Elevation 1166' County 009-Brooke District 1- Buffalo

Do you anticipate using more than 5,000 bbls of water to complete the proposed well work? Yes No

Will a pit be used? Yes No

If so, please describe anticipated pit waste: closed loop system in place at this time- cuttings will be taken to a permitted landfill.

Will a synthetic liner be used in the pit? Yes No If so, what ml.? _____

Proposed Disposal Method For Treated Pit Wastes:

- Land Application
- Underground Injection (UIC Permit Number 2D0072539/ 2D0413175/ 2D0610306/ 2D0610317)
- Reuse (at API Number at next anticipated well, API# will be included with the WR-34/DDMR &/or permit addendum.)
- Off Site Disposal (Supply form WW-9 for disposal location)
- Other (Explain flow back fluids will be put in steel tanks and reused or taken to a permitted disposal facility.)

Will closed loop system be used? If so, describe: Yes

Drilling medium anticipated for this well (vertical and horizontal)? Air, freshwater, oil based, etc. Air drill to KOP, Fluid drill with SOB from KOP to TD

-If oil based, what type? Synthetic, petroleum, etc. Synthetic Oil Base

Additives to be used in drilling medium? see attached sheets

Drill cuttings disposal method? Leave in pit, landfill, removed offsite, etc. landfill

-If left in pit and plan to solidify what medium will be used? (cement, lime, sawdust)

-Landfill or offsite name/permit number? meadow SWF- 1032, SS Grading SWF- 4902, Northwestern SWF- 1025, Short Creek 1034/WV0109517/CID28726, Carbon Limestone 23726/GID28726
Arden Landfill 10072, American 02-12954, Country Wide 38390/CID38390, Pine Grove 13688

I certify that I understand and agree to the terms and conditions of the GENERAL WATER POLLUTION PERMIT issued on August 1, 2005, by the Office of Oil and Gas of the West Virginia Department of Environmental Protection. I understand that the provisions of the permit are enforceable by law. Violations of any term or condition of the general permit and/or other applicable law or regulation can lead to enforcement action.

I certify under penalty of law that I have personally examined and am familiar with the information submitted on this application form and all attachments thereto and that, based on my inquiry of those individuals immediately responsible for obtaining the information, I believe that the information is true, accurate, and complete. I am aware that there are significant penalties for submitting false information, including the possibility of fine or imprisonment.

Company Official Signature _____

Company Official (Typed Name) Dee Southall

Company Official Title Regulatory Supervisor

Subscribed and sworn before me this 22nd day of June

Brittany R Woody

My commission expires 11/27/20



1700900170

RECEIVED
Office of Oil and Gas
FEB 11 2015
JAN 15 2016
WV Department of Environmental Protection

SWN Production Co., LLC

Proposed Revegetation Treatment: Acres Disturbed 27.7 Prevegetation pH _____

Lime as determined by pH test min. 2 _____ Tons/acre or to correct to pH 9.4

Fertilizer type 10-20-20

Fertilizer amount 600 lbs/acre

Mulch Hay/Straw 2.5 Tons/acre

4700900178

Seed Mixtures

Temporary		Permanent	
Seed Type	lbs/acre	Seed Type	lbs/acre
White Grove	15	White Grove	15
Red Top	15	Red Top	15
Orchard Grass	20	Orchard Grass	20

Attach:

Drawing(s) of road, location, pit and proposed area for land application (unless engineered plans including this info have been provided)

Photocopied section of involved 7.5' topographic sheet.

Plan Approved by: [Signature] 6.24.15 [Signature]

Comments: _____

Title: Oil and Gas Inspector Date: 6.24.15 WV Department of Environmental Protection

Field Reviewed? () Yes () No

RECEIVED
Office of Oil and Gas
FEB 17 2016
WV Department of Environmental Protection

RECEIVED
Office of Oil and Gas
JAN 15 2016

**Marcellus Well Drilling Procedures
And Site Safety Plan**

SWN Production Co., LLC

47 - 051 -

Well name: Russell Hervey BRK 1H
Stuebenville East, Quad
Buffalo, District
Brooke County, West Virginia

Submitted by:

Danielle Southall

Date:

6/22/2015

Title Regulatory Supervisor

SWN Production Co., LLC

Approved by:

Date:

6-24-15

Title: Oil & Gas Inspector

Approved by:

Date:

Title:

SWN Production Co., LLC – Confidential

4700900178

RECEIVED
Office of Oil and Gas
FEB 17 2016
WV Department of
Environmental Protection

RECEIVED
Office of Oil and Gas
JAN 15 2016
WV Department of
Environmental Protection

04/08/2016



SWN

Southwestern Energy[®]

SOUTHWESTERN ENERGY
RUSSELL HERVEY BRK
BROOKE CO, WV




Weatherford[®]

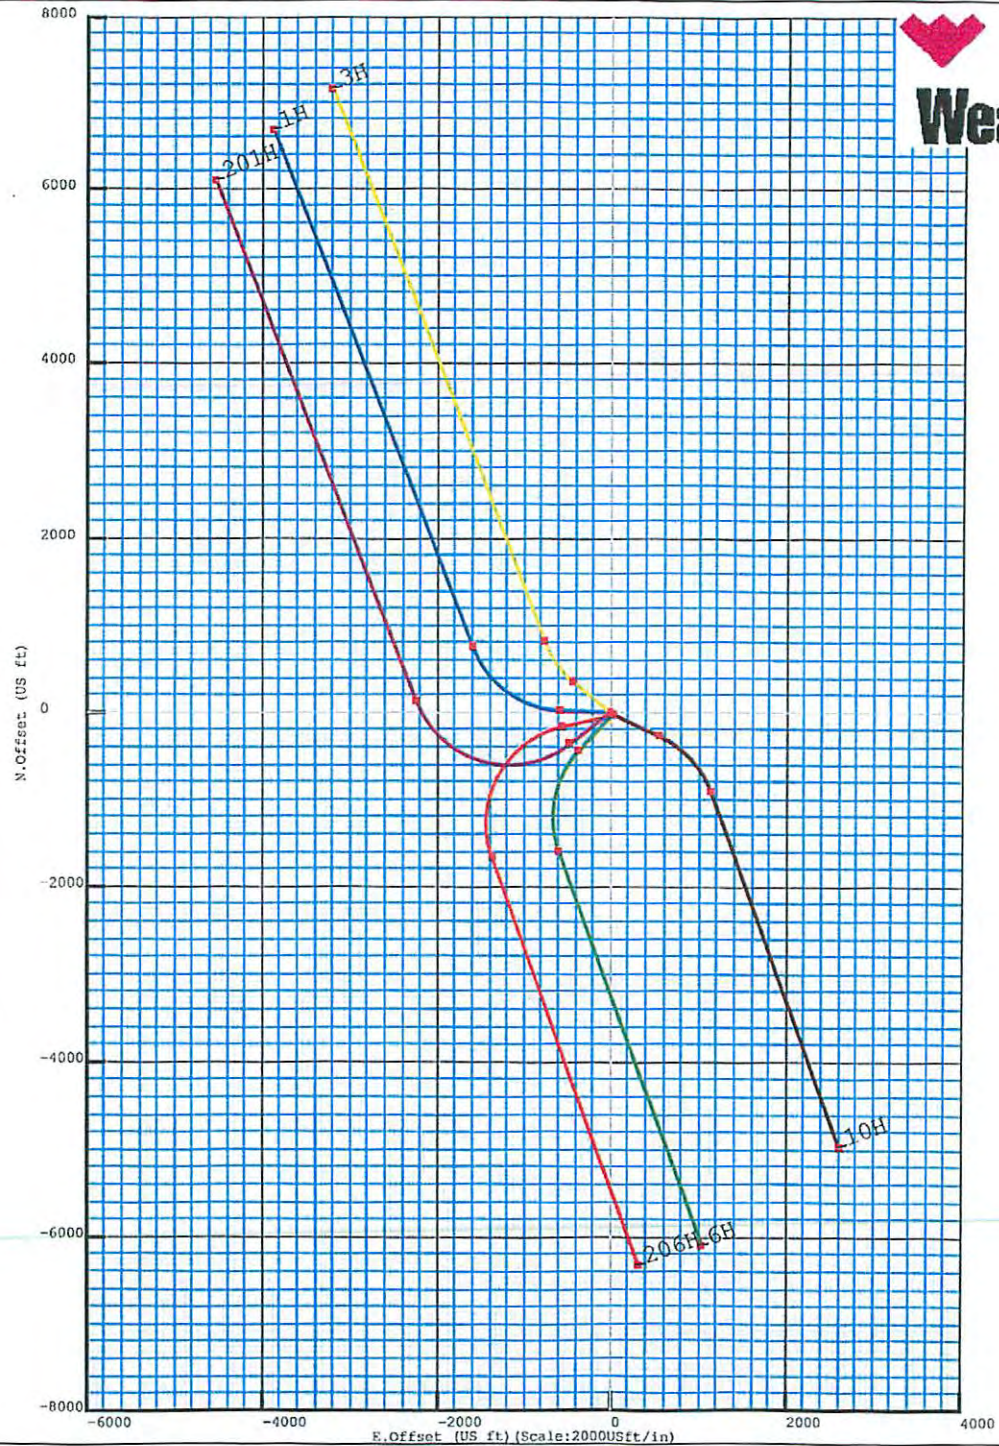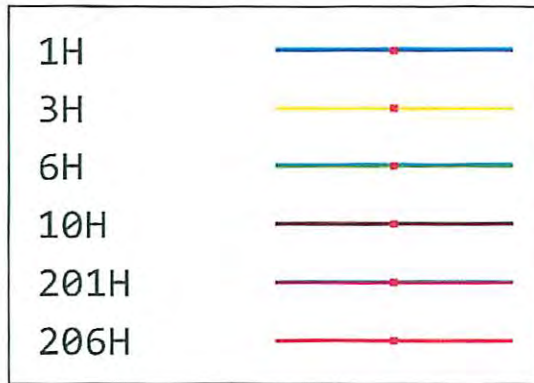

THRASHER

THE THRASHER GROUP, INC.
600 WHITE OAKS BLVD.
BRIDGEPORT, WV 26330
PHONE 304-624-4108

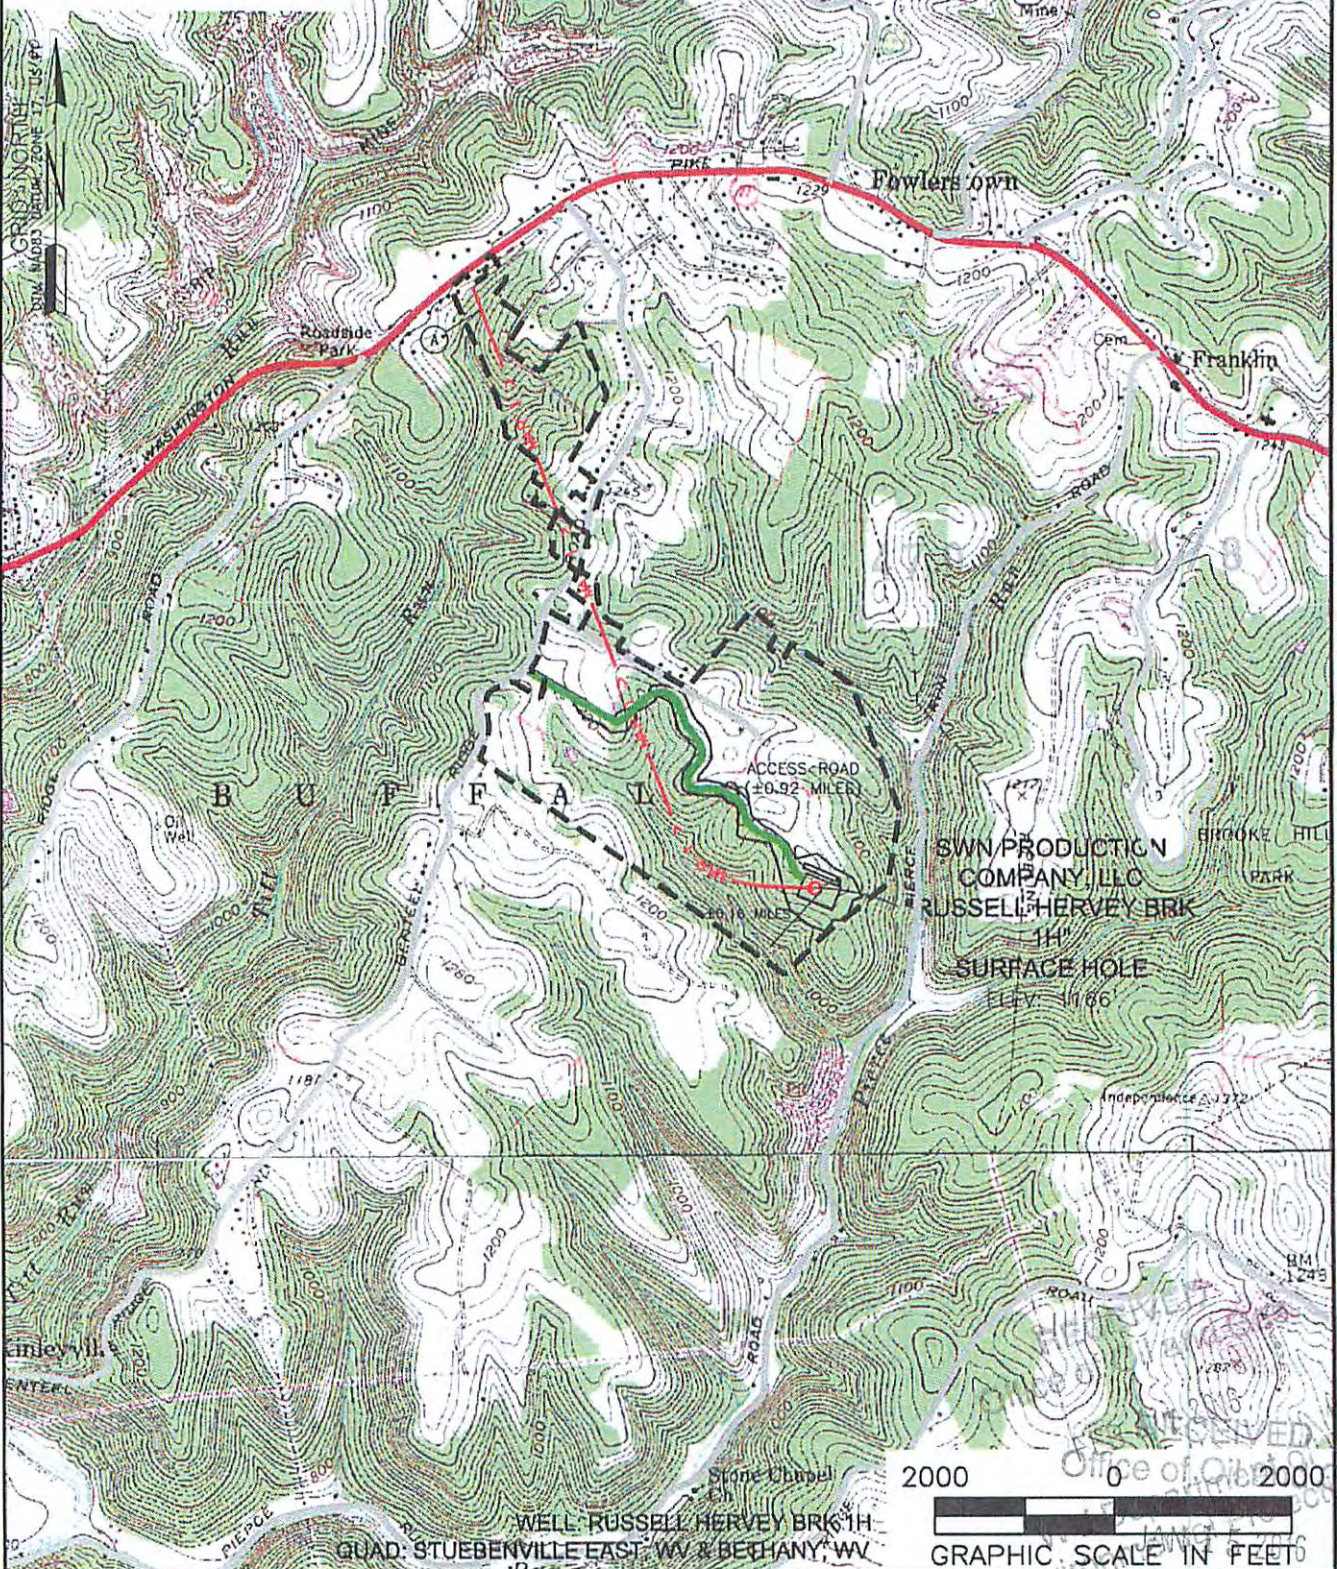

NAME AND DISTANCE TO THE NEAREST STREAM: AN UN-NAMED TRIBUTARY TO PIERCE RUN IS LOCATED ±0.16 MILES SOUTHWEST OF THE CENTER OF THE DRILL PAD.		STREAM CROSSING COORDINATES (NAD 83): A. LAT: 40.275870° / LONG: -80.570052°		COMPANY: SWN Production Company, LLC	
WELL RESTRICTIONS: WELL PAD, LOD, & E & S CONTROL FEATURES TO PERENNIAL STREAM, LAKE, POND, RESERVOIR OR WETLAND: >100 FEET WELL PAD, LOD, & E & S CONTROL FEATURES TO NATURALLY PRODUCING TROUT STREAM: >300 FEET WELL PAD, LOD, & E & S CONTROL FEATURES TO GROUNDWATER INTAKE OR PUBLIC WATER SUPPLY: >1000 FEET WELL SHL TO EXISTING WATER WELL OR DEVELOPED SPRING: >250 FEET CENTER OF PAD TO OCCUPIED DWELLING STRUCTURE: >625 FEET CENTER OF PAD TO AGRICULTURAL BUILDINGS LARGER THAN 2500 SQ FT: >625 FEET		OPERATOR'S: RUSSELL HERVEY BRK		WELL #: 1H	
FEMA FLOOD INFORMATION: NO FLOOD ZONES.		LOCATION: BUFFALO DISTRICT, BROOKE COUNTY, WEST VIRGINIA		SURFACE HOLE LOCATION: GEOGRAPHIC (NAD83): LATITUDE: 40.258164° LONGITUDE: -80.556650°	
LEGEND: ○ PROPOSED SURFACE HOLE / BOTTOM HOLE ○ EXISTING / PRODUCING WELLHEAD ○ ABANDONED WELL ○ PLUGGED & ABANDONED WELL △ CUT CONDUCTOR ○ EXISTING SPRING ○ EXISTING WATER WELL — ACCESS ROAD — ACCESS ROAD TO PREV. SITE — HIGHWAY/INTERSTATE — COUNTY ROAD		BOTTOM HOLE LOCATION: GEOGRAPHIC (NAD83): LATITUDE: 40.276530° LONGITUDE: -80.570378°		REVISIONS: DATE: 12-14-2015 DRAWN BY: E. LYTLE SCALE: 1" = 2000' DRAWING NO: 050-5495 TOPOGRAPHIC MAP	

Top Hole Latitude: 40°17'30" 4,273'
8,097'

Bottom Hole Latitude: 40°17'30" SEE SHEET 2 OF 2



THRASHER

THE THRASHER GROUP, INC.
600 WHITE OAKS BLVD.
BRIDGEPORT, WV 26330
PHONE 304-624-4108


NOTES ON SURVEY

- COORDINATES SYSTEM IS UTM, NAD 83 DATUM, ZONE 17, U.S. FOOT AND WELL COORDINATES ESTABLISHED USING SURVEY GRADE GPS.
- SURFACE AND ROYALTY OWNER INFORMATION AND THEIR BOUNDARIES SHOWN HEREON WERE PLOTTED FROM DEEDS AND/OR TAX PARCEL MAPS PROVIDED BY CLIENT AND FIELD LOCATIONS.
- THIS PLAT DOES NOT REPRESENT A BOUNDARY SURVEY OF THE PARCELS SHOWN HEREON.
- NO DWELLINGS AND BUILDINGS WITHIN 625 FEET OF PROPOSED CENTER OF PAD.
- NO WATER WELLS OR DEVELOPED SPRINGS WITHIN 250 FEET OF PROPOSED WELL.
- NO PERENNIAL STREAMS, LAKES, PONDS, RESERVOIRS OR WETLANDS WITHIN 100 FEET OF THE LIMITS OF DISTURBANCE.
- NO NATURALLY PRODUCING TROUT STREAM WITHIN 300 FEET OF LIMITS OF DISTURBANCE.


LINE	DESCRIPTION	DISTANCE	DESCRIPTION	MONUMENT
L1	S 55°01'34" W	23.93'	SHL TO REF. PNT.	SH 009-00144
L2	S 22°15'02" W	20.02'	SHL TO REF. PNT.	BH 009-00136
L3	N 70°38'44" W	3676.36'	SHL TO LANDMARK	IRF FOUND
L4	N 32°42'54" W	2663.18'	SHL TO LANDMARK	CONCRETE MONUMENT
L5	N 87°33'01" W	572.95'	SHL TO LP	LANDING POINT
L6	N 26°21'42" W	7416.21'	LP TO BHL	BOTTOM HOLE

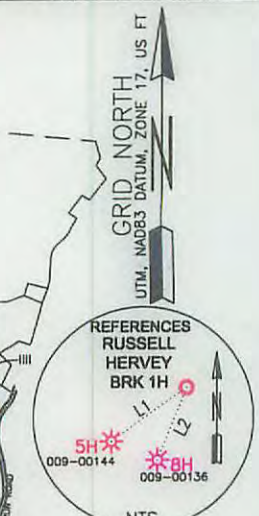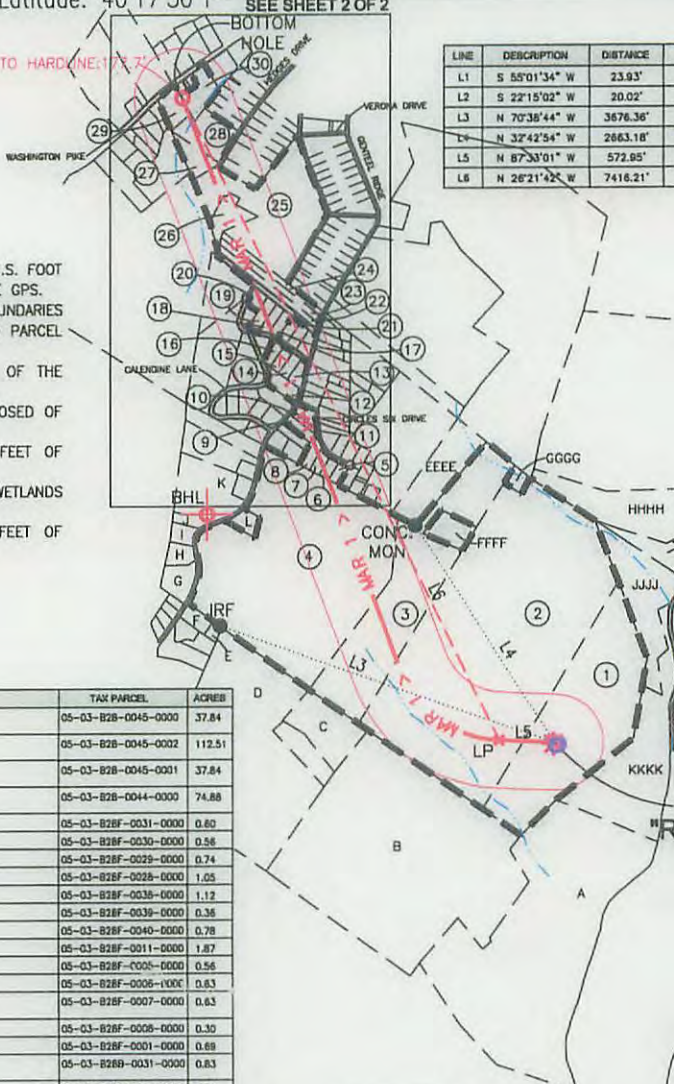

SWN PRODUCTION COMPANY, LLC
"RUSSELL HERVEY BRK 1H"
SURFACE HOLE
ELEV: 1166'

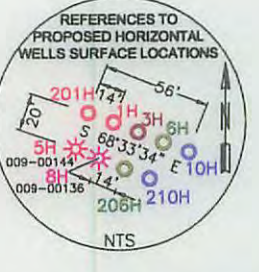

TRACT	SURFACE OWNER (S) / ROYALTY OWNER (R)	TAX PARCEL	ACRES
1	(S)RUSSELL D. HERVEY	05-03-828-0045-0000	37.84
2	(R)RUSSELL D. HERVEY & LISA K. HERVEY	05-03-828-0045-0002	112.51
3	(S)WILLIAM JUDSON HERVEY, III & THERESA J. HERVEY	05-03-828-0045-0001	37.84
4	(S)FREDERICK L. HERVEY	05-03-828-0044-0000	74.88
5	(S)ROBERT G. STANLEY	05-03-828-0044-0000	74.88
6	(S)ROBERT G. STANLEY & ELLEN STANLEY	05-03-828-0044-0000	74.88
7	(S)GEORGE W. BUXTON & ROSEANNE BUXTON	05-03-828F-0031-0000	0.80
8	(S)JAMES LANDWEHR, SR	05-03-828F-0030-0000	0.56
9	(S)BRIAN E. JOHNSON & MARANDA S. JOHNSON	05-03-828F-0029-0000	0.74
10	(S)TIMOTHY J. STANLEY	05-03-828F-0028-0000	1.05
11	(S)ALENA H. MCCALMONT	05-03-828F-0038-0000	1.12
12	(S)ALENA H. MCCALMONT	05-03-828F-0039-0000	0.36
13	(S)JEFFERY R. GROOMS & DENISE M. GROOMS	05-03-828F-0040-0000	0.78
14	(S)HEATHER L. MENNING	05-03-828F-0011-0000	1.87
15	(S)JOHN C. SCHWARTZ & PATRICIA A. SCHWARTZ	05-03-828F-0005-0000	0.56
16	(S)CAMERON L. PUSKARICH & KAROL A. PUSKARICH	05-03-828F-0005-1000	0.83
17	(S)KAROL A. PUSKARICH F/A/KAROL A. BOETICHER	05-03-828F-0007-0000	0.63
18	(S)CAMERON L. PUSKARICH & KAROL A. PUSKARICH	05-03-828F-0008-0000	0.30
19	(S)JOHN W. MOSSGROVE & MELODY D. MOSSGROVE	05-03-828F-0001-0000	0.89
20	(S)JOHN W. MOSSGROVE & MELODY D. MOSSGROVE	05-03-828F-0002-0000	0.83
21	(S)JEFFREY W. DORRANCE, JR.	05-03-828B-0031-0000	1.08
22	(S)ROBERT C. SULT, JR. & M. DEANNE SULT	05-03-828B-0032-0000	1.08
23	(S)JEFFREY W. DORRANCE, JR.	05-03-828B-0033-0000	0.70
24	(S)ROBERT C. SULT, JR. & M. DEANNE SULT	05-03-828B-0034-0000	1.46
25	(S)MICHAEL E. COX & DOROTHY M. COX	05-03-828B-0029-0000	1.98
26	(S)MICHAEL E. COX & DOROTHY M. COX	05-03-828B-0028-0000	1.98
27	(S)MICHAEL E. COX & DOROTHY M. COX	05-03-828B-0027-0000	1.78
28	(S)DAWN E. GOSSARD	05-03-828B-0014-0000	23.06
29	(S)DAWN E. GOSSARD, FKA, DAWN E. GOSSARD & PAUL F. HOMOL	05-03-828B-0015-0000	2.73
30	(S)COREY P. ROMAN, AKA, COREY PAUL ROMAN & DONNA M. ROMAN, AKA, DONNA MARLE ROMAN	05-03-828B-0002-0000	2.13
31	(S)RICHARD A. CHAMP & CINDY A. CHAMP	05-03-823P-0027-0000	4.30
32	(S)JOANNE R. DUNKEL & DONALD K. DUNKEL	05-03-823P-0005-0000	2.23
33	(S)JOANNE R. DUNKEL & DONALD K. DUNKEL	05-03-823P-0009-0000	1.92

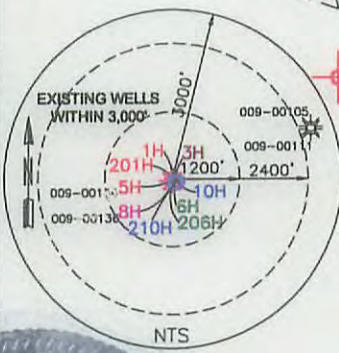

SURFACE HOLE LOCATION (SHL): UTM (NAD83, ZONE 17, METERS): NORTHING: 4,456,505.809 EASTING: 537,701.383
LANDING POINT LOCATION (LPL): UTM (NAD83, ZONE 17, METERS): NORTHING: 4,456,513.274 EASTING: 537,526.906
BOTTOM HOLE LOCATION (BHL): UTM (NAD83, ZONE 17, METERS): NORTHING: 4,458,538.631 EASTING: 536,524.103

I, THE UNDERSIGNED, HEREBY CERTIFY THAT THIS PLAT IS CORRECT TO THE BEST OF MY KNOWLEDGE AND BELIEF AND SHOWS ALL THE INFORMATION REQUIRED BY LAW AND REGULATIONS ISSUED AND PRESCRIBED BY THE DEPARTMENT OF ENVIRONMENTAL PROTECTION.




P.S. 2270 *[Signature]* 3/30/16

<p>(+) DENOTES LOCATION OF WELL ON UNITED STATES TOPOGRAPHIC MAPS</p> <p>WVDEP OFFICE OF OIL & GAS 601 57TH STREET CHARLESTON, WV 25034</p>	<p>MINIMUM DEGREE OF ACCURACY: 1/200</p> <p>PROVEN SOURCE OF ELEVATION: SURVEY GRADE GPS (NAVD 88, US FT)</p>	<p>COMPANY: SWN Production Company, LLC</p> <p>OPERATOR'S WELL #: 1H</p> <p>API WELL #: 47 STATE 009 COUNTY 00178 PERMIT HGA</p>
	<p>WELL TYPE: OIL <input type="checkbox"/> WASTE DISPOSAL <input type="checkbox"/> PRODUCTION <input type="checkbox"/> DEEP <input type="checkbox"/> GAS <input checked="" type="checkbox"/> LIQUID INJECTION <input type="checkbox"/> STORAGE <input type="checkbox"/> SHALLOW <input checked="" type="checkbox"/></p> <p>WATERSHED: BUFFALO CREEK</p> <p>DISTRICT: BUFFALO COUNTY: BROOKE</p> <p>SURFACE OWNER: RUSSELL D. HERVEY</p> <p>OIL & GAS ROYALTY OWNER: RUSSELL D. HERVEY & LISA K. HERVEY</p> <p>DRILL <input checked="" type="checkbox"/> DRILL DEEPER <input type="checkbox"/> REDRILL <input type="checkbox"/> FRACTURE OR STIMULATE <input checked="" type="checkbox"/> PLUG OFF OLD FORMATION <input type="checkbox"/> PERFORATE NEW FORMATION <input type="checkbox"/></p> <p>CONVERT <input type="checkbox"/> PLUG & ABANDON <input type="checkbox"/> CLEAN OUT & REPLUG <input type="checkbox"/> OTHER CHANGE <input type="checkbox"/> (SPECIFY)</p> <p>TARGET FORMATION: MARCELLUS ESTIMATED DEPTH: 5,876' TVD 13,865' TMD</p>	<p>RUSSELL HERVEY BRK</p> <p>ELEVATION: 1166'</p> <p>QUADRANGLE: STEUBENVILLE</p> <p>ACREAGE: ±37.84</p> <p>ACREAGE: ±37.84</p> <p>DESIGNATED AGENT: DEE SOUTHALL</p> <p>ADDRESS: P.O. BOX 1300</p> <p>CITY: JANE LEW STATE: WV ZIP CODE: 26378</p>
<p>LEGEND:</p> <ul style="list-style-type: none"> ○ PROPOSED SURFACE HOLE / BOTTOM HOLE ⊙ EXISTING / PRODUCING WELLHEAD ⊘ ABANDONED WELL ⊙ PLUGGED & ABANDONED WELL △ CUT CONDUCTOR --- LEASE BOUNDARY - - - 500' DHP BUFFER - MAR 1 - MARCELLUS DHP - - - ABANDONED PATH 	<p>REVISIONS:</p> <p>DATE: 03-30-2016</p> <p>DRAWN BY: E. LYTLE</p> <p>SCALE: 1" = 2000'</p> <p>DRAWING NO: 050-5495</p> <p>WELL LOCATION PLAT</p>	

THRASHER

THE THRASHER GROUP, INC.
600 WHITE OAKS BLVD.
BRIDGEPORT, WV 26330
PHONE 304-624-4108

TRACT	ADJOINER	PARCEL
A	STARVAGO INDUSTRIES, INC.	05-03-B33-0025-0000
B	MICHAEL WHITCO & PATRICIA WHITCO	05-03-B28-0043-0000
C	RANDY R. GRAHAM & PATRICIA J. GRAHAM	05-03-B28-0042-0000
D	MICHAEL WHITCO, ET AL.	05-03-B28-0029-0000
E	DAVID F. POSTLETHWAT & ROSANNE POSTLETHWAT	05-03-B28-0041-0000
F	DAVID F. POSTLETHWAT & ROSANNE POSTLETHWAT	05-03-B28-0040-0000
G	DAMEL J. STANLEY	05-03-B28-0003-0001
H	ALISON M. STANLEY & TIMOTHY M. WILLIAMS	05-03-B28-0003-0000
I	CALVIN D. STANLEY & LYNETTE I. STANLEY	05-03-B28-0002-0000
J	CALVIN D. STANLEY	05-03-B28-0001-0000
K	DEWITT STANLEY	05-03-B28-0001-0000
L	ROBERT STANLEY & ELLERY STANLEY	05-03-B28-0024-0000
M	ROBERT C. STANLEY	05-03-B28-0023-0000
N	MELISSA RICHARDSON	05-03-B28-0022-0000
O	THERESA A. KING	05-03-B28-0021-0000
P	THERESA A. KING	05-03-B28-0020-0000
Q	BRIAN SOLY, ET AL.	05-03-B28-0019-0000
R	THOMAS H. BLOOM	05-03-B28-0018-0000
S	THOMAS H. BLOOM & LOS J. BLOOM	05-03-B28-0017-0000
T	DAVID A. FILLINGER & DARLENE M. FILLINGER	05-03-B28-0016-0000
U	HEATHER L. MENNING	05-03-B28-0015-0000
V	JEFFREY W. DORRANCE JR.	05-03-B28-0014-0000
W	JEFFREY W. DORRANCE JR.	05-03-B28-0013-0000
X	RICHARD I. SMS & PATRICIA A. SMS	05-03-B28-0012-0000
Y	RICHARD I. SMS & PATRICIA A. SMS	05-03-B28-0011-0000
Z	MICHAEL E. COX & DOROTHY M. COX	05-03-B28-0010-0000
AA	FOUR SWANS LP	05-03-B28-0009-0000
BB	DANIEL L. GILCHRIST & JOANNE GILCHRIST	05-03-B28-0008-0000
CC	BETTY L. HARRIS	05-03-B28-0007-0000
DD	EDITH E. MCCORMICK	05-04-CC23-0240-0000
EE	KATHERINE B. METZ & STEVEN L. METZ	05-03-B23P-0006-0000
FF	JAMES W. FERGUSON & CONSTANCE N. FERGUSON, TRUSTEES OF THE 1997 FERGUSON TRUST	05-04-CC23-0240-0000
GG	STEVEN L. METZ II	05-03-B23P-0007-0000
HH	STEVEN L. METZ II	05-03-B23P-0008-0000
II	LOIS E. DAUGHERTY	05-04-CC23-0241-0000
JJ	JOYCE S. WILSON	05-04-CC23-0242-0000
KK	ROBERT L. FRESHWATER	05-03-B23P-0010-0000
LL	RONALD G. PHELPS & RUTH L. PHELPS	05-03-B23P-0024-0000
MM	JOSEPH W. CASEMAN & GRETCHEN D. CASEMAN	05-03-B23P-0025-0000
NN	TIMOTHY P. MOORE	05-03-B23P-0026-0000
OO	ROBERT CLARK	05-03-B23P-0028-0000
PP	GREGORY A. SMITH & KELLY J. SMITH	05-03-B280-0004-0000
QQ	JOHN FOLIO	05-03-B280-0003-0000
RR	ROBERT CLARK	05-03-B23P-0029-0000
SS	RONALD MISHO & GLENNIS MISHO	05-03-B23P-0030-0000
TT	CHARLES D. KIRCHNER & KAREN S. KIRCHNER	05-03-B23P-0031-0000
UU	HARRY M. MYERS & ANNETTE M. MYERS	05-03-B280-0005-0000
VV	JOHN E. LEONARD JR. & JOYCE L. LEONARD	05-03-B280-0006-0000
WW	FREND A. LANCASTER	05-03-B280-0007-0000
XX	DONALD C. TENNANT & JOYCE A. TENNANT	05-03-B280-0008-0000
YY	TONYA DAVIDSON	05-03-B280-0009-0000
ZZ	LUTHER W. HOLZEN	05-03-B280-0010-0000
AAA	KENNETH R. KEMPER JR. ET AL.	05-03-B280-0011-0000
BBB	KENNETH R. KEMPER JR. ET AL.	05-03-B280-0012-0000
CCC	JANICE L. RURNAN	05-03-B280-0017-0000
DDD	JANICE L. RURNAN	05-03-B280-0018-0000
EEE	DONALD L. SMITH & CAROLYN J. SMITH	05-03-B280-0019-0000
FFF	PHILIP A. CONLEY ET AL.	05-03-B280-0020-0000
GGG	WILLIAM J. WELLS & PATRICIA L. WELLS	05-03-B280-0021-0000
HHH	NATHAN GAGICH	05-03-B280-0022-0000
III	AMANDA J. BENZO	05-03-B280-0023-0000
JJJ	AMANDA J. BENZO	05-03-B280-0024-0000
KKK	HARRY M. MYERS III & SARAH M. MYERS	05-03-B280-0025-0000
LLL	WALTER L. STATEN & JULIA P. STATEN	05-03-B280-0026-0000
MMM	DENNIS M. POLIGA & KAREN L. POLIGA	05-03-B280-0038-0000
NNN	DENNIS M. POLIGA & KAREN L. POLIGA	05-03-B280-0037-0000
OOO	JOHN S. KORBIN & BEVERLY J. KORBIN	05-03-B280-0058-0000
PPP	VIRGIL E. COEN & ALFREDA COEN	05-03-B280-0004-0000
QQQ	VIRGIL E. COEN & ALFREDA COEN	05-03-B280-0003-0000
RRR	JOHN W. MOSSGROVE & MELDODY D. MOSSGROVE	05-03-B280-0002-0000
SSS	US BANK NA	05-03-B280-0048-0000
TTT	KENNETH C. CHIVERS & ETHEL C. CHIVERS	05-03-B280-0048-0000
UUU	FAYE N. MOON II & LINDA K. MOON	05-03-B280-0041-0000
VVV	STEPHEN J. HUNTER	05-03-B280-0042-0000
WWW	JAMES V. FIDAZZO JR. & CHRIS FIDAZZO	05-03-B280-0043-0000
XXX	JAMES V. FIDAZZO JR. & CHRIS FIDAZZO	05-03-B280-0044-0000
YYY	JAMES V. FIDAZZO JR. & CHRIS FIDAZZO	05-03-B280-0045-0000
ZZZ	CHARLES F. BAKER & SHERYL L. BAKER	05-03-B280-0046-0000
AAAA	JAMES L. STOCK & DIANNE L. STOCK	05-03-B280-0032-0000
BBBB	MICHAEL E. DIGHT & DANIE M. DIGHT	05-03-B280-0033-0000
CCCC	DAVID PERINE & DIANA PERINE	05-03-B280-0035-0000
DDDD	KENNETH DIGHT & JANE C. DIGHT	05-03-B280-0036-0000
EEEE	THOMAS J. MELLER & TONIA S. MELLER	05-03-B280-0046-0000
FFFF	CHARLES D. FARRIS & BRITNEY L. FARRIS	05-03-B280-0045-0004
GGGG	JAMES R. HERVEY & KAREN L. HERVEY	05-03-B280-0045-0003
HHHH	DONALD EATON & JANICE EATON	05-03-B280-0057-0000
IIII	BERNARD J. KNORR III & NICOLE C. KNORR	05-03-B280-0057-0002
JJJJ	BERNARD J. KNORR III & NICOLE C. KNORR	05-03-B280-0059-0000
KKKK	BROOKE COUNTY PARK COMMISSION	05-03-B280-0064-0000

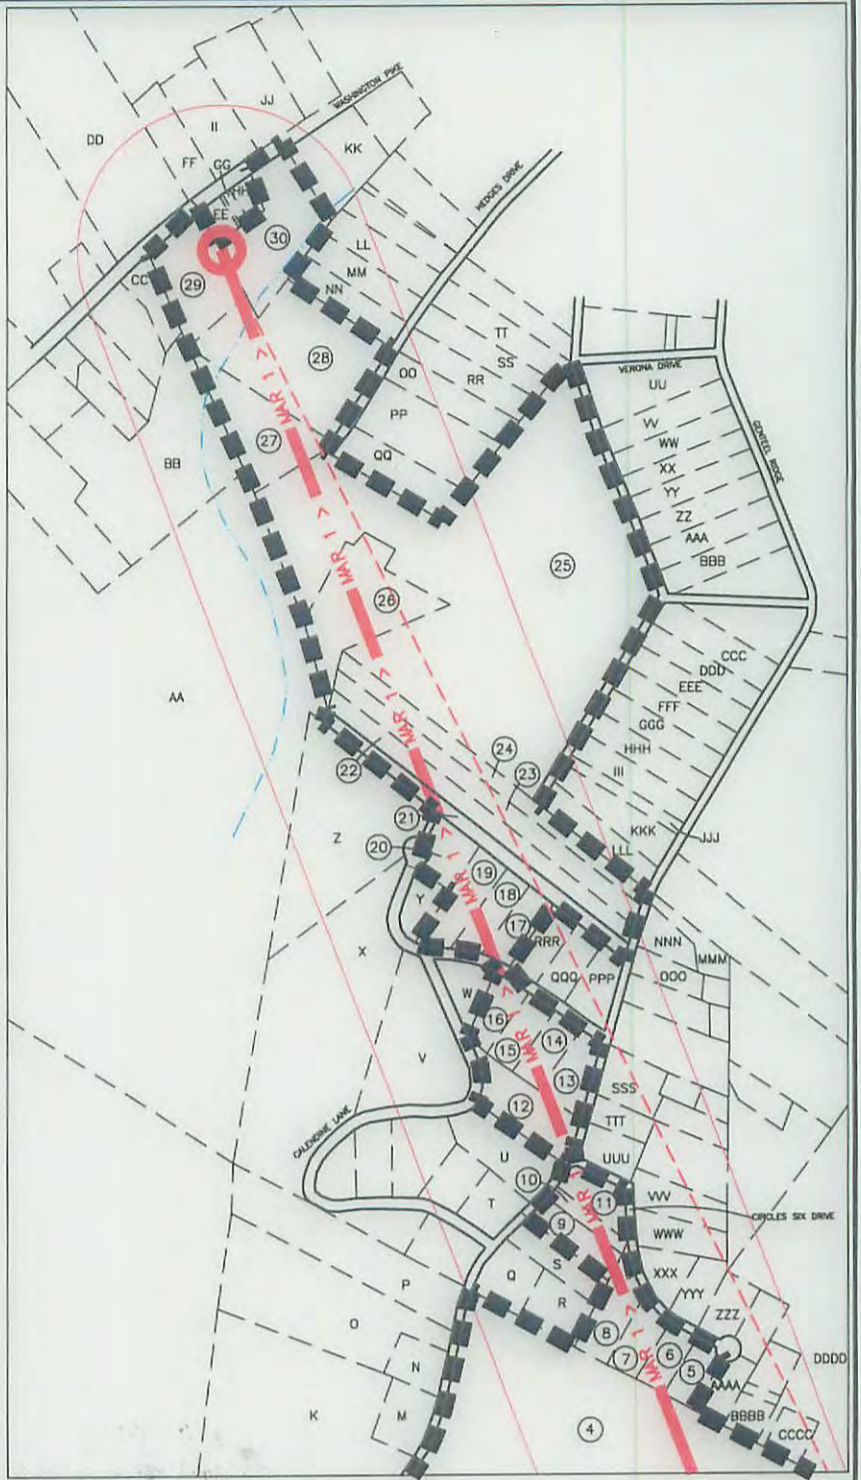

04/08/2016

COMPANY:
SWN **SWN** *R⁺ V⁺*
 Production Company, LLC Production Company™

REVISIONS:	DATE: 03-30-2016
	SHEET 2 OF 2
	DRAWN BY: E. LYTLE
	SCALE: NOT TO SCALE
	DRAWING NO: 050-5495
	WELL LOCATION PLAT

**INFORMATION SUPPLIED UNDER WEST VIRGINIA CODE
Chapter 22, Article 6A, Section 5(a)(5)
IN LIEU OF FILING LEASE(S) AND OTHER CONTINUING CONTRACT(S)**

Under the oath required to make the verification on page 1 of this Notice and Application, I depose and say that I am the person who signed the Notice and Application for the Applicant, and that –

- (1) the tract of land is the same tract described in this Application, partly or wholly depicted in the accompanying plat, and described in the Construction and Reclamation Plan;
- (2) the parties and recordation data (if recorded) for lease(s) or other continuing contract(s) by which the Applicant claims the right to extract, produce or market the oil or gas are as follows:

Lease Name or Number	Grantor, Lessor, etc.	Grantee, Lessee, etc.	Royalty	Book/Page
----------------------	-----------------------	-----------------------	---------	-----------

4700900170

RECEIVED
Office of Oil and Gas
FEB 17 2016
WV Department of
Environmental Protection

**Acknowledgement of Possible Permitting/Approval
In Addition to the Office of Oil and Gas**

The permit applicant for the proposed well work addressed in this application hereby acknowledges the possibility of the need for permits and/or approvals from local, state, or federal entities in addition to the Office of Oil and Gas, including but not limited to the following:


- WV Division of Water and Waste Management
- WV Division of Natural Resources WV Division of Highways
- U.S. Army Corps of Engineers
- U.S. Fish and Wildlife Service
- County Floodplain Coordinator

RECEIVED
Office of Oil and Gas

JAN 15 2016

WV Department of
Environmental Protection

The applicant further acknowledges that any Office of Oil and Gas permit in no way overrides, replaces, or nullifies the need for other permits/approvals that may be necessary and further affirms that all needed permits/approvals should be acquired from the appropriate authority before the affected activity is initiated.

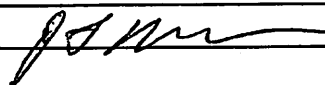Well Operator: SWN Production Company, LLC.
 By: Jerry L. Bridgens, CPL 
 Its: Staff Landman

Tract #	TMP	Surface Owner	Deeded Acreage	Vesting BK/PG	Mineral Deed	Lease #	Lessor	Lessee	Royalty	BK/PG
1)	3-B28-45	Russell D. Hervey	37.84	332/688		1-342823-000	Russell D. Hervey and Lisa K. Hervey Chesapeake Appalachia, LLC	Chesapeake Appalachia, LLC SWN Production Company	18.000%	17/89 30/480
2)	3-B28-45.2	William Judson Hervey, III	112.51	332/674		1-357923-000	William Judson Hervey, III and Theresa J. Hervey Chesapeake Appalachia, LLC	Chesapeake Appalachia, LLC SWN Production Company	18.000%	20/439 30/480
3)	3-B28-45.1	Frederick L. Hervey	37.84	332/667		1-342824-000	Frederick L. Hervey and Cathy Jo Hervey Chesapeake Appalachia, LLC	Chesapeake Appalachia, LLC SWN Production Company	18.000%	17/94 30/480
4)	3-B28-44	Robert G. Stanley	74.88	288/387		1-324522-000	Robert G. Stanley and Ellen Stanley Julie K. Stanley, Life Tenant Fortuna Energy, Inc. Range Resources-Appalachia, LLC Chesapeake Appalachia, LLC	Fortuna Energy, Inc. Range Resources-Appalachia, LLC Chesapeake Appalachia, LLC SWN Production Company	18.000%	9/650 10/207 10/552 30/480
5)	3-B28F-31	George W. Buxton and Roseanne Buxton	0.60	241/33		1-358007-000	George W. Buxton and Roseanne Buxton Chesapeake Appalachia, LLC	Chesapeake Appalachia, LLC SWN Production Company	18.000%	21/675 30/480
6)	3-B28F-30	James Landwehr, Sr.	0.56	332/236		1-358036-000	James Landwehr, Sr. Chesapeake Appalachia, LLC	Chesapeake Appalachia, LLC SWN Production Company	18.000%	22/21 30/480
7)	3-B28F-29	Brian E. Johnson and Maranda S. Johnson	0.74	309/497		1-358053-000	Brian E. Johnson and Maranda S. Johnson Chesapeake Appalachia, LLC	Chesapeake Appalachia, LLC SWN Production Company	18.000%	22/93 30/480
8)	3-B28F-28	Timothy J. Stanley	1.05	309/303		1-358035-000	Timothy J. Stanley Chesapeake Appalachia, LLC	Chesapeake Appalachia, LLC SWN Production Company	18.000%	22/16 30/480
9)	3-B28F-38	Lena H. McCalmont	1.12	211/765		1-358969-000	Lena H. McCalmont Chesapeake Appalachia, LLC	Chesapeake Appalachia, LLC SWN Production Company	18.000%	22/256 30/480
10)	3-B28F-39	Lena H. McCalmont	0.36	211/765		1-357969-000	Lena H. McCalmont Chesapeake Appalachia, LLC	Chesapeake Appalachia, LLC SWN Production Company	18.000%	20/351 30/480
11)	3-B28F-40	Jeffrey R. Grooms and Denise M. Grooms	0.78	317/53		1-358037-000	Jeffrey R. Grooms and Denise M. Grooms Chesapeake Appalachia, LLC	Chesapeake Appalachia, LLC SWN Production Company	18.000%	21/360 30/480
12)	3-B28F-11	Heather L. Menning	1.87	284/106		1-358186-000	Heather L. Menning Chesapeake Appalachia, LLC	Chesapeake Appalachia, LLC SWN Production Company	18.000%	23/21 30/480
13)	3-B28F-5	John C. Schwartz and Patricia A. Schwartz	0.56	202/484		1-358111-000	John C. Schwartz and Patricia A. Schwartz Chesapeake Appalachia, LLC	Chesapeake Appalachia, LLC SWN Production Company	18.000%	22/353 30/480
14)	3-B28F-6	Cameron L. Puskarich and Karol A. Puskarich	0.63	281/402		1-358112-000	Cameron L. Puskarich and Karol A. Puskarich Chesapeake Appalachia, LLC	Chesapeake Appalachia, LLC SWN Production Company	18.000%	22/358 30/480
15)	3-B28F-7	Karol A. Puskarich f/k/a Karol A. Boettcher	0.63	211/471		1-358112-000	Cameron L. Puskarich and Karol A. Puskarich Chesapeake Appalachia, LLC	Chesapeake Appalachia, LLC SWN Production Company	18.000%	22/358 30/480
16)	3-B28F-8	John W. Mossgrove and Melody D. Mossgrove	0.30	269/548		1-357939-000	John W. Mossgrove and Melody D. Mossgrove Chesapeake Appalachia, LLC	Chesapeake Appalachia, LLC SWN Production Company	18.000%	21/117 30/480
17)	3-B28F-1	John W. Mossgrove and Melody D. Mossgrove	0.69	194/81		1-357939-000	John W. Mossgrove and Melody D. Mossgrove Chesapeake Appalachia, LLC	Chesapeake Appalachia, LLC SWN Production Company	18.000%	21/117 30/480
18)	3-B28B-31	Jeffrey W. Dorrance, Jr.	0.83	344/358	344/358	1-357993-000	Robert C. Sult, Jr. and M. Deanne Sult Chesapeake Appalachia, LLC	Chesapeake Appalachia, LLC SWN Production Company	18.000%	21/546 30/480
19)	3-B28B-32	Jeffrey W. Dorrance, Jr.	1.08	344/358	344/358	1-357993-000	Robert C. Sult, Jr. and M. Deanne Sult Chesapeake Appalachia, LLC	Chesapeake Appalachia, LLC SWN Production Company	18.000%	21/546 30/480
20)	3-B28B-34	Michael E. Cox and Dorothy M. Cox	0.70	264/744		1-358110-000	Michael E. Cox and Dorothy M. Cox Chesapeake Appalachia, LLC	Chesapeake Appalachia, LLC SWN Production Company	18.000%	22/348 30/480

21)	3-B28B-30	Marilyn Taylor	1.46	253/123	1-358226-000	Marilyn Taylor Chesapeake Appalachia, LLC	Chesapeake Appalachia, LLC SWN Production Company	18.000%	23/262 30/480	
22)	3-B28B-29	Marilyn Taylor	1.98	114/248	1-358226-000	Marilyn Taylor Chesapeake Appalachia, LLC	Chesapeake Appalachia, LLC SWN Production Company	18.000%	23/262 30/480	
23)	3-B28B-28	Richard H. Taylor	1.98	114/50	1-358225-000	Richard H. Taylor Chesapeake Appalachia, LLC	Chesapeake Appalachia, LLC SWN Production Company	18.000%	23/257 30/480	
24)	3-B28B-27	Dawn E. Gossard	1.78	327/265	1-358168-000	Dawn E. Homol, fka, Dawn E. Gossard and Paul S. Homol Chesapeake Appalachia, LLC	Chesapeake Appalachia, LLC SWN Production Company	18.000%	22/577 30/480	
25)	3-B28B-14	Corey P. Roman	23.06	214/416	47-003164-001	Corey P. Roman, aka, Corey Paul Roman and Donna M. Roman, aka, Donna Marie Roman Chesapeake Appalachia, LLC	Chesapeake Appalachia, LLC SWN Production Company	18.000%	26/292 30/480	
26)	3-B28B-15	Richard A. Champ and Cindy A. Champ	2.73	266/540	35/128	1-382494-001	Richard A. Champ and Cindy A. Champ Chesapeake Appalachia, LLC	Chesapeake Appalachia, LLC SWN Production Company	18.000%	25/779 30/480
						47-0000988-001	Joanne R. Dunkel and Donald K. Dunkel Chesapeake Appalachia, LLC	Chesapeake Appalachia, LLC SWN Production Company	16.000%	29/564 31/288
						47-0000988-003	William S. Bach Chesapeake Appalachia, LLC	Chesapeake Appalachia, LLC SWN Production Company	16.000%	30/296 31/288
						1-120143-001	Mollie Robison	SWN Production Company	16.000%	31/227
						1-120143-035	Virginia Matthews	SWN Production Company	16.000%	31/720
						1-120143-034	Susan Belle Schuchter	SWN Production Company	16.000%	31/775
						1-120143-032	Ian D. Dare	SWN Production Company	16.000%	31/739
						1-120143-031	James E. Dare	SWN Production Company	16.000%	31/757
						1-120143-033	Melinda Hill	SWN Production Company	16.000%	31/702
27)	3-B28B-2	William L. Conley	2.13	295/367	35/128	1-329267-001	William L. Conley Chesapeake Appalachia, LLC	Chesapeake Appalachia, LLC SWN Production Company	14.000%	13/79 30/480
						47-0000988-001	Joanne R. Dunkel and Donald K. Dunkel Chesapeake Appalachia, LLC	Chesapeake Appalachia, LLC SWN Production Company	16.000%	29/564 31/288
						47-0000988-003	William S. Bach Chesapeake Appalachia, LLC	Chesapeake Appalachia, LLC SWN Production Company	16.000%	30/296 31/288
						1-120143-001	Mollie Robison	SWN Production Company	16.000%	31/227
						1-120143-035	Virginia Matthews	SWN Production Company	16.000%	31/720
						1-120143-034	Susan Belle Schuchter	SWN Production Company	16.000%	31/775
						1-120143-032	Ian D. Dare	SWN Production Company	16.000%	31/739
						1-120143-031	James E. Dare	SWN Production Company	16.000%	31/757
						1-120143-033	Melinda Hill	SWN Production Company	16.000%	31/702

4700900170

FEB 7 2016
 WVDepartment of Environmental Protection
 Division of Oil and Gas
 JAN 15 2016

28)	3-B23P-27	Joe B. Henry and Geraldine L. Henry	4.30	219/657	35/128	1-329101-001	Joe B. Henry and Geraldine L. Henry Chesapeake Appalachia, LLC	Chesapeake Appalachia, LLC SWN Production Company	14.000%	13/616 30/480
						47-0000988-001	Joanne R. Dunkel and Donald K. Dunkel Chesapeake Appalachia, LLC	Chesapeake Appalachia, LLC SWN Production Company	16.000%	29/564 31/288
						47-0000988-003	William S. Bach Chesapeake Appalachia, LLC	Chesapeake Appalachia, LLC SWN Production Company	16.000%	30/296 31/288
						1-120143-001	Mollie Robison	SWN Production Company	16.000%	31/227
						1-120143-035	Virginia Matthews	SWN Production Company	16.000%	31/720
						1-120143-034	Susan Belle Schuchter	SWN Production Company	16.000%	31/775
						1-120143-032	Ian D. Dare	SWN Production Company	16.000%	31/739
						1-120143-031	James E. Dare	SWN Production Company	16.000%	31/757
						1-120143-033	Melinda Hill	SWN Production Company	16.000%	31/702
29)	3-B23P-5	Gerald L. Narigon, II and Pennie A. Narigon	2.25	281/129	35/128	1-120143-025	Gerald L. Narigon, II and Pennie A. Narigon	SWN Production Company	18.000%	31/558
						47-0000988-001	Joanne R. Dunkel and Donald K. Dunkel Chesapeake Appalachia, LLC	Chesapeake Appalachia, LLC SWN Production Company	16.000%	29/564 31/288
						47-0000988-003	William S. Bach Chesapeake Appalachia, LLC	Chesapeake Appalachia, LLC SWN Production Company	16.000%	30/296 31/288
						1-120143-001	Mollie Robison	SWN Production Company	16.000%	31/227
						1-120143-035	Virginia Matthews	SWN Production Company	16.000%	31/720
						1-120143-034	Susan Belle Schuchter	SWN Production Company	16.000%	31/775
						1-120143-032	Ian D. Dare	SWN Production Company	16.000%	31/739
						1-120143-031	James E. Dare	SWN Production Company	16.000%	31/757
						1-120143-033	Melinda Hill	SWN Production Company	16.000%	31/702
30)	3-B23P-9	Robert Lee Freshwater	2.92	252/343 WB 23/347	35/128	1-382559-001	Robert Lee Freshwater Chesapeake Appalachia, LLC	Chesapeake Appalachia, LLC SWN Production Company	18.000%	26/475 30/480
						47-0000988-001	Joanne R. Dunkel and Donald K. Dunkel Chesapeake Appalachia, LLC	Chesapeake Appalachia, LLC SWN Production Company	16.000%	29/564 31/288
						47-0000988-003	William S. Bach Chesapeake Appalachia, LLC	Chesapeake Appalachia, LLC SWN Production Company	16.000%	30/296 31/288
						1-120143-001	Mollie Robison	SWN Production Company	16.000%	31/227
						1-120143-035	Virginia Matthews	SWN Production Company	16.000%	31/720
						1-120143-034	Susan Belle Schuchter	SWN Production Company	16.000%	31/775
						1-120143-032	Ian D. Dare	SWN Production Company	16.000%	31/739
						1-120143-031	James E. Dare	SWN Production Company	16.000%	31/757
						1-120143-033	Melinda Hill	SWN Production Company	16.000%	31/702

RECEIVED
 FEB 17 2016
 OFFICE OF OIL AND GAS
 FEB 15 2016
 DEPARTMENT OF
 ENVIRONMENTAL
 QUALITY

470000001

SWN

Southwestern Energy®

PO Box 1300
Jane Lew, WV 26378
PHONE: (832) 796-1610

October 28, 2015

Ms. Laura Adkins
WV DEP Office of Oil & Gas
601 57th St., SE
Charleston, WV 25304

470090017


RE: SWN's proposed Russell Hervey BRK 201H & Russell Hervey BRK 1H in Brooke County, West Virginia, Drilling under Genteel Ridge Road & Washington Pike Road.

Dear Ms. Adkins:

SWN Production Company, LLC ("SWN") is applying for a drilling permit for the above referenced well. The State of West Virginia has raised some concern as to SWN's right to drill under Genteel Ridge Road & Washington Pike Road. Please be advised that SWN has leased all mineral owners under said route as it relates to the above-referenced well and unit.

Thank you.

Sincerely,

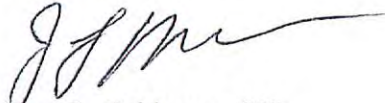

Jerry L. Bridgens, CPL
Staff Landman
SWN Production Company, LLC
PO Box 1300
Jane Lew, WV 26378

RECEIVED
Office of Oil and Gas
FEB 17 2016
WV Department of
Environmental Protection

$\frac{R^L}{A} \rightarrow V^+$

The Right People doing the Right Things,
wisely Investing the cash flow from
our underlying Assets, will create Value+

JAN 15 2016

WV Department of
Environmental Protection
04/08/2016

STATE OF WEST VIRGINIA
DEPARTMENT OF ENVIRONMENTAL PROTECTION, OFFICE OF OIL AND GAS
NOTICE CERTIFICATION

Date of Notice Certification 1/14/16

API No. 47- 69 - _____
Operator's Well No. Russell Hervey BRK 1H
Well Pad Name: Russell Hervey Pad

Notice has been given:

Pursuant to the provisions in West Virginia Code § 22-6A, the Operator has provided the required parties with the Notice Forms listed below for the tract of land as follows:

State: <u>WV</u>	UTM NAD 83 Easting: <u>537701.383</u>
County: <u>009-Brooke</u>	Northing: <u>4456505.809</u>
District: <u>1-Buffalo</u>	Public Road Access: <u>Pierce Run Road</u>
Quadrangle: <u>620- Steubenville East</u>	Generally used farm name: <u>Russell Hervey</u>
Watershed: <u>Buffalo Creek</u>	

Pursuant to West Virginia Code § 22-6A-7(b), every permit application filed under this section shall be on a form as may be prescribed by the secretary, shall be verified and shall contain the following information: (14) A certification from the operator that (i) it has provided the owners of the surface described in subdivisions (1), (2) and (4), subsection (b), section ten of this article, the information required by subsections (b) and (c), section sixteen of this article; (ii) that the requirement was deemed satisfied as a result of giving the surface owner notice of entry to survey pursuant to subsection (a), section ten of this article six-a; or (iii) the notice requirements of subsection (b), section sixteen of this article were waived in writing by the surface owner; and Pursuant to West Virginia Code § 22-6A-11(b), the applicant shall tender proof of and certify to the secretary that the notice requirements of section ten of this article have been completed by the applicant.

Pursuant to West Virginia Code § 22-6A, the Operator has attached proof to this Notice Certification that the Operator has properly served the required parties with the following:

<p>*PLEASE CHECK ALL THAT APPLY</p> <p><input type="checkbox"/> 1. NOTICE OF SEISMIC ACTIVITY or <input checked="" type="checkbox"/> NOTICE NOT REQUIRED BECAUSE NO SEISMIC ACTIVITY WAS CONDUCTED</p> <p><input type="checkbox"/> 2. NOTICE OF ENTRY FOR PLAT SURVEY or <input checked="" type="checkbox"/> NO PLAT SURVEY WAS CONDUCTED</p> <p><input checked="" type="checkbox"/> 3. NOTICE OF INTENT TO DRILL or <input type="checkbox"/> NOTICE NOT REQUIRED BECAUSE NOTICE OF ENTRY FOR PLAT SURVEY WAS CONDUCTED or</p> <p style="padding-left: 100px;"><input type="checkbox"/> WRITTEN WAIVER BY SURFACE OWNER (PLEASE ATTACH)</p> <p><input checked="" type="checkbox"/> 4. NOTICE OF PLANNED OPERATION</p> <p><input checked="" type="checkbox"/> 5. PUBLIC NOTICE</p> <p><input checked="" type="checkbox"/> 6. NOTICE OF APPLICATION</p>	<p>OOG OFFICE USE ONLY</p> <p><input type="checkbox"/> RECEIVED/ NOT REQUIRED</p> <p><input type="checkbox"/> RECEIVED</p> <p><input type="checkbox"/> RECEIVED/ NOT REQUIRED</p> <p><input type="checkbox"/> RECEIVED</p> <p><input type="checkbox"/> RECEIVED</p> <p><input type="checkbox"/> RECEIVED</p>
---	---

Required Attachments:

The Operator shall attach to this Notice Certification Form all Notice Forms and Certifications of Notice that have been provided to the required parties and/or any associated written waivers. For the Public Notice, the operator shall attach a copy of the Class II Legal Advertisement with publication date verification or the associated Affidavit of Publication. The attached Notice Forms and Certifications of Notice shall serve as proof that the required parties have been noticed as required under West Virginia Code § 22-6A. Pursuant to West Virginia Code § 22-6A-11(b), the Certification of Notice to the person may be made by affidavit of personal service, the return receipt card or other postal receipt for certified mailing.


RECEIVED
Office of Oil and Gas
FEB 17 2016
WV Department of
Environmental Protection

RECEIVED
Office of Oil and Gas
FEB 15 2016
WV Department of
Environmental Protection

Certification of Notice is hereby given:

THEREFORE, I _____, have read and understand the notice requirements within West Virginia Code § 22-6A. I certify that as required under West Virginia Code § 22-6A, I have served the attached copies of the Notice Forms, identified above, to the required parties through personal service, by registered mail or by any method of delivery that requires a receipt or signature confirmation. I certify under penalty of law that I have personally examined and am familiar with the information submitted in this Notice Certification and all attachments, and that based on my inquiry of those individuals immediately responsible for obtaining the information, I believe that the information is true, accurate and complete. I am aware that there are significant penalties for submitting false information, including the possibility of fine and imprisonment.

Well Operator:	<u>SWN Production Co., LLC</u>	Address:	<u>P.O. Box 1300</u>
By:	<u>Dee Southall</u>		<u>Jane Lew, WV 26378</u>
Its:	<u>Regulatory Supervisor</u>	Pacsimile:	<u>304-471-2497</u>
Telephone:	<u>304-884-1610</u>	Email:	<u>Dee_Southall@swn.com</u>

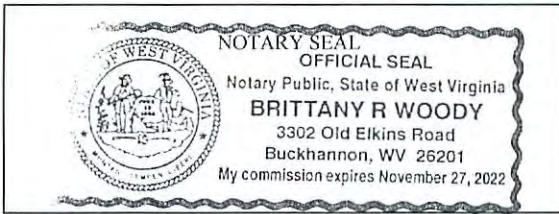

Subscribed and sworn before me this 22nd day of June 2015.
Brittany R Woody Notary Public
 My Commission Expires 11/27/2022

Oil and Gas Privacy Notice:

The Office of Oil and Gas processes your personal information, such as name, address and telephone number, as part of our regulatory duties. Your personal information may be disclosed to other State agencies or third parties in the normal course of business or as needed to comply with statutory or regulatory requirements, including Freedom of Information Act requests. Our office will appropriately secure your personal information. If you have any questions about our use or your personal information, please contact DEP's Chief Privacy Officer at depprivacyofficer@wv.gov.

4700900170

RECEIVED
Office of Oil and Gas
FEB 17 2016
WV Department of
Environmental Protection

RECEIVED
Office of Oil and Gas
JAN 15 2016
WV Department of
Environmental Protection

04/08/2016

STATE OF WEST VIRGINIA
DEPARTMENT OF ENVIRONMENTAL PROTECTION, OFFICE OF OIL AND GAS
NOTICE OF APPLICATION

Notice Time Requirement: notice shall be provided no later than the filing date of permit application.

Date of Notice 1/14/16 Permit Application Filed: 1/14/16
Notice of:

- PERMIT FOR ANY WELL WORK CERTIFICATE OF APPROVAL FOR THE CONSTRUCTION OF AN IMPOUNDMENT OR PIT

Delivery method pursuant to West Virginia Code § 22-6A-10(b)

- PERSONAL SERVICE REGISTERED MAIL METHOD OF DELIVERY THAT REQUIRES A RECEIPT OR SIGNATURE CONFIRMATION

Pursuant to W. Va. Code § 22-6A-10(b) no later than the filing date of the application, the applicant for a permit for any well work or for a certificate of approval for the construction of an impoundment or pit as required by this article shall deliver, by personal service or by registered mail or by any method of delivery that requires a receipt or signature confirmation, copies of the application, the erosion and sediment control plan required by section seven of this article, and the well plat to each of the following persons: (1) The owners of record of the surface of the tract on which the well is or is proposed to be located; (2) The owners of record of the surface tract or tracts overlying the oil and gas leasehold being developed by the proposed well work, if the surface tract is to be used for roads or other land disturbance as described in the erosion and sediment control plan submitted pursuant to subsection (c), section seven of this article; (3) The coal owner, operator or lessee, in the event the tract of land on which the well proposed to be drilled is located [sic] is known to be underlain by one or more coal seams; (4) The owners of record of the surface tract or tracts overlying the oil and gas leasehold being developed by the proposed well work, if the surface tract is to be used for the placement, construction, enlargement, alteration, repair, removal or abandonment of any impoundment or pit as described in section nine of this article; (5) Any surface owner or water purveyor who is known to the applicant to have a water well, spring or water supply source located within one thousand five hundred feet of the center of the well pad which is used to provide water for consumption by humans or domestic animals; and (6) The operator of any natural gas storage field within which the proposed well work activity is to take place. (c)(1) If more than three tenants in common or other co-owners of interests described in subsection (b) of this section hold interests in the lands, the applicant may serve the documents required upon the person described in the records of the sheriff required to be maintained pursuant to section eight, article one, chapter eleven-a of this code. (2) Notwithstanding any provision of this article to the contrary, notice to a lien holder is not notice to a landowner, unless the lien holder is the landowner. W. Va. Code R. § 35-8-5.7.a requires, in part, that the operator shall also provide the Well Site Safety Plan ("WSSP") to the surface owner and any water purveyor or surface owner subject to notice and water testing as provided in section 15 of this rule.

Application Notice WSSP Notice E&S Plan Notice Well Plat Notice is hereby provided to:

SURFACE OWNER(s) ✓
Name: Fredrick & Cathy Jo Hervey
Address: 100 Fernwood Dr
Wellsburg, WV 26070

Name: William Hervey III ✓
Address: 1030 Washington Pike
Wellsburg, WV 26070

SURFACE OWNER(s) (Road and/or Other Disturbance)
Name: _____
Address: _____

Name: _____
Address: _____

SURFACE OWNER(s) (Impoundments or Pits)
Name: _____
Address: _____

COAL OWNER OR LESSEE
Name: _____
Address: _____

COAL OPERATOR
Name: _____
Address: _____

SURFACE OWNER OF WATER WELL AND/OR WATER PURVEYOR(s) ✓
Name: Michael Whitco & Patricia Graham
Address: 105 Churchman Lane
Wellsburg, WV 26070

OPERATOR OF ANY NATURAL GAS STORAGE FIELD
Name: _____
Address: _____

*Please attach additional forms if necessary

WV Department of Environmental Protection

04/08/2016

4700900178

RECEIVED
Office of Oil and Gas

FEB 17 2016

WV Department of Environmental Protection
Office of Oil and Gas

JAN 15 2016

STATE OF WEST VIRGINIA
DEPARTMENT OF ENVIRONMENTAL PROTECTION, OFFICE OF OIL AND GAS
NOTICE OF APPLICATION

Notice Time Requirement: notice shall be provided no later than the **filing date of permit application.**

Date of Notice 1/14/16 Late Permit Application Filed. 1/14/16

Notice of:

- PERMIT FOR ANY WELL WORK
- CERTIFICATE OF APPROVAL FOR THE CONSTRUCTION OF AN IMPOUNDMENT OR PIT

Delivery method pursuant to West Virginia Code § 22-6A-10(b)

- PERSONAL SERVICE
- REGISTERED MAIL
- METHOD OF DELIVERY THAT REQUIRES A RECEIPT OR SIGNATURE CONFIRMATION

Pursuant to W. Va. Code § 22-6A-10(b) no later than the filing date of the application, the applicant for a permit for any well work or for a certificate of approval for the construction of an impoundment or pit as required by this article shall deliver, by personal service or by registered mail or by any method of delivery that requires a receipt or signature confirmation, copies of the application, the erosion and sediment control plan required by section seven of this article, and the well plat to each of the following persons: (1) The owners of record of the surface of the tract on which the well is or is proposed to be located; (2) The owners of record of the surface tract or tracts overlying the oil and gas leasehold being developed by the proposed well work, if the surface tract is to be used for roads or other land disturbance as described in the erosion and sediment control plan submitted pursuant to subsection (c), section seven of this article; (3) The coal owner, operator or lessee, in the event the tract of land on which the well proposed to be drilled is located [sic] is known to be underlain by one or more coal seams; (4) The owners of record of the surface tract or tracts overlying the oil and gas leasehold being developed by the proposed well work, if the surface tract is to be used for the placement, construction, enlargement, alteration, repair, removal or abandonment of any impoundment or pit as described in section nine of this article; (5) Any surface owner or water purveyor who is known to the applicant to have a water well, spring or water supply source located within one thousand five hundred feet of the center of the well pad which is used to provide water for consumption by humans or domestic animals; and (6) The operator of any natural gas storage field within which the proposed well work activity is to take place. (c)(1) If more than three tenants in common or other co-owners of interests described in subsection (b) of this section hold interests in the lands, the applicant may serve the documents required upon the person described in the records of the sheriff required to be maintained pursuant to section eight, article one, chapter eleven-a of this code. (2) Notwithstanding any provision of this article to the contrary, notice to a lien holder is not notice to a landowner, unless the lien holder is the landowner. W. Va. Code R. § 35-8-5.7.a requires, in part, that the operator shall also provide the Well Site Safety Plan ("WSSP") to the surface owner and any water purveyor or surface owner subject to notice and water testing as provided in section 15 of this rule.

Application Notice WSSP Notice E&S Plan Notice Well Plat Notice is hereby provided to:

SURFACE OWNER(s) ✓
 Name: Russell D. Hervey
 Address: 200 Carol Street
Wellsburg, WV 26070

Name: Robert & Ellen Stanley ✓
 Address: 201 Genteel Road
Wellsburg, WV 26070

SURFACE OWNER(s) (Road and/or Other Disturbance)
 Name: _____
 Address: _____
 Name: _____
 Address: _____

SURFACE OWNER(s) (Impoundments or Pits)
 Name: _____
 Address: _____

COAL OWNER OR LESSEE ✓
 Name: Starvaggi Industries, INC.
 Address: 401 Pennsylvania Ave
Weirton, WV 26062

COAL OPERATOR
 Name: _____
 Address: _____

SURFACE OWNER OF WATER WELL AND/OR WATER PURVEYOR(s) ✓
 Name: William Hervey
 Address: 1030 Washington Pike
Wellsburg, WV 26070

OPERATOR OF ANY NATURAL GAS STORAGE FIELD
 Name: _____
 Address: _____

*Please attach additional forms if necessary

RECEIVED
Office of Oil and Gas
FEB 17 2016
WV Department of Environmental Protection

Notice is hereby given:

Pursuant to West Virginia Code § 22-6A-10(b), notice is hereby given that the undersigned well operator has applied for a permit for well work or for a certificate of approval for the construction of an impoundment or pit.

This Notice Shall Include:

Pursuant to W. Va. Code § 22-6A-10(b), this notice shall include: (1) copies of the application; (2) the erosion and sediment control plan required by section seven of this article; and (3) the well plat.

Pursuant to W. Va. Code § 22-6A-10(f), this notice shall include: (1) a statement of the time limits for filing written comments; (2) who may file written comments; (3) the name and address of the secretary for the purpose of filing the comments and obtaining additional information; and (4) a statement that the persons may request, at the time of submitting written comments, notice of the permit decision and a list of persons qualified to test water.

Pursuant to W. Va. Code R. § 35-8-5.7.a, the operator shall provide the Well Site Safety Plan to the surface owner and any water purveyor or surface owner subject to notice and water testing as provided in section 15 of this rule.

Pursuant to W. Va. Code R. § 35-8-15.2.c, this notice shall: (1) contain a statement of the surface owner's and water purveyor's right to request sampling and analysis; (2) advise the surface owner and water purveyor of the rebuttable presumption for contamination or deprivation of a fresh water source or supply; advise the surface owner and water purveyor that refusal to allow the operator to conduct a pre-drilling water well test constitutes a method to rebut the presumption of liability; (3) advise the surface owner and water purveyor of his or her independent right to sample and analyze any water supply at his or her own expense; advise the surface owner and water purveyor whether or not the operator will utilize an independent laboratory to analyze any sample; and (4) advise the surface owner and or water purveyor that he or she can obtain from the Chief a list of water testing laboratories in the subject area capable of and qualified to test water supplies in accordance with standard acceptable methods.

Additional information related to horizontal drilling may be obtained from the Secretary, at the WV Department of Environmental Protection headquarters, located at 601 57th Street, SE, Charleston, WV 25304 (304-926-0450) or by visiting www.dep.wv.gov/oil-and-gas/pages/default.aspx.

Well Location Restrictions

Pursuant to W. Va. Code § 22-6A-12, Wells may not be drilled within two hundred fifty feet measured horizontally from any existing water well or developed spring used for human or domestic animal consumption. The center of well pads may not be located within six hundred twenty-five feet of an occupied dwelling structure, or a building two thousand five hundred square feet or larger used to house or shelter dairy cattle or poultry husbandry. This limitation is applicable to those wells, developed springs, dwellings or agricultural buildings that existed on the date a notice to the surface owner of planned entry for surveying or staking as provided in section ten of this article or a notice of intent to drill a horizontal well as provided in subsection (b), section sixteen of this article was provided, whichever occurs first, and to any dwelling under construction prior to that date. This limitation may be waived by written consent of the surface owner transmitted to the department and recorded in the real property records maintained by the clerk of the county commission for the county in which such property is located. Furthermore, the well operator may be granted a variance by the secretary from these distance restrictions upon submission of a plan which identifies the sufficient measures, facilities or practices to be employed during well site construction, drilling and operations. The variance, if granted, shall include terms and conditions the department requires to ensure the safety and protection of affected persons and property. The terms and conditions may include insurance, bonding and indemnification, as well as technical requirements. (b) No well pad may be prepared or well drilled within one hundred feet measured horizontally from any perennial stream, natural or artificial lake, pond or reservoir, or a wetland, or within three hundred feet of a naturally reproducing trout stream. No well pad may be located within one thousand feet of a surface or ground water intake of a public water supply. The distance from the public water supply as identified by the department shall be measured as follows: (1) For a surface water intake on a lake or reservoir, the distance shall be measured from the boundary of the lake or reservoir. (2) For a surface water intake on a flowing stream, the distance shall be measured from a semicircular radius extending upstream of the surface water intake. (3) For a groundwater source, the distance shall be measured from the wellhead or spring. The department may, in its discretion, waive these distance restrictions upon submission of a plan identifying sufficient measures, facilities or practices to be employed during well site construction, drilling and operations to protect the waters of the state. A waiver, if granted, shall impose any permit conditions as the secretary considers necessary. (c) Notwithstanding the foregoing provisions of this section, nothing contained in this section prevents an operator from conducting the activities permitted or authorized by a Clean Water Act Section 404 permit or other approval from the United States Army Corps of Engineers within any waters of the state or within the restricted areas referenced in this section. (d) The well location restrictions set forth in this section shall not apply to any well on a multiple well pad if at least one of the wells was permitted prior to the effective date of this article. (e) The secretary shall, by December 31, 2012, report to the Legislature on the noise, light, dust and volatile organic compounds generated by the drilling of horizontal wells as they relate to the well location restrictions regarding occupied dwelling structures pursuant to this section. Upon a finding, if any, by the secretary that the well location restrictions regarding occupied dwelling structures are inadequate or otherwise require alteration to address the items

4700900178

examined in the study required by this subsection, the secretary shall have the authority to propose for promulgation legislative rules establishing guidelines and procedures regarding reasonable levels of noise, light, dust and volatile organic compounds relating to drilling horizontal wells, including reasonable means of mitigating such factors, if necessary.

Water Well Testing:

Pursuant to West Virginia Code § 22-6A-10(d), notification shall be made, with respect to surface landowners identified in subsection (b) or water purveyors identified in subdivision (5), subsection (b) of this section, of the opportunity for testing their water well. The operator shall provide an analysis to such surface landowner or water purveyor at their request.

Water Testing Laboratories:

Pursuant to West Virginia Code § 22-6A-10(i), persons entitled to notice pursuant to subsection (b) of this section may contact the department to ascertain the names and locations of water testing laboratories in the subject area capable and qualified to test water supplies in accordance with standard accepted methods. In compiling that list of names the department shall consult with the state Bureau for Public Health and local health departments. A surface owner and water purveyor has an independent right to sample and analyze any water supply at his or her own expense. The laboratory utilized by the operator shall be approved by the agency as being certified and capable of performing sample analyses in accordance with this section.

Rebuttable Presumption for Contamination or Deprivation of a Fresh Water Source or Supply:

W. Va. Code § 22-6A-18 requires that (b) unless rebutted by one of the defenses established in subsection (c) of this section, in any action for contamination or deprivation of a fresh water source or supply within one thousand five hundred feet of the center of the well pad for horizontal well, there is a rebuttable presumption that the drilling and the oil or gas well or either was the proximate cause of the contamination or deprivation of the fresh water source or supply. (c) In order to rebut the presumption of liability established in subsection (b) of this section, the operator must prove by a preponderance of the evidence one of the following defenses: (1) The pollution existed prior to the drilling or alteration activity as determined by a predrilling or prealteration water well test. (2) The landowner or water purveyor refused to allow the operator access to the property to conduct a predrilling or prealteration water well test. (3) The water supply is not within one thousand five hundred feet of the well. (4) The pollution occurred more than six months after completion of drilling or alteration activities. (5) The pollution occurred as the result of some cause other than the drilling or alteration activity. (d) Any operator electing to preserve its defenses under subdivision (1), subsection (c) of this section shall retain the services of an independent certified laboratory to conduct the predrilling or prealteration water well test. A copy of the results of the test shall be submitted to the department and the surface owner or water purveyor in a manner prescribed by the secretary. (e) Any operator shall replace the water supply of an owner of interest in real property who obtains all or part of that owner's supply of water for domestic, agricultural, industrial or other legitimate use from an underground or surface source with a comparable water supply where the secretary determines that the water supply has been affected by contamination, diminution or interruption proximately caused by the oil or gas operation, unless waived in writing by that owner. (f) The secretary may order the operator conducting the oil or gas operation to: (1) Provide an emergency drinking water supply within twenty-four hours; (2) Provide temporary water supply within seventy-two hours; (3) Within thirty days begin activities to establish a permanent water supply or submit a proposal to the secretary outlining the measures and timetables to be used in establishing a permanent supply. The total time in providing a permanent water supply may not exceed two years. If the operator demonstrates that providing a permanent replacement water supply cannot be completed within two years, the secretary may extend the time frame on case-by-case basis; and (4) Pay all reasonable costs incurred by the real property owner in securing a water supply. (g) A person as described in subsection (b) of this section aggrieved under the provisions of subsections (b), (e) or (f) of this section may seek relief in court... (i) Notwithstanding the denial of the operator of responsibility for the damage to the real property owner's water supply or the status of any appeal on determination of liability for the damage to the real property owner's water supply, the operator may not discontinue providing the required water service until authorized to do so by the secretary or a court of competent jurisdiction.

4700900178

Written Comment:

Pursuant to West Virginia Code § 22-6A-11(a), all persons described in subsection (b), section 11 of this article may file written comments with the secretary as to the location or construction of the applicant's proposed well work within thirty days after the application is filed with the secretary. All persons described in West Virginia Code § 22-6A-10(b) may file written comments as to the location or construction of the applicant's proposed well work to the Secretary at:

Chief, Office of Oil and Gas
Department of Environmental Protection
601 57th St. SE
Charleston, WV 25304
(304) 926-0450

RECEIVED
Office of Oil and Gas
JAN 14 2016
WV Department of
Environmental Protection
Office of Oil and Gas

Such persons may request, at the time of submitting written comments, notice of the permit decision and a list of persons qualified to test water. **NOTE: YOU ARE NOT REQUIRED TO FILE ANY COMMENT.**

JAN 15 2016
WV Department of
Environmental Protection
04/08/2016

Time Limits and Methods for Filing Comments.

The law requires these materials to be served on or before the date the operator files its Application. You have **THIRTY (30) DAYS** after the filing date to file your comments. Comments must be filed in person or received in the mail by the Chief's office by the time stated above. You may call the Chief's office to be sure of the date. Check with your postmaster to ensure adequate delivery time or to arrange special expedited handling. If you have been contacted by the well operator and you have signed a "voluntary statement of no objection" to the planned work described in these materials, then the permit may be issued at any time.

Pursuant to West Virginia Code § 22-6A-11(c)(2), Any objections of the affected coal operators and coal seam owners and lessees shall be addressed through the processes and procedures that exist under sections fifteen, seventeen and forty, article six of this chapter, as applicable and as incorporated into this article by section five of this article. The written comments filed by the parties entitled to notice under subdivisions (1), (2), (4), (5) and (6), subsection (b), section ten of this article shall be considered by the secretary in the permit issuance process, but the parties are not entitled to participate in the processes and proceedings that exist under sections fifteen, seventeen or forty, article six of this chapter, as applicable and as incorporated into this article by section five of this article.

4700900178

Comment Requirements

Your comments must be in writing and include your name, address and telephone number, the well operator's name and well number and the approximate location of the proposed well site including district and county from the application. You may add other documents, such as sketches, maps or photographs to support your comments.

Disclaimer: All comments received will be placed on our web site <http://www.dep.wv.gov/oil-and-gas/Horizontal-Permits/Pages/default.aspx> and the applicant will automatically be forwarded an email notice that such comments have been submitted. The applicant will be expected to provide a response to comments submitted by any surface owner, water purveyor or natural gas storage operator noticed within the application.

Permit Denial or Condition

The Chief has the power to deny or condition a well work permit. Pursuant to West Virginia Code § 22-6A-8(d), the permit may not be issued or be conditioned, including conditions with respect to the location of the well and access roads prior to issuance if the director determines that:

- (1) The proposed well work will constitute a hazard to the safety of persons;
- (2) The plan for soil erosion and sediment control is not adequate or effective;
- (3) Damage would occur to publicly owned lands or resources; or
- (4) The proposed well work fails to protect fresh water sources or supplies.

A permit may also be denied under West Virginia Code § 22-6A-7(k), the secretary shall deny the issuance of a permit if the secretary determines that the applicant has committed a substantial violation of a previously issued permit for a horizontal well, including the applicable erosion and sediment control plan associated with the previously issued permit, or a substantial violation of one or more of the rules promulgated under this article, and in each instance has failed to abate or seek review of the violation within the time prescribed by the secretary pursuant to the provisions of subdivisions (1) and (2), subsection (a), section five of this article and the rules promulgated hereunder, which time may not be unreasonable.

Pursuant to West Virginia Code § 22-6A-10(g), any person entitled to submit written comments to the secretary pursuant to subsection (a), section eleven of this article, shall also be entitled to receive from the secretary a copy of the permit as issued or a copy of the order modifying or denying the permit if the person requests receipt of them as a part of the written comments submitted concerning the permit application. Such persons may request, at the time of submitting written comments, notice of the permit decision and a list of persons qualified to test water.

RECEIVED
Office of Oil and Gas

JAN 15 2016

WV Department of
Environmental Protection

04/08/2016

WW-6A
(8-13)

API NO. 47- 69 -
OPERATOR WELL NO. Russell Hervey BRK 1H
Well Pad Name: Russell Hervey Pad

Notice is hereby given by:


Well Operator: SWN Production Co., LLC
Telephone: 304-884-1610
Email: Dee_Southall@swn.com



Address: P.O. Box 1300
Jane Lew, WV 26378
Facsimile: 304-471-2497

Oil and Gas Privacy Notice:

The Office of Oil and Gas processes your personal information, such as name, address and telephone number, as part of our regulatory duties. Your personal information may be disclosed to other State agencies or third parties in the normal course of business or as needed to comply with statutory or regulatory requirements, including Freedom of Information Act requests. Our office will appropriately secure your personal information. If you have any questions about our use or your personal information, please contact DEP's Chief Privacy Officer at depprivacyofficer@wv.gov.

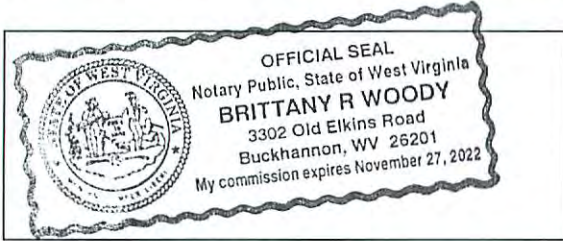

Subscribed and sworn before me this 22nd day of June 2015.
Brittany R Woody Notary Public
My Commission Expires 11/27/22

4700900170

RECEIVED
Office of Oil and Gas
FEB 17 2016

RECEIVED
Office of Oil and Gas
WV Department of Environmental Protection
JAN 15 2016

WV Department of Environmental Protection
04/08/2016

STATE OF WEST VIRGINIA
DEPARTMENT OF ENVIRONMENTAL PROTECTION, OFFICE OF OIL AND GAS
NOTICE OF INTENT TO DRILL

Pursuant to W. Va. Code § 22-6A-16(b), the Notice of Intent to Drill is only required if the notice requirements of W. Va. Code § 22-6A-10(a) have NOT been met or if the Notice of Intent to Drill requirement has NOT been waived in writing by the surface owner.

Notice Time Requirement: Notice shall be provided at least TEN (10) days prior to filing a permit application.

Date of Notice: 01/27/2016 **Date Permit Application Filed:** 2/16/16

Delivery method pursuant to West Virginia Code § 22-6A-16(b)

HAND DELIVERY CERTIFIED MAIL RETURN RECEIPT REQUESTED

4700900770

Pursuant to W. Va. Code § 22-6A-16(b), at least ten days prior to filing a permit application, an operator shall, by certified mail return receipt requested or hand delivery, give the surface owner notice of its intent to enter upon the surface owner's land for the purpose of drilling a horizontal well: *Provided*, That notice given pursuant to subsection (a), section ten of this article satisfies the requirements of this subsection as of the date the notice was provided to the surface owner: *Provided, however*, That the notice requirements of this subsection may be waived in writing by the surface owner. The notice, if required, shall include the name, address, telephone number, and if available, facsimile number and electronic mail address of the operator and the operator's authorized representative.

Notice is hereby provided to the SURFACE OWNER(s):

Name: Russell D Hervey
Address: 200 Carol Rd
Wellsburg, WV 26070

Name: _____
Address: _____

Notice is hereby given:

Pursuant to West Virginia Code § 22-6A-16(b), notice is hereby given that the undersigned well operator has an intent to enter upon the surface owner's land for the purpose of drilling a horizontal well on the tract of land as follows:

State: <u>West Virginia</u>	UTM NAD 83	Easting: <u>537,701.383</u>
County: <u>Brooke</u>		Northing: <u>4,456,505.809</u>
District: <u>Buffalo</u>	Public Road Access: <u>Pierce Run Rd</u>	
Quadrangle: <u>Steubenville East</u>	Generally used farm name: _____	
Watershed: <u>Buffalo Creek</u>		

This Notice Shall Include:

Pursuant to West Virginia Code § 22-6A-16(b), this notice shall include the name, address, telephone number, and if available, facsimile number and electronic mail address of the operator and the operator's authorized representative. Additional information related to horizontal drilling may be obtained from the Secretary, at the WV Department of Environmental Protection headquarters, located at 601 57th Street, SE, Charleston, WV 25304 (304-926-0450) or by visiting www.dep.wv.gov/oil-and-gas/pages/default.aspx.

Notice is hereby given by:

Well Operator: SWN Production Company, LLC
Address: PO Box 1300, 179 Innovation Drive
Jane Lew, WV 26378
Telephone: 304-884-1615
Email: Steve_Perkins@swn.com
Facsimile: _____

Authorized Representative: Danielle Southall
Address: PO Box 1300, 179 Innovation Drive
Jane Lew, WV 26378
Telephone: 304-884-1614
Email: Danielle_Southall@swn.com
Facsimile: _____

RECEIVED
Oil and Gas
FEB 17 2016
WV Department of
Environmental Protection

Oil and Gas Privacy Notice:

The Office of Oil and Gas processes your personal information, such as name, address and telephone number, as part of our regulatory duties. Your personal information may be disclosed to other State agencies or third parties in the normal course of business or as needed to comply with statutory or regulatory requirements, including Freedom of Information Act requests. Our office will appropriately secure your personal information. If you have any questions about our use or your personal information, please contact DEP's Chief Privacy Officer at depprivacyofficer@wv.gov.

STATE OF WEST VIRGINIA
DEPARTMENT OF ENVIRONMENTAL PROTECTION, OFFICE OF OIL AND GAS
NOTICE OF PLANNED OPERATION

Notice Time Requirement: notice shall be provided no later than the **filing date of permit application.**

Date of Notice: 01/27/2016 **Date Permit Application Filed:** 2/11/16

Delivery method pursuant to West Virginia Code § 22-6A-16(c)

CERTIFIED MAIL **HAND**
RETURN RECEIPT REQUESTED **DELIVERY**

Pursuant to W. Va. Code § 22-6A-16(c), no later than the date for filing the permit application, an operator shall, by certified mail return receipt requested or hand delivery, give the surface owner whose land will be used for the drilling of a horizontal well notice of the planned operation. The notice required by this subsection shall include: (1) A copy of this code section; (2) The information required to be provided by subsection (b), section ten of this article to a surface owner whose land will be used in conjunction with the drilling of a horizontal well; and (3) A proposed surface use and compensation agreement containing an offer of compensation for damages to the surface affected by oil and gas operations to the extent the damages are compensable under article six-b of this chapter. (d) The notices required by this section shall be given to the surface owner at the address listed in the records of the sheriff at the time of notice.

Notice is hereby provided to the SURFACE OWNER(s)
(at the address listed in the records of the sheriff at the time of notice):

Name: Russell D Hervey ✓ Name: _____
Address: 200 Carol Rd Address: _____
Wellsburg, WV 26070 _____

Notice is hereby given:

Pursuant to West Virginia Code § 22-6A-16(c), notice is hereby given that the undersigned well operator has developed a planned operation on the surface owner's land for the purpose of drilling a horizontal well on the tract of land as follows:

State:	<u>West Virginia</u>	UTM NAD 83	Easting:	<u>537,701.383</u>
County:	<u>Brooke</u>		Northing:	<u>4,456,505.809</u>
District:	<u>Buffalo</u>	Public Road Access:		<u>Pierce Run Rd</u>
Quadrangle:	<u>Steubenville East</u>	Generally used farm name:		_____
Watershed:	<u>Buffalo Creek</u>			

This Notice Shall Include:

Pursuant to West Virginia Code § 22-6A-16(c), this notice shall include: (1) A copy of this code section; (2) The information required to be provided by **W. Va. Code § 22-6A-10(b)** to a surface owner whose land will be used in conjunction with the drilling of a horizontal well; and (3) A proposed surface use and compensation agreement containing an offer of compensation for damages to the surface affected by oil and gas operations to the extent the damages are compensable under article six-b of this chapter. Additional information related to horizontal drilling may be obtained from the Secretary, at the WV Department of Environmental Protection headquarters, located at 601 57th Street, SE, Charleston, WV 25304 (304-926-0450) or by visiting www.dep.wv.gov/oil-and-gas/pages/default.aspx.

Well Operator:	<u>SWN Production Company, LLC</u>	Address:	<u>PO Box 1300, 179 Innovation Drive</u>
Telephone:	<u>304-884-1615</u>		<u>Jane Lew, WV 26378</u>
Email:	<u>Steve_Perkins@swn.com</u>	Facsimile:	<u>304-472-4225</u>

Oil and Gas Privacy Notice:

The Office of Oil and Gas processes your personal information, such as name, address and telephone number, as part of our regulatory duties. Your personal information may be disclosed to other State agencies or third parties in the normal course of business or as needed to comply with statutory or regulatory requirements, including Freedom of Information Act requests. Our office will appropriately secure your personal information. If you have any questions about our use of your personal information, please contact DEP's Chief Privacy Officer at depprivacyofficer@wv.gov.

Office of Oil and Gas
FEB 17 2016
WV Department of
Environmental Protection

04/08/2016



WEST VIRGINIA DEPARTMENT OF TRANSPORTATION

Division of Highways

1900 Kanawha Boulevard East • Building Five • Room 110
Charleston, West Virginia 25305-0430 • (304) 558-3505

Earl Ray Tomblin
Governor

Paul A. Mattox, Jr., P. E.
Secretary of Transportation/
Commissioner of Highways

April 14, 2015

James A. Martin, Chief
Office of Oil and Gas
Department of Environmental Protection
601 57th Street, SE
Charleston, WV 25304

Subject: DOH Permit for the Russell Hervey Pad, Brooke County

Russell Hervey BRK 1H Russell Hervey BRK 3H Russell Hervey BRK 6H
Russell Hervey BRK 10H Russell Hervey BRK 201H Russell Hervey BRK 206H

Dear Mr. Martin,

The West Virginia Division of Highways has transferred Permit #06-2012-0308 for the subject site to Southwestern Energy for access to the State Road for the well site located off of Brooke County Route 27/4 SLS.

The operator has signed an OIL AND GAS ROAD MAINTENANCE BONDING AGREEMENT and provided the required Bond. This operator is currently in compliance with the DOH OIL AND GAS POLICY dated January 3, 2012.

Very Truly Yours,

Gary K. Clayton, P.E.
Regional Maintenance Engineer
Central Office Oil & Gas Coordinator

Cc: Dee Southhall
Southwestern Energy
CH, OM, D-6
File

RECEIVED
Office of Oil and Gas

FEB 17 2016 5 2016

WV Department of
Environmental Protection

04/08/2016

Supplier Name	Product Name	Product Use	Chemical Name	CAS Number
NALCO ONESOURCE	EC6110A	Biocide	Ethanol	000064-17-5
			Glutaraldehyde (Pentanediol)	000111-30-8
			Quaternary Ammonium Compounds	N/A-063
	EC6629A	Biocide	No Hazardous Components	NONE
WEATHERFORD	WBK-133 OXIDIZER	Breaker	Ammonium Persulfate	007727-54-0
	WBK-134	Breaker	Ammonium Persulfate	007727-54-0
			Crystalline Silica (Quartz Sand, Silicon Dioxide)	014808-60-7
	WCS-631LC	Clay Stabilizer	Proprietary Non Hazardous Salt	N/A-229
			Water	007732-18-5
	WFR-55LA	Friction Reducer	No Hazardous Components	NONE
	WGA-15L	Gel	Petroleum Distillate Hydrotreated Light	064742-47-8
	WPB-584-L	Buffer	Potassium Carbonate	000584-08-7
			Potassium Hydroxide	001310-58-3
	WXL-101LE	Crosslinker	No Hazardous Components	NONE
	WXL-101LM	Crosslinker	Petroleum Distillate Hydrotreated Light	064742-47-8
	WXL-105L	Crosslinker	Water	007732-18-5
			Ethylene Glycol	000107-21-1
			Boric Acid	010043-35-3
Ethanolamine			000141-43-5	
SCHLUMBERGER	B244 Green-Cide 25G	Biocide	Glutaraldehyde	111-30-8
	L071 Temporary Clay Stabilizer	Clay Stabilizer	Cholinium Chloride	67-48-1
	Breaker J218	Breaker	Diammonium Peroxidisulphate	7727-54-0
	EB-Clean* J475 Breaker		Diammonium Peroxidisulphate	7727-54-0
	Friction Reducer B315	Friction Reducer	Distillates (petroleum), Hydrotreated light Aliphatic Alcohol Glycol Ether	64742-47-8 Proprietary
	Friction Reducer J609		Ammonium Sulfate	7783-20-2

RECEIVED
Office of Oil and Gas

JAN 15 2016
FEB 17 2016

WV Department of
Environmental Protection
04/08/2016

Supplier Name	Product Name	Product Use	Chemical Name	CAS Number
SCHLUMBERGER	Water Gelling Agent J580	Gel	Carbohydrate Polymer	Proprietary
	Scale Inhibitor B317	Scale Inhibitor	Trisodium ortho phosphate Ethane-1, 2-diol	7601-54-9 107-21-1
	Borate Crosslinker J532	Crosslinker	Aliphatic polyol Sodium tetraborate decahydrate	Proprietary 1303 96-4
	Crosslinker J610		Aliphatic polyol Potassium hydroxide	Proprietary 1310 58-3

4700900150

RECEIVED
Office of Oil and Gas
RECEIVED
Office of Oil and Gas
JAN 15 2016

WV Department of
Environmental Protection
FEB 17 2016
WV Department of
Environmental Protection
04/08/2016

Supplier Name	Product Name	Product Use	Chemical Name	CAS Number
BAKER HUGHES	ALPHA 1427	Biocide	Didecyl Dimethyl Ammonium Chloride	007173-51-1
			Ethanol	000064-17-5
			Glutaraldehyde (Pentanediol)	000111-30-8
			Quaternary Ammonium Compound	068424-85-1
			Water	007732-18-5
	BF-7L	Buffer	Potassium Carbonate	000584-08-7
	ClayCare	Clay Stabilizer	Choline Chloride	000067-48-1
			Water	007732-18-5
	Enzyme G-I	Breaker	No Hazardous Components	NONE
	ENZYME G-NE	Breaker	No Hazardous Components	NONE
	FRW-18	Friction Reducer	Petroleum Distillate Hydrotreated Light	064742-47-8
	GW-3LDF	Gel	Petroleum Distillate Blend	N/A-014
			Polysaccharide Blend	N/A-021
	SCALETROL 720	Scale Inhibitor	Diethylene Glycol	000111-46-6
Ethylene Glycol			000107-21-1	
XLW-32	Crosslinker	Boric Acid	010043-35-3	
		Methanol (Methyl Alcohol)	000067-56-1	
FRAC TECH SERVICES	APB01 (AMMONIUM PERSUFATE BREAKER)	Breaker	Ammonium Persulfate	007727-54-0
	B05 (LOW PH BUFFER)	Buffer	Acetic acid	000064-19-7
	BXL03 Borate XL Delayed High Temp	Crosslinker	No Hazardous Components	NONE
	FRW-200	Friction Reducer	No Hazardous Components	NONE
	HVG01 (TURQUOISE-1 BULK)	Gelling Agent	Petroleum Distillate Hydrotreated Light	064742-47-8
	KCLS-4	Clay Stabilizer	No Hazardous Components	NONE
	LTB-1	Breaker	Ammonium Persulfate	N/A

RECEIVED
Office of Oil and Gas
RECEIVED
Office of Oil and Gas
JAN 15 2016
FEB 17 2016
WV Department of
Environmental Protection
WV Department of
Environmental Protection
04/08/2016

BROOKE COUNTY, WV HIGHWAY MAP



HIGHWAY MAP SCALE

ENTRANCE LOCATION

PROJECT LOCATION


WYDEP OOG
ACCEPTED AS-BUILT

12/14/2015

AS-BUILT ACCESS ROAD BEGINNING
NAD83 Latitude = N 40.26484°
NAD83 Longitude = W 80.68429°
UTM 83-17 Northing = 1421476.998 ft.
UTM 83-17 Easting = 1760574.300 ft.

AS-BUILT CENTER OF WELL PAD
NAD83 Latitude = N 40.25805°
NAD83 Longitude = W 80.68844°
UTM 83-17 Northing = 1421012.380 ft.
UTM 83-17 Easting = 1761146.252 ft.

STEPHENSVILLE EAST OHIO Q140 MAP

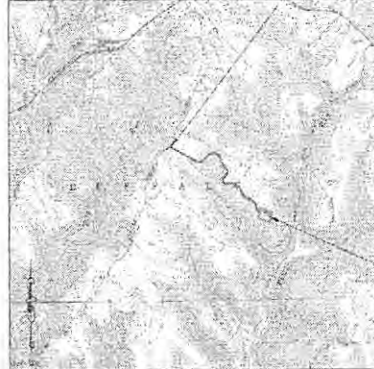

VICINITY MAP SCALE

ENTRANCE LOCATION

PROJECT LOCATION



SOUTHWESTERN ENERGY

AS-BUILT PLANS FOR THE

RUSSELL HERVEY BRK PAD "A"

BUFFALO DISTRICT, BROOKE COUNTY, WV

JULY 2015

SWN
Southwestern Energy

SOUTHWESTERN ENERGY
179 Chesapeake Drive
Jane Lew, WV 26178
(304) 884-1610

SHEET INDEX

SHEET	DESCRIPTION
1	TITLE SHEET
2-3	ELEVATION ROUTE/PERVALENCE W/DP
4	AS-BUILT OVERVIEW
5-7	AS-BUILT ACCESS ROAD PLAN
8	AS-BUILT WELL PAD PLAN
9	AS-BUILT ACCESS ROAD PROFILE
10	AS-BUILT WELL PAD PROFILE
11	RECLAMATION PLAN
12	RECLAMATION GENERAL NOTES
13	RECLAMATION DETAILS

RUSSELL HERVEY BRK PAD "A" WELLS

EXISTING WELL SH: AFB 41999-0044
EXISTING WELL ME: AFB 41999-0043

NOTES

- PORTIONS OF THE ORIGINAL AS-BUILT SURVEY OF THIS SITE PROVIDED BY BOORD BENTCHUCK & ASSOCIATES, INC (BBA) TO CHESAPEAKE ENERGY IN JANUARY 2011 HAVE BEEN INCORPORATED INTO THESE PLANS. THE BBA AS-BUILT SURVEY WAS PROVIDED TO THRASHER BY SOUTHWESTERN ENERGY IN JUNE 2012 INCLUDING CONVEYERS, PROPERTY LINES, ENVIRONMENTAL FEATURES, ROADS, BUILDINGS, TRENCHES, ETC.
- EXISTING ROAD EDGES, WELL PAD FENCE, GAS PRODUCTION EQUIPMENT AND ABOVE GROUND PIPING AND EMISSION & SEDIMENT CONTROL FEATURES WERE VERIFIED AND AS-BUILT BY THRASHER JUNE 2015
- THE COORDINATE SYSTEM USED FOR THIS PROJECT IS UTM WITH NAD83 DATUM, ZONE 17, UN PROJ., CENTRAL MERIDIAN 81°W.



WV SIGN NUMBER	REVISED SHEETS	BY	DATE	DESCRIPTION
1	1, 4-13	JK	5/20/15	APPROVED AS-BUILT COMMENTS FOR WYDEP OFFICE BY ME & CIVIL ACCESS AS-BUILT ACCESS ROAD PROFILE, RECLAMATION PLAN, PERVALENCE W/DP & CELLAR INFORMATION.

ONE CALL UTILITY SYSTEM CONTACT INFO



CONTRACTOR SHALL NOTIFY THE ONE CALL SYSTEM OF THE INTENDED EXCAVATION OR DEMOLITION NOT LESS THAN 14 DAYS PRIOR TO THE START OF WORK AND NOT LESS THAN 7 DAYS PRIOR TO THE START OF EACH WORK DAY. WORK SHALL BE COMPLETED WITHIN TEN (10) WORK DAYS FROM THE BEGINNING OF SUCH WORK.

THIS INFORMATION CONTAINED HEREON IS THE SOLE PROPERTY OF THE THRASHER GROUP, INC. REPRODUCTION OR THEFT OF THIS DOCUMENT IS STRICTLY PROHIBITED. ANY UNAUTHORIZED REPRODUCTION OR THEFT OF THIS DOCUMENT IS STRICTLY PROHIBITED.

THRASHER

THE THRASHER GROUP, INC.
600 WHITE OAKS BOULEVARD - BRIDGEPORT, WV 26110
PHONE: (304) 624-1156 • FAX: (304) 624-2631

WVDEP 00G
ACCEPTED AS-BUILT
WJ 12/4/2016

PLAN LEGEND

- PRE-CONSTRUCTION CONTOURS
- EXISTING ROAD
- EXISTING TREE LINE
- EXISTING PROPERTY LINE
- EXISTING TELEPHONE LINE
- EXISTING WATER LINE
- BBA AS-BUILT 10" C/P/POUTLET PROTECTION
- BBA AS-BUILT PROPERTY BOUNDARY
- BBA AS-BUILT WATER/SEWER
- BBA AS-BUILT STREAM
- BBA AS-BUILT WETLAND
- BBA AS-BUILT ELECTRIC LINE
- TTC AS-BUILT ROAD EDGE
- TTC AS-BUILT EDGE OF PAVEMENT
- TTC AS-BUILT LOG PILE
- TTC AS-BUILT PAD EDGE
- TTC AS-BUILT FENCE
- X TTC AS-BUILT DITCH
- TTC AS-BUILT CONTAMINATED AREA
- TTC AS-BUILT PROHIBITION EQUIPMENT
- TTC AS-BUILT FLY FENCE
- TTC AS-BUILT TEXT
- BBA AS-BUILT TEXT



NOTES

1. MOUNTABLE BERM TO BE INSTALLED PRIOR TO DRILLING OF PROPOSED WELLS

RUSSELL HERVEY BRK PAD "A" WELLS

WELL NAME	API NUMBER	CELLAR DIAMETER	CELLAR DEPTH	CELLAR MATERIAL
AS-BUILT #1	47-009-00141	8 FT	8 FT	CMP*
AS-BUILT #4	47-009-00136	8 FT	8 FT	CMP*
PROPOSED WELL #10	-	8 FT	8 FT	CMP*
PROPOSED WELL #20	-	8 FT	8 FT	CMP*
PROPOSED WELL #20H	-	8 FT	8 FT	CMP*
PROPOSED WELL #20H	-	8 FT	8 FT	CMP*
PROPOSED WELL #20H	-	8 FT	8 FT	CMP*


NOTES:
 * CMP = CORRUGATED METAL PIPE

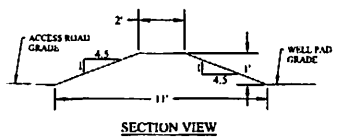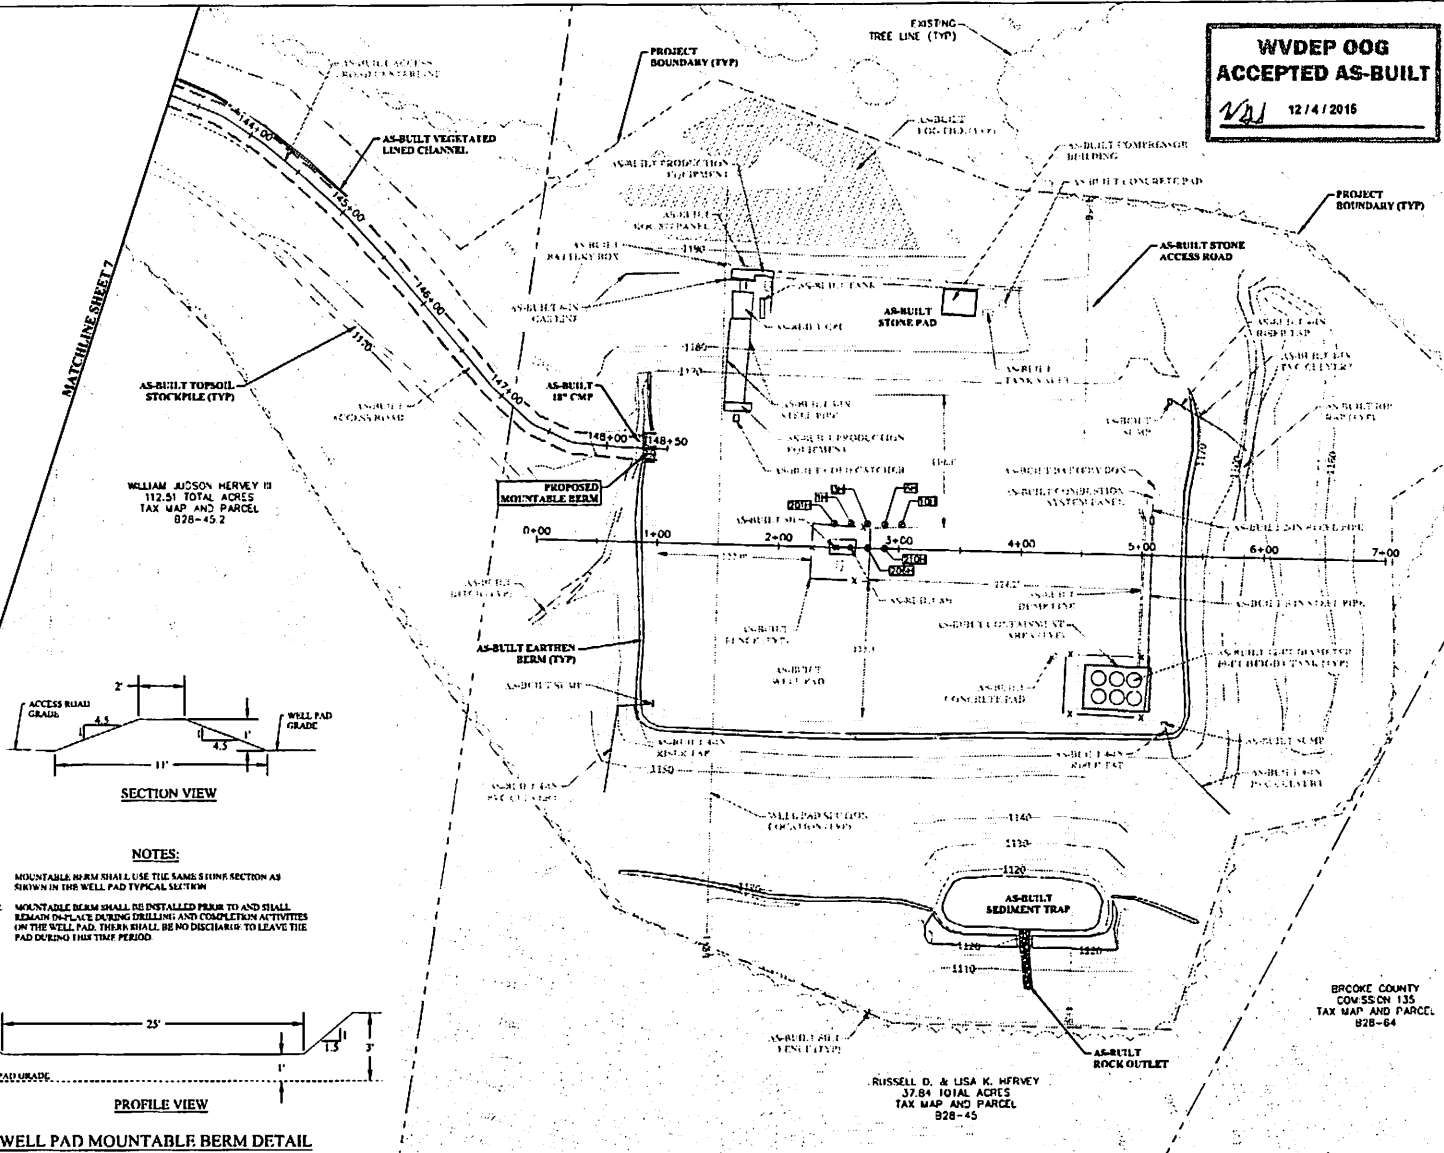

SECTION VIEW

NOTES:

1. MOUNTABLE BERM SHALL USE THE SAME'S HUMP SECTION AS SHOWN IN THIS WELL PAD TYPICAL SECTION
2. MOUNTABLE BERM SHALL BE INSTALLED PRIOR TO AND SHALL REMAIN IN PLACE DURING DRILLING AND COMPLETION ACTIVITIES ON THE WELL PAD. THERE SHALL BE NO DISCHARGE TO LEAVE THE PAD DURING THIS TIME PERIOD

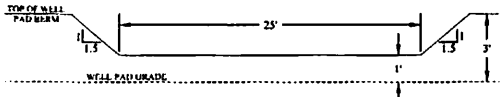

PROFILE VIEW

WELL PAD MOUNTABLE BERM DETAIL
 NOT TO SCALE

THE INFORMATION CONTAINED HEREIN IS THE SOLE PROPERTY OF THE THRASHER GROUP, INC. REPRODUCTION OF THESE DOCUMENTS IN WHOLE OR IN PART, FOR ANY REASON WITHOUT PRIOR WRITTEN PERMISSION, IS STRICTLY PROHIBITED. COPYRIGHT © 2015 THE THRASHER GROUP, INC.

NO	BY	DATE	DESCRIPTION
1	JFW	12/03/16	AS-BUILT 49-BLAJ COMMENTS PER WVPD OFFICE OF OIL & GAS DEPARTMENT

SWN
 Southwestern Energy

SCALE:
 DRAWN: DATE:
 CHECKED: DATE:
 APPROVED: DATE:
 ISSUE DATE:
 SURVEY BY:
 PLOD BOOK NO.:

THRASHER
 THE THRASHER GROUP, INC.
 100 WEST MAIN STREET, SUITE 2000, CHARLOTTE, NC 28202
 TEL: 704.359.6249 FAX: 704.359.6247

PHASE No:
 CONTRACT No:
 PROJECT No:
101-050-5495


SOUTHWESTERN ENERGY
 AS-BUILT PLANS FOR THE
 RUSSELL HERVEY BRK PAD "A"
 BROOKE COUNTY, WV
 AS-BUILT WELL PAD PLAN

SHEET No.

8


DATE: 12/16/16 10:56 AM
 USER: jfw
 PROJECT: 101-050-5495
 DRAWING: AS-BUILT WELL PAD PLAN
 SCALE: 1"=50'
 SHEET: 8 OF 8
 PLOT: 04/17/16 12:07:03 PM

BROOKE COUNTY, WY HIGHWAY MAP PROJECT LOCATION

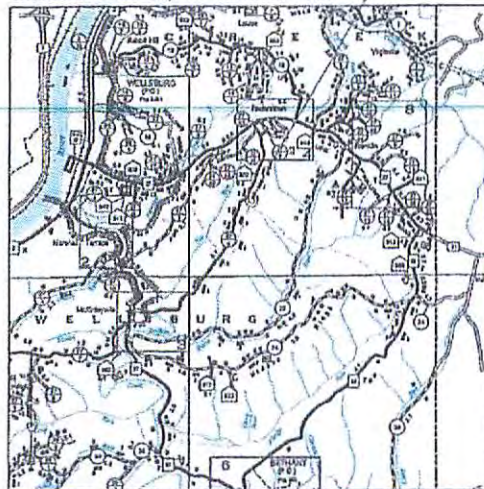

1 MILE 0 1 MILE 2 MILES
HIGHWAY MAP SCALE

STEUBENVILLE EAST OHIO QUAD MAP PROJECT LOCATION

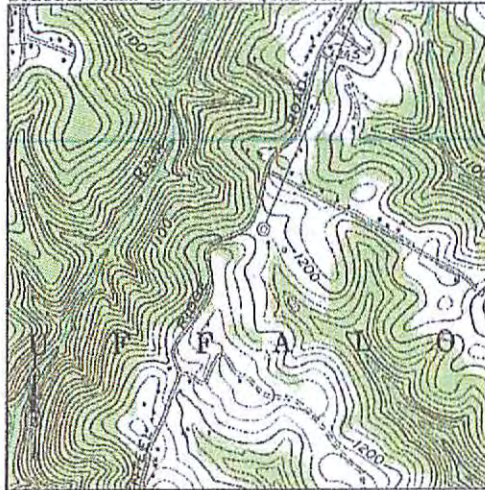

2000' 0 2000' 4000'
VICINITY MAP SCALE

SOUTHWEST

AS-BUILT

RUSSELL HIGHWAY

BUFFALO DISTRICT

AS-BUILT ACCESS ROAD BEGINNING
 NAD83 Latitude = N 40 26 486.4"
 NAD83 Longitude = W 80 56 826.0"
 UTM 83-17 Northing = 14623476.593 ft.
 UTM 83-17 Easting = 1760874.300 ft.

AS-BUILT CENTER OF WELL PAD
 NAD83 Latitude = N 40 25 803.3"
 NAD83 Longitude = W 80 55 651.0"
 UTM 83-17 Northing = 14621012.380 ft.
 UTM 83-17 Easting = 1761146.252 ft.

PROJECT LOCATION



ONE CALL UTILITY SYSTEM CONTACT INFO



CONTRACTOR SHALL NOTIFY THE ONE-CALL SYSTEM OF THE INTENDED EXCAVATION OR DEMOLITION NOT LESS THAN FORTY-EIGHT (48) HOURS, EXCLUDING SATURDAYS, SUNDAYS AND 1 LEGAL FEDERAL OR STATE HOLIDAYS, NOR MORE THAN TEN (10) WORK DAYS PRIOR TO THE BEGINNING OF SUCH WORK.

THE INFORMATION CONTAINED HEREIN IS THE SOLE PROPERTY OF THE STATE OF WEST VIRGINIA. IT IS TO BE USED ONLY FOR THE PROJECT DESCRIBED IN THIS DOCUMENT. IN WHOLE OR IN PART. FOR ANY REASON. COPYRIGHT © 2016

04/08/2016

D:\PROJECTS\1425-Substation\1425-Substation\Drawings\1425-Substation\1425-Substation.dwg
 PLOT DATE/TIME: 7/10/2015 10:20 AM
 USER: kyle.j.weston

4700900178

SOUTHWESTERN ENERGY

AS-BUILT PLANS FOR THE

THRASHER BRK PAD "A"

SURVEY, BROOKE COUNTY, WV

JULY 2015

SWN

Southwestern Energy[®]

SOUTHWESTERN ENERGY
179 Chesapeake Drive
Jane Lew, WV 26378
(304) 884-1610

SHEET INDEX	
SHEET	DESCRIPTION
1	TITLE SHEET
2-3	EVACUATION ROUTE/PREVAILING WIND
4	AS-BUILT OVERVIEW
5-7	AS-BUILT ACCESS ROAD PLAN
8	AS-BUILT WELL PAD PLAN

- #### NOTES
1. PORTIONS OF THE ORIGINAL AS-BUILT SURVEY OF THIS SITE PROVIDED BY BOORD BENCHECK & ASSOCIATES, INC (BBA) TO CHESAPEAKE ENERGY IN JANUARY 2013 HAS BEEN INCORPORATED INTO THESE PLANS. THE BBA AS-BUILT SURVEY WAS PROVIDED TO THRASHER BY SOUTHWESTERN ENERGY IN JUNE 2015 INCLUDING CONTOURS, PROPERTY LINES, ENVIRONMENTAL FEATURES, ROADS, BUILDINGS, TREELINES, ETC.
 2. EXISTING ROAD EDGES, WELL PAD EDGE, GAS PRODUCTION EQUIPMENT AND ABOVE GROUND PIPING, AND EROSION & SEDIMENT CONTROL FEATURES WERE VERIFIED AND AS-BUILT BY THRASHER JUNE 2015.
 3. THE COORDINATE SYSTEM USED FOR THIS PROJECT IS UTM WITH NAD83 DATUM, ZONE 17, US FOOT; CENTRAL MERIDIAN 814W.



E. B. Ho
7/14/15

THRASHER

THE THRASHER GROUP, INC.
600 WHITE OAKS BOULEVARD -- BRIDGEPORT, WV 26330
PHONE (304) 624-4108 • FAX (304) 624-7831

RECEIVED
Office of Oil and Gas
FEB 17 2016
WV Department of
Environmental Protection

PROPERTY OF THE THRASHER GROUP, INC. REPRODUCTION OF THESE PLANS WITHOUT WRITTEN PERMISSION IS STRICTLY PROHIBITED.
THE THRASHER GROUP, INC.

04/08/2016