

### west virginia department of environmental protection

Office of Oil and Gas 601 57th Street, S.E. Charleston, WV 25304 (304) 926-0450 fax: (304) 926-0452

Austin Caperton, Cabinet Secretary www.dep.wv.gov

Tuesday, September 10, 2019 WELL WORK PERMIT Horizontal 6A / New Drill

SWN PRODUCTION COMPANY, LLC POST OFFICE BOX 12359

SPRING, TX 773914954

Re: Permit approval for MILDRED MANI BRK 210H 47-009-00284-00-00

This well work permit is evidence of permission granted to perform the specified well work at the location described on the attached pages and located on the attached plat, subject to the provisions of Chapter 22 of the West Virginia Code of 1931, as amended, and all rules and regulations promulgated thereunder, and to any additional specific conditions and provisions outlined in the pages attached hereto. Notification shall be given by the operator to the Oil and Gas Inspector at least 24 hours prior to the construction of roads, locations, and/or pits for any permitted work. In addition, the well operator shall notify the same inspector 24 hours before any actual well work is commenced and prior to running and cementing casing. Spills or emergency discharges must be promptly reported by the operator to 1-800-642-3074 and to the Oil and Gas Inspector.

Please be advised that form WR-35, Well Operators Report of Well Work is to be submitted to this office within 90 days of completion of permitted well work, as should form WR-34 Discharge Monitoring Report within 30 days of discharge of pits, if applicable. Failure to abide by all statutory and regulatory provisions governing all duties and operations hereunder may result in suspension or revocation of this permit and, in addition, may result in civil and/or criminal penalties being imposed upon the operators.

Per 35 CSR 4-5.2.g this permit will expire in two (2) years from the issue date unless permitted well work is commenced. If there are any questions, please feel free to contact me at (304) 926-0450.

James A. Martin

Chief

Operator's Well Number:

MILDRED MANI BRK 210H MILDRED MANI & MILES B

Farm Name: U.S. WELL NUMBER:

47-009-00284-00-00

Horizontal 6A

New Drill

Date Issued: 9/10/2019

API Number: 4700900294

### PERMIT CONDITIONS

West Virginia Code § 22-6A-8(d) allows the Office of Oil and Gas to place specific conditions upon this permit. Permit conditions have the same effect as law. Failure to adhere to the specified permit conditions may result in enforcement action.

### CONDITIONS

- 1. This proposed activity may require permit coverage from the United States Army Corps of Engineers (USACE). Through this permit, you are hereby being advised to consult with USACE regarding this proposed activity.
- 2. If the operator encounters an unanticipated void, or an anticipated void at an unanticipated depth, the operator shall notify the inspector within 24 hours. Modifications to the casing program may be necessary to comply with W. Va. Code § 22-6A-5a (12), which requires drilling to a minimum depth of thirty feet below the bottom of the void, and installing a minimum of twenty (20) feet of casing. Under no circumstance should the operator drill more than one hundred (100) feet below the bottom of the void or install less than twenty (20) feet of casing below the bottom of the void.
- 3. When compacting fills, each lift before compaction shall not be more than 12 inches in height, and the moisture content of the fill material shall be within limits as determined by the Standard Proctor Density test of the actual soils used in specific engineered fill, ASTM D698, Standard Test Method for Laboratory Compaction Characteristics of Soil Using Standard Effort, to achieve 95 % compaction of the optimum density. Each lift shall be tested for compaction, with a minimum of two tests per lift per acre of fill. All test results shall be maintained on site and available for review.
- 4. Operator shall install signage per § 22-6A-8g (6) (B) at all source water locations included in their approved water management plan within 24 hours of water management plan activation.
- 5. Oil and gas water supply wells will be registered with the Office of Oil and Gas and all such wells will be constructed and plugged in accordance with the standards of the Bureau for Public Health set forth in its Legislative rule entitled Water Well Regulations, 64 C.S.R. 19. Operator is to contact the Bureau of Public Health regarding permit requirements. In lieu of plugging, the operator may transfer the well to the surface owner upon agreement of the parties. All drinking water wells within fifteen hundred feet of the water supply well shall be flow tested by the operator upon request of the drinking well owner prior to operating the water supply well.
- 6. Pursuant to the requirements pertaining to the sampling of domestic water supply wells/springs the operator shall, no later than thirty (30) days after receipt of analytical data provide a written copy to the Chief and any of the users who may have requested such analyses.
- 7. 24 hours prior to the initiation of the completion process the operator shall notify the Chief or his designee.
- 8. During the completion process the operator shall monitor annular pressures and report any anomaly noticed to the chief or his designee immediately.
- 9. If any explosion or other accident causing loss of life or serious personal injury occurs in or about a well or well work on a well, the well operator or its contractor shall give notice, stating the particulars of the explosion or accident, to the oil and gas inspector and the Chief, within 24 hours of said accident.
- 10. During the casing and cementing process, in the event cement does not return to the surface, the oil and gas inspector shall be notified within 24 hours.

API Number: 4700900284

## PERMIT CONDITIONS

11. The operator shall provide to the Office of Oil and Gas the dates of each of the following within 30 days of their occurrence: completion of construction of the well pad, commencement of drilling, cessation of drilling, cessation of drilling, sending an email to DEPOOGNotify@wv.gov.

WW-6B (04/15) OPERATOR WELL NO. Mildred Mani BRK 210H
Well Pad Name: Mildred Mani BRK

# STATE OF WEST VIRGINIA DEPARTMENT OF ENVIRONMENTAL PROTECTION, OFFICE OF OIL AND GAS WELL WORK PERMIT APPLICATION

1) Well Operator:	SWN P	roduction C	Co., LLC	4945	12924	009-Brook	o1-Buffa	620-Steubenville
-				Ope	ator ID	County	District	Quadrangle
2) Operator's Well	l Number	Mildred M	lani BRK	210H	_ Well Pa	d Name: Mi	ldred Mani B	RK
3) Farm Name/Sur	rface Own	ner: Mildred N	/Iani & Miles	s Bauer	Public Roa	ad Access: E	Brady's Ridge	Road
4) Elevation, curre	ent ground	d: 1073'	E	levatior	, proposed	post-constru	action: 1073'	
, , ,	) Gas	X	_ Oil		Und	lerground Sto	orage	
(b	)If Gas	Shallow	X		Deep			-
		Horizontal	X				11)	
6) Existing Pad: Y	es or No	Yes			·····	_ ( .)	711	7.7.10
7) Proposed Targe	t Formati	on(s), Depth	n(s), Antic	pated	Thickness	and Expected	d Pressure(s):	Associated Break 2700
Target Formation- Marc	cellus, Down-D	Dip Well to the Sou	th, Target Top	TVD- 576	9', Target Base 1	FVD- 5831', Anticip	ated Thickness- 62',	Associated Pressure- 3790
8) Proposed Total	Vertical 1	Depth: <u>581</u>	7'		· · · · · · · · · · · · · · · · · · ·			
9) Formation at To	otal Vertic	cal Depth:	Marcellus	s				
10) Proposed Tota	l Measure	ed Depth:	13306'					
11) Proposed Hori	zontal Le	g Length:	7049.74					
12) Approximate l	Fresh Wa	ter Strata De	epths:	207'	· · · · · · · · · · · · · · · · · · ·			
13) Method to Det	termine F	resh Water I	Depths:	Water	Depth bas	ed on logs		
14) Approximate S	Saltwater	Depths: 28	32' Salinit	y Calcu	lation			
15) Approximate (								
16) Approximate 1				ine, ka	st, other):	Possible Vo	oid 119'	
17) Does Proposed directly overlying	d well loc	ation contain	n coal sea	ıms	Tes		No X	RECEIVED Office of Oil and Gas
(a) If Yes, provide	de Mine I	nfo: Name	<b>:</b> :					bront of
(a) 11 1 00; broth		Depth						Environmental Protection
		Seam						
		Owne						

WW-6B (04/15) API NO.47\_000 3 0 0 2 8 4

OPERATOR WELL NO. Mildred Mani BRK 210H

Well Pad Name: Mildred Mani BRK

### 18)

### **CASING AND TUBING PROGRAM**

TYPE	Size (in)	New or Used	Grade	Weight per ft. (lb/ft)	FOOTAGE: For Drilling (ft)	INTERVALS: Left in Well (ft)	CEMENT: Fill-up (Cu. Ft.)/CTS
Conductor	20"	New	H-40	94#	100'	100'	CTS
Fresh Water	13 3/8"	New	H-40	48#	257'	257'	269 sx/CTS
Coal	See	Surface	Casing				
Intermediate	9 5/8"	New	J-55	36#	1501'	1501'	594 sx/CTS
Production	5 1/2"	New	HCP-110	20#	13,306'	13,306'	lead 800sx/Tall 1824sx/ 100' Inside Interr
Tubing							
Liners							

CBO7-219

ТҮРЕ	Size (in)	Wellbore Diameter (in)	<u>Wall</u> <u>Thickness</u> <u>(in)</u>	Burst Pressure (psi)	Anticipated Max. Internal Pressure (psi)	Cement Type	Cement Yield (cu. ft./k)
Conductor	20"	30"	0.25	2120	81	Class A	1.19/50% Excess
Fresh Water	13 3/8"	17.5"	0.380	2740	633	Class A	1.19/50% Excess
Coal	See	Surface	Casing				
Intermediate	9 5/8"	12 1/4"	0.395	3950	1768	Class A	1.19/50% Excess
Production	5 1/2"	8 3/4"	0.361	12360	9500	Class A	1.20/50% Excess
Tubing							
Liners							

### **PACKERS**

Kind:		
Sizes:		RECFIVED
Depths Set:		RECEIVED Office of Oil and Gas

WV Department of Environmental Protection WW-6B (10/14) 4700 a 00284

OPERATOR WELL NO. Mildred Mani BRK 210H
Well Pad Name: Mildred Mani BRK

19) Describe proposed well work, including the drilling a	and plugging back of any pilot hole:
---	--------------------------------------

Drill and stimulate any potential zones between and including the Benson to Marcellus. \*\*If we should encounter a void place basket above and below void area- balance cement to bottom of void and grout from basket to surface or run external casing packer/cementing stage tool above void interval and perform 2 stage cementing operation dependent upon depth of void. Run casing not less than 20' below void nor more than 75' below void. (\*If freshwater is encountered deeper than anticipated it must be protected, set casing 50' below and cts.)

20) Describe fracturing/stimulating methods in detail, including anticipated max pressure and max rate:

Well will be perforated within the target formation and stimulated with a slurry of water, sand, and chemical additives at a high rate. This will be performed in stages with the plug and perf method along the wellbore until the entire lateral has been stimulated within the target formation. All stage plugs are then drilled out and the well is flowed back to surface. The well is produced through surface facilities consisting of high pressure production unites, horizontal separation units, water and oil storage tanks. Max press and anticipated max rate- 9000 lbs @ 100 barrels a minute.

- 21) Total Area to be disturbed, including roads, stockpile area, pits, etc., (acres): 10
- 22) Area to be disturbed for well pad only, less access road (acres): 4.4

23) Describe centralizer placement for each casing string:

All casing strings will be ran with a centralizer at a minimum of 1 per every 3 joints of casing.

24) Describe all cement additives associated with each cement type:

RECEIVED
Office of Oil and Gas

See Attachment \*\*\*


JUL 3 0 2019

WV Department of Environmental Protection

25) Proposed borehole conditioning procedures:

All boreholes will be conditioned with circulation and rotation for a minimum of one bottoms up and continuing until operator is satisfied with borehole conditions.

<sup>\*</sup>Note: Attach additional sheets as needed.

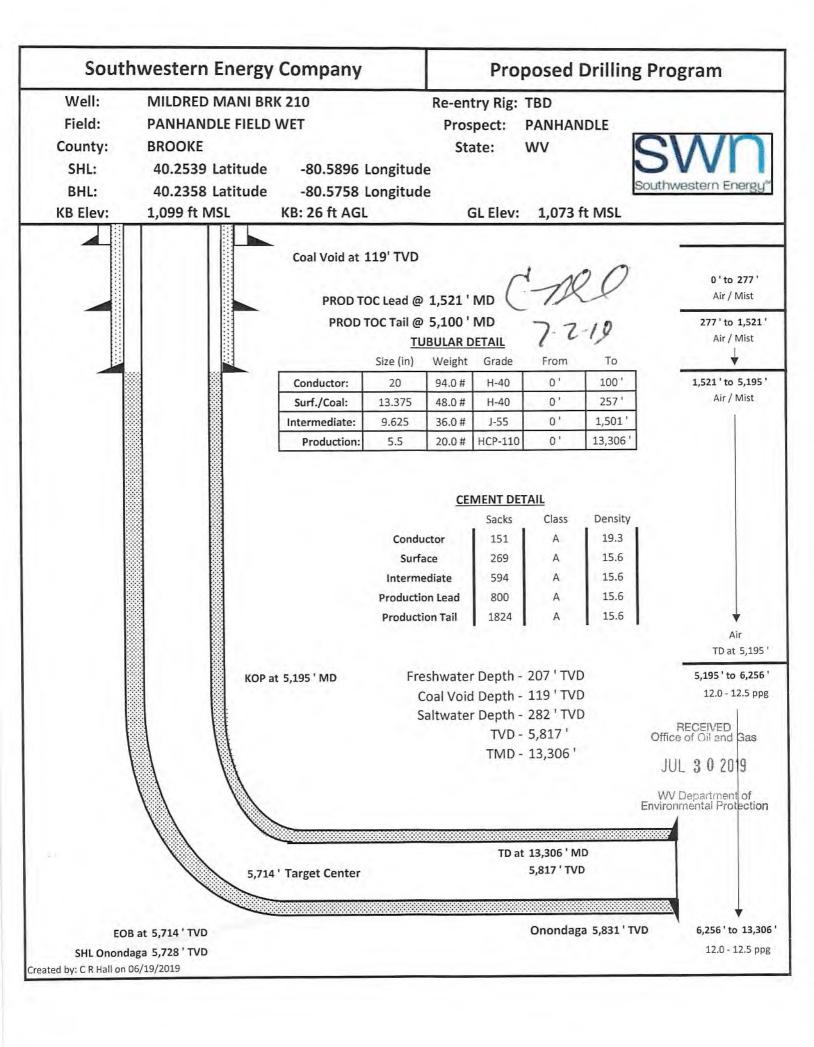

	Willgred Mani BRN 210H AUR						
API	Operator	Status	Latitude	Longitude	Vertical TD	Producing Formation	<b>Producing Zones Not Perforated</b>
47-009-00158	SWN PRODUCTION COMPANY, LLC	ACTIVE	40.253982	-80.589595		MARCELLUS	
47-009-00161	SWN PRODUCTION COMPANY, LLC	ACTIVE	40.253951	-80.589622		MARCELLUS	
47-009-00160	SWN PRODUCTION COMPANY, LLC	ACTIVE	40.253951	-80.589534		MARCELLUS	
47-009-00159	SWN PRODUCTION COMPANY, LLC	ACTIVE	40.253920	-80.589561		MARCELLUS	
47-009-00091	SWN PRODUCTION COMPANY, LLC	ACTIVE	40.253888	-80.589587		MARCELLUS	

RECEIVED
Office of Oil and Gas

JUL 3 0 2019

WV Department of Environmental Protection Schlumberger Cement Additives

	Product Name	Product Use	Chemical Name	CAS Number
Surface	S001	accelerator	calcium chloride up to 3%	10043-52-4
Intermediate Surface	5001	accelerator	calcium chloride	10043-52-4
-	D080	dispersant	sodium polynaphthalene sulfonate	9008-63-3
9	D801	retarder	aromatic polymer derivative	propriatary
Kick Off Plug	D047	antifoam	polypropylene glycol	25322-69-4
	D167	fluid loss	aliphatic amide polymer	propriatary
	D154	extender	non-crystalline silica	7631-86-9
	D400	gas migration	boric acid	10043-35-3
			polypropylene glycol	25322-69-4
pe	D046	antifoam	fullers earth (attapulgite)	8031-18-3
Production-Lead			chrystalline silica	14808-60-7
it o	D201	retarder	metal oxide	propriatary
oduc			sulphonated synthetic polymer	propriatary
Pro	D202	dispersant	formaldehyde (impurity)	propriatary
			polypropylene glycol	25322-69-4
	D046	antifoam	fullers earth (attapulgite)	8031-18-3
	D167	fluid loss	aliphatic amide polymer	propriatary
=			sodium polynaphthalene sulfonate	9008-63-3
T'	D065	dispersant	sodium sulfate	7757-82-6
Production-Tall			chrystalline silica	14808-60-7
de de	D201	retarder	metal oxide	propriatary
Pro	D153	anti-settling	chrystalline silica	14808-60-7

RECEIVED
Office of Oil and Gas

Rev. 5/18/2018

JUL 3 0 2019

WV Department of Environmental Protection WW-9 (4/16)

API Number 47 - 009	
Operator's Well No.	Mildred Mani BDV 210U

# STATE OF WEST VIRGINIA DEPARTMENT OF ENVIRONMENTAL PROTECTION OFFICE OF OIL AND GAS

FLUIDS/ CUTTING	S DISPOSAL & RECLAMATION PLAN
Operator Name SWN Production Co., LLC	OP Code 494512924
Watershed (HUC 10) Upper Ohio South	Quadrangle Steubenville East/Bethany
Do you anticipate using more than 5,000 bbls of water to Will a pit be used? Yes No V	o complete the proposed well work? Yes 🗸 No
If so, please describe anticipated pit waste:	
Will a synthetic liner be used in the pit? Yes	No ✓ If so, what ml.?
Proposed Disposal Method For Treated Pit Was	stes:
Land Application	
Underground Injection (UIC	
	rm WW-9 for disposal location)
	ds will be put in steel tanks and reused or taken to a permitted disposal facility
Will closed loop system be used? If so, describe: Yes-	See Attachment 3A
Drilling medium anticipated for this well (vertical and he	orizontal)? Air, freshwater, oil based, etc. Air drill to KOP, fluid drill with SOBM from KOP to TD
-If oil based, what type? Synthetic, petroleum,	etc. Synthetic Oil Base
Additives to be used in drilling medium? Attachment 3B	
Drill cuttings disposal method? Leave in pit, landfill, re	moved offsite, etc.   landfill
-If left in pit and plan to solidify what medium	will be used? (cement, lime, sawdust)
-Landfill or offsite name/permit number? Meado	owfill SWF- 1032, Short Creek SWF-1034,Carbon Limestone MSWL018781, Wetzel County 1021
Argen Langill 100/2, Apex Sanitary Land	TIII 06-08438, Brooke Co SVVF-1013, Valley 100260
Permittee shall provide written notice to the Office of Or West Virginia solid waste facility. The notice shall be prwhere it was properly disposed.	il and Gas of any load of drill cuttings or associated waste rejected at any rovided within 24 hours of rejection and the permittee shall also disclose
on August 1, 2005, by the Office of Oil and Gas of the V provisions of the permit are enforceable by law. Violar law or regulation can lead to enforcement action.  I certify under penalty of law that I have per	ns and conditions of the GENERAL WATER POLLUTION PERMIT issued West Virginia Department of Environmental Protection. I understand that the stions of any term or condition of the general permit and/or other applicable resonally examined and am familiar with the information submitted on this it, based on my inquiry of those individuals immediately responsible for join is true, accurate, and complete. I am aware that there are significanted on possibility of fine or imprisonment.  JUL 3 0 2019  W Department Environmental Protection.
Subscribed and sworn before me this 34 da	Notary Public, State Of West Virginia
My commission expires $\sqrt{ \mathcal{G} /23 /2024}$	941 Simpson Run Road Weston WV 26452 My commission expires June 23, 2024

	., LLC		
Proposed Revegetation Treatm	nent: Acres Disturbed 10	Prevegetation p	он
Limeas determined by pH test	Tons/acre or to correct to j	pH 4.4	
Fertilizer type 10-20	0-20	-	
Fertilizer amount 60		_lbs/acre	
<sub>Mulch</sub> Hay/Straw	Ton	s/acre	
	<u>s</u>	eed Mixtures	
Tem	nporary	Perm	anent
Seed Type Attachment 3C	lbs/acre	Seed Type	lbs/acre
Maps(s) of road, location, pit a provided). If water from the pit	t will be land applied, include	lication (unless engineered plans including the pit, and dimensions (L x W x D) of the pit, and	uding this info have been d dimensions (L x W), and ar
Maps(s) of road, location, pit a provided). If water from the pit acreage, of the land application	t will be land applied, include n area.	lication (unless engineered plans including the pit, and	uding this info have been d dimensions (L x W), and ar
Maps(s) of road, location, pit a provided). If water from the pit acreage, of the land application Photocopied section of involve	t will be land applied, include n area.	dimensions (L x W x D) of the pit, an	uding this info have been ad dimensions (L x W), and ar
Maps(s) of road, location, pit a provided). If water from the pit acreage, of the land application Photocopied section of involve Plan Approved by:	t will be land applied, include n area.	dimensions (L x W x D) of the pit, an	d dimensions (L x W), and ar
Maps(s) of road, location, pit a provided). If water from the pit acreage, of the land application Photocopied section of involve Plan Approved by:	t will be land applied, include n area.	dimensions (L x W x D) of the pit, an	d dimensions (L x W), and ar
Attach: Maps(s) of road, location, pit a provided). If water from the pit acreage, of the land application Photocopied section of involve Plan Approved by:  Comments:  Title: Oil & Gas Inspection	t will be land applied, include narea.  ed 7.5' topographic sheet.	dimensions (L x W x D) of the pit, an	d dimensions (L x W), and ar

### Attachment 3A

### **CLOSED LOOP SYSTEM**

The closed loop system is designed to eliminate the use of reserve pits by providing a higher level of solids control processing and using steel pits for capture of drill cuttings. The cuttings are then processed to achieve landfill requirements before hauling to approved landfills. The liquids are processed to recycle into the active mud system or to transfer to onsite temporary storage as needed.

The closed loop system consists of several sets of a shale gas separator (often called a 'methana'), several banks of solids shakers, high speed centrifuges (1 or 2) used to process the fluid portion of the mud system to remove low gravity solids, low speed centrifuge used for barite recovery in high weight liquid drilling systems, a dewatering system (for air intervals and if freshwater mud systems are in use) used to further clean liquids by flocculation and additional mechanical separation, associated open top tanks for processing liquids and capturing solids for disposal, and transfer pumps to move fluids through the processes. There is an area adjacent to the cuttings tanks (Red Zone) where a track hole is utilized to recover the processed cuttings for loading into containers for hauloff. (See attached schematic of a generic closed loop system layout)

Below are discussions of the processes used when drilling the air interval or liquids interval.

### AIR DRILLING INTERVALS

During air drilling operations, flow from the rig will pass down the flowline to the Shale Gas Separater (sometimes called a methane) where gas and liquids/solids are separated. Gas is sent to the flare scrubber tank and is flared at the flare stack. Solids and fluids pass across a shaker system to separate solids from liquids. Solids pass into the cuttings tanks where they are captured for drying and hauloff to an approved landfill site. Liquids fall into a shaker tank and are collected by a centrifugal pump to be processed by the high speed centrifuge to further separate liquids and solids. Solids are then dumped into the cuttings tank for drying and hauloff. Liquids are further processed to remove additional low gravity solids before being reused or transferred to onsite storage.


### LIQUIDS DRILLING (FRESHWATER, BRINE, SOBM)

When drilling is converted to liquids drilling, the shale gas separator and associated shaker tank are bypassed, and the liquids system is processed over the primary and drying shaker systems. Cuttings drop into the cuttings tank for additional processing. Any recoverable associated liquids attached to the cutting are recovered out the tank and processed through the low gravity (high speed) and barite recovery centrifuges (low speed) to further remove low gravity solids and to recover barite for reuse in RECEIVED Gas the mud systems.

JUL 3 0 2019

WV Department of Environmental Protection



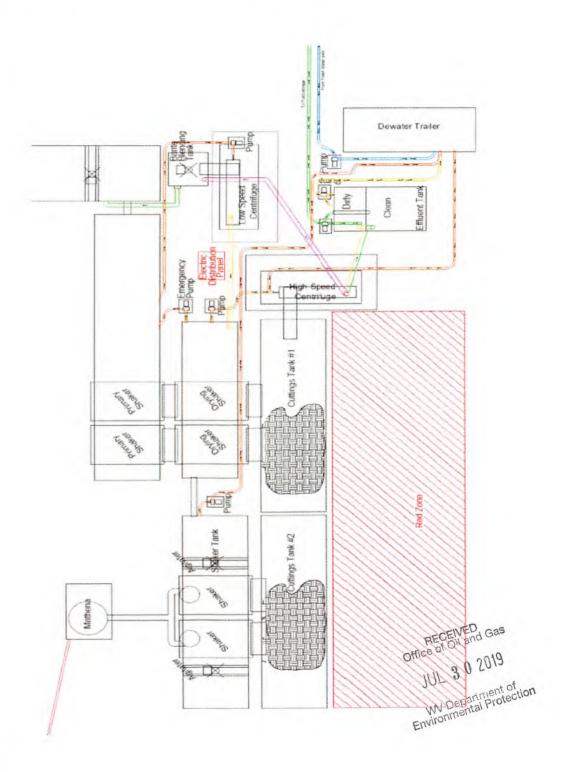

Solids Control Layout

### **Attachment 3B**

### **Drilling Mediums**

Surface/Coal(if present)/Freshwater Interval
--

Air

Freshwater (if needed based on conditions)

### **Intermediate/Coal (if present):**

Air

Brine (In Gas Storage areas)

Organophilic Bentonite

### **Production Hole:**

Air

Synthetic Oil (Base Fluid for mud system)

**Barite** 

Calcium Chloride

Lime

**Organophilic Bentonite** 

**Primary and Secondary Emulsifiers** 

Gilsonite

Calcium Carbonate

**Friction Reducers** 

Office of Oil and Gas

JUL 3 0 2019

WV Department of Environmental Protection

Apply @ 50lbs per acre

Apply @ 25lbs per acre

Swamp Verbena

Noolgrass

Fox Sedge

Soft Rush

April 16th- Oct, 14th

Office

2.5% 2.5% 2.5% 2.5% Oct. 15th- April 15th

NO FERTILIZER OR LIME INSIDE WETLAND LIMITS



NON-ORGANIC PROPERTIES

Seed Mixture: ROW Mix

Orchardgrass

imothy

# **WVD Seeding Specification**

Pelletized Lime @ 2 Tons per Acre Apply @ 2001bs per acre Oct. 15th- April 15th **SWN Supplied** (please allow 7 to 10 days for delivery) 20% 20% 20% Seed Mixture: SWN Production Organic Mix Organic Fertilizer @ 2001bs per Acre Apply @ 100lbs per acre April 16th- Oct. 14th ORGANIC PROPERTIES Organic Red or White Clover Organic Red or White Clover Organic Perennial Ryegrass To Order Seed contact Lyndsi Eddy Flippo office 570-996-4271 cell 501-269-5451 lyndsi\_eddy@swn.com Organic Timothy innoculated at 5x normal All legumes are Apply @ 2001bs per acre rate **SWN Supplied** 

15% 15%

2% 2% 2% 2% 2%

Medium Red Clover

Red Top

White Clover

**Brown Top Millet** Annual Ryegrass

# WETLANDS (delineated as jurisdictional wetlands)

30lbs per acre of Winter Wheat

Oct. 15th- April 15th PLUS

Apply @ 100lbs per acre April 16th- Oct. 14th

Rough Bluegrass **Birdsfoot Trefoil** 

SOIL AMENDMENTS

10-20-20 Fertilizer

Pelletized Lime

**SWN Supplied** 20% 20% 20% 10% 2% 2% 2% 2% Seed Mixture: Wetland Mix Cosmos 'Sensation' VA Wild Ryegrass **Annual Ryegrass Golden Tickseed** Maryland Senna Showy Tickseed Fowl Bluegrass Redtop

\*unless otherwise dictated by soil test results

\*Apply @ 500lbs per Acre Apply @ 2 Tons per Acre

> 1452' of 30' ROW/LOD is One Acre 871' of 50' ROW/LOD is One Acre 622' of 70' ROW/LOD is One Acre

Every 622 linear feet in a 70' ROW/LOD, you should be using (2) 50lb bags of seed, (4) 50lb bags of fertilizer and (80) 50lb bags of Lime (2x seed in winter months + 50lb Winter Wheat/ac)

# special Considerations:

Landowner Special Considerations including CREP program particles.

Landowner Special Considerations including CREP program particles.

Landowner Special Consideration at the Experiments with SWN supervision at the Experiments of the Experim

Rev. 5/22/2018

CEIVED Gas 3 0 2019 Department of imental Protection

# MARCELLUS WELL DRILLING PROCEDURES AND WELL SITE SAFETY PLAN




SWN Production Company, LLC 1300 Fort Pierpont Drive, Suite 201 Morgantown, West Virginia 26508

API NO. 47-XXX-XXXXX
WELL NAME: Mildred Mani BRK 210H
Steubenville East/Bethany QUAD
Buffalo DISTRICT
BROOKE COUNTY, WEST VIRGINIA

BROOKE	COUNTY, WEST VIRGINIA	
Submitted by: Name: <u>Brittany Woody</u> Suttany Woody	Date: <u>6/11/2019</u>	
Approved by: Name:  Title: Oil   Us Japan	SWN Production Co., LLC  Date: 1.2.19	RECEIVED Office of Oil and Gas  JUL 3 0 2019  WV Department of Environmental Protection
Approved by: Name: Title:	Date:	

SWN PRODUCTION COMPANY, LLC - CONFIDENTIAL

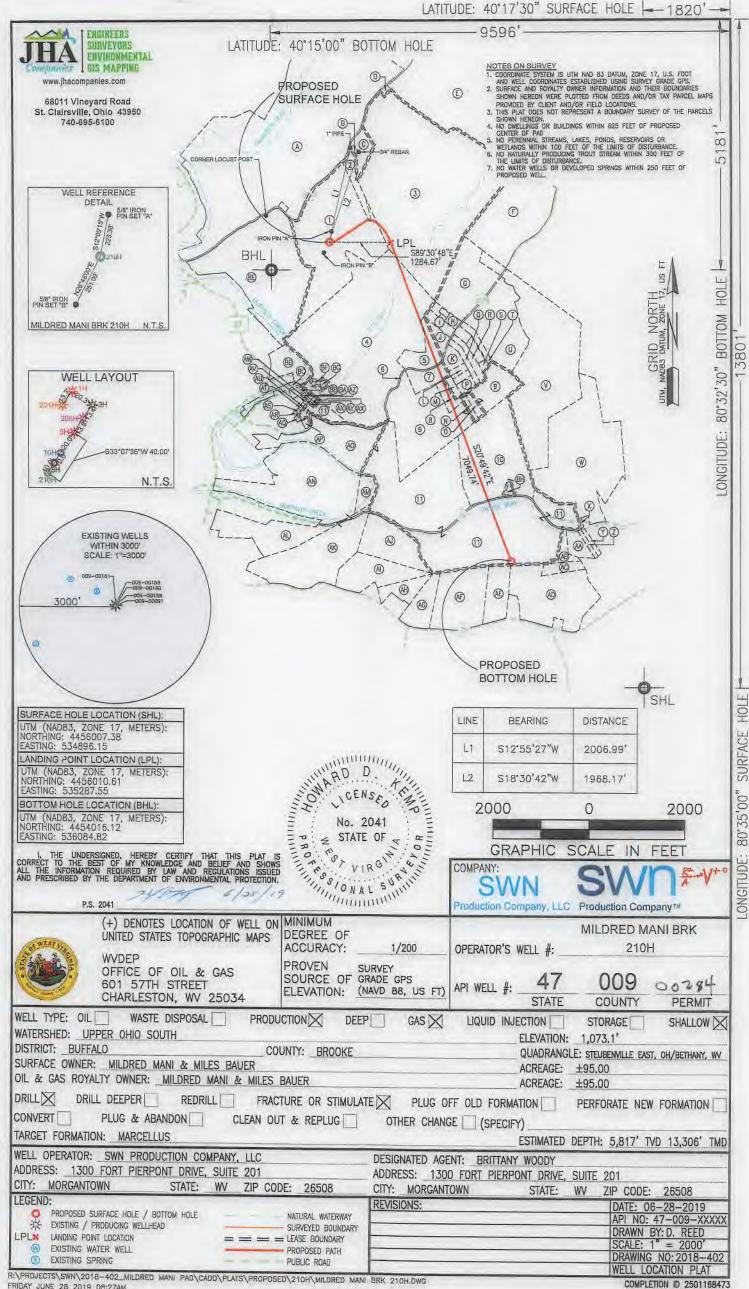

	WELL BORE TABLE FOR SURFACE / ROYALTY O	WNERS
TRACT	SURFACE OWNER (S) / ROYALTY OWNER (R)	TAX PARCEL
1	MILDRED MANI & MILES BAUER (S/R)	03-B27-26.0
TRACT	SURFACE OWNER	TAX PARCEL
2	MICHAEL W. SIMON	03-B27-25.0
3	CHAD ALAN & NICOLE TIFFANY GRAHAM	03-B27-22.0
4	STARVAGGI INDUSTRIES, INC.	03-B32H-41.0
5	GARY A., JR. & ANDREA MORRIS	03-B33-05.0
6	WEST VIRGINIA DEPARTMENT OF TRANSPORTATION, DIVISION OF HIGHWAYS	GENTEEL RIDGE ROAD
7	CAROL ANN WISNER	03-B33-06.0
8	CHRISTY A. CYBULSKI	03-B33-10.0
9	BEAR TRAK PROPERTIES, LLC	03-B33-10.2
10	STARVAGGI INDUSTRIES, INC.	03-B33-55.0
11	STARVAGGI INDUSTRIES, INC.	03-B33-54.0

RACT	ADJOINING OWNERS TABLE SURFACE OWNER	TAX PARCEL
A	MILDRED MANI, MILES BAUER & ERIK BAUER	03-B27-21.0
В	ANTHONY & KRYSTEN LONG	03-B27-24.0
С	LARRY B. & SHELLY D. ARACICH	03-B27-23.0
D	VEMURI HOME & GARDEN, LLC	03-B27-20.0
E	MIRANDA SILVER MILLER & JOYCE IRENE SAWYER	03-B28E-03.0
F	LANA LOU GILKEY	03-B28-20.0
G	KATHRYN A. DEGARMO (A.K.A. KATHRYN A. YOUNG)	03-B33-20.4
Н	THOMAS M. & DEBORAH J. OLDAKER	03-B33-01.0
1	NAOMI BARNHART	03-B33-03.0
j	ERIC SCOTT	03-B33-04.0
K	ELIZABETH J. & MICHAEL W. MCADOO	03-B33-04.0
L		
M	MARY JO RAMSEY (L/E: MIRIAM FAULKNER)	03-833-14.0
-	THOMAS F. & CHRISTY A. CYBULSKI	03-B33-07.0
N	JEFFREY L. MARTINDILL	03-833-09.0
0	RICHARD C. & BONNIE K. OLENICK	03-B33-08.0
P	EDWARD FRANK MARKER, III (L/E: DAKOTA J. MARKER)	03-B33-11.0
Q	JAMES W. HAUGHT & JUSTINA J. HAUGHT	03-B33-15.0
R	JAMES W. HAUGHT & JUSTINA L. HAUGHT	03-B33-16.0
S	ROBERT, JR. & CYNTHIA ANTILL	03-B33-17.2
T	JAMES W. MYERS (L/E: JAMES A. & JOANN MYERS)	03-B33-19.0
U	ALAN H. DEGARMO & MARY KATHRYN HERVEY	03-B33-20.3
٧	PATRICK DEGARMO	03-B33-20.0
W	STARVAGGI INDUSTRIES, INC.	03-B33-41.0
X	CHARLES J. DIXON	03-B33-51.0
Y	WELLS-GIST LAND COMPANY, LLC	03-B33-47.0
Z	LAWRENCE MCLAUGHLIN, II (L/E: GROVER LEE HAUGHT)	03-B33-48.0
AA	CARL & SOPHIA DEGARMO	03-B33-49.0
AB	PELUCHETTI FAMILY TRUST	03-B33-52.0
AC	PELUCHETTI FAMILY TRUST	03-B33-53.0
AD	DEBRA KAY PELAEZ	03-B33-71.0
AE	GREG & REGINA ZOLMAN	03-B33-69.0
AF	ELIZABETH SYLVIA BARR (T.O.D.) & JOSEPH BEAVER	03-B33-56.0
AG	BRIAN BIRDSALL	03-B32-120.0
AH	CARLE LEWIS JONES & MAE DELCIE	03-B32-124.0
Al	EDWARD J. MARKER	03-B32-126.0
AJ	JAMES S. & ADRIENE N. ALLEN	03-B32-98.0
AK	JAMIE L. & LESLIE OHLER	03-B32-99.1
AL	MARK & GEORGIA FEDAK	03-B32-99.0
AM	SAMUEL HERVEY HUBBARD	03-B32-97.0
AN	SAMUEL HERVEY HUBBARD	72.0536.3701
AO		03-832-96.0
	ALBERT & LOTTIE STEWART	03-B32H-50.0
AP	DAVID HAMILTON	03-B32H-39.0
AQ	SCOTT A. & FAITH L. LAW	03-B32H-36.0
AR	RICHARD P. & CLEO M. TAYLOR	03-B32H-27.0
AS	RICHARD P. & CLEO M. TAYLOR	03-B32H-26.0
AT	RICHARD P. & CLEO M. TAYLOR	03-B32H-25.0
AU	JAMIE JORDAN	03-B32H-25.
AV	JAMIE ALAN JORDAN	03-B32H-23.0
AW	JAMIE ALAN JORDAN	03-B32H-22.0
AX	WILLIAM E. JORDAN	03-B32H-20.0
AY	JAMIE ALAN JORDAN	03-B32H-19.0
AZ	JEFFREY RAY, JR. & JOANEETTE STACIA JORDAN	03-B32H-21.0
BA	CLYDE & CAROL JORDAN	03-B32H-18.0
BB	CLYDE & CAROL JORDAN	03-B32H-41.
BC	UNKNOWN OWNER	03-B32G-63.0
BD	BROOKE COUNTY SADDLE CLUB	03-B32H-01.0
BE	STARVAGGI INDUSTRIES, INC.	03-B27-27.0
BF	TRINA ARACICH	03-B32H-07.0
BG	TIMOTHY J. ARACICH	03-B32H-08.0
BH	CHARLES STEWART	03-B33-55.1

REVISIONS:	COMPANY:	SWN Production Company, LLC		Production Company™		
	OPERATOR'S WELL #:	MILDRED N		DATE: 06-28-2019 API NO: 47-009-XXXXX DRAWN BY:D. REED		
	DISTRICT: BUFFALO	COUNTY: BROOKE	STATE: WV	SCALE: N/A DRAWING NO:2018-402 WELL LOCATION PLAT		

WW-6A1 (5/13)

### INFORMATION SUPPLIED UNDER WEST VIRGINIA CODE Chapter 22, Article 6A, Section 5(a)(5) IN LIEU OF FILING LEASE(S) AND OTHER CONTINUING CONTRACT(S)

Under the oath required to make the verification on page 1 of this Notice and Application, I depose and say that I am the person who signed the Notice and Application for the Applicant, and that –

- (1) the tract of land is the same tract described in this Application, partly or wholly depicted in the accompanying plat, and described in the Construction and Reclamation Plan;
- (2) the parties and recordation data (if recorded) for lease(s) or other continuing contract(s) by which the Applicant claims the right to extract, produce or market the oil or gas are as follows:

Lease Name or Number

Grantor, Lessor, etc.

Grantee, Lessee, etc.

Royalty

Book/Page

See Attached Exhibit "A"

Office of Oil and Gas

JUL 3 0 2019

WW Department of Environmental Protection

### Acknowledgement of Possible Permitting/Approval In Addition to the Office of Oil and Gas

The permit applicant for the proposed well work addressed in this application hereby acknowledges the possibility of the need for permits and/or approvals from local, state, or federal entities in addition to the DEP, Office of Oil and Gas, including but not limited to the following:

- WV Division of Water and Waste Management
- WV Division of Natural Resources WV Division of Highways
- U.S. Army Corps of Engineers
- U.S. Fish and Wildlife Service
- County Floodplain Coordinator

The applicant further acknowledges that any Office of Oil and Gas permit in no way overrides, replaces, or nullifies the need for other permits/approvals that may be necessary and further affirms that all needed permits/approvals should be acquired from the appropriate authority before the affected activity is initiated.

Well Operator: SWN Production Company, LLC.

By:

Its: Staff Landman

# EXHIBIT "A"

8)	7)	6)	5)	4)	<u>u</u>	2) 2)	1	1)	#
03-0833-0010-0000-0000	03-0833-0006-0000-0000	Genteel Ridge Road	03-0833-0005-0000-0000	03-0B32H-0041-0000-0000	03-082/-0022-0000-0000	03-0827-0025-0000-0000		03-0827-0026-0000-0000	TMP: (1-4 - 4 pt.) The other will
Beverly A. White, widow	Carol Ann Wisner	West Virginia Department of Transportation, Division of Highways	Golden Eagle Resources II, LLC	Golden Eagle Resources II, LLC	Starvaggi industries, inc.	Michael W. Somon, a single man	Miles Bauer, widower	Mildred L. Mani, divorced and not remarried	LESSOR A TOWN OF A CONTROL OF A
Great Lakes Energy Partners, L.L.C. Range Resources - Appalachia, L.L.C. Chesapeake Appalachia, L.L.C. SWN Production Company, LLC	Chesapeake Appalachia, L.L.C. SWN Production Company, LLC	SWN Production Company, LLC	SWN Production Company, LLC	SWN Production Company, LLC	Fortuna Energy Inc. Range Resources - Appalachia, L.L.C. Chesapeake Appalachia, L.L.C. SWN Production Company, LLC	Chesapeake Appalachia, L.L.C. SWN Production Company, LLC	Great Lakes Energy Partners, L.L.C. Range Resources - Appalachia, LLC Chesapeake Appalachia, L.L.C. SWN Production Company, LLC	Great Lakes Energy Partners, L.L.C. Range Resources - Appalachia, LLC Chesapeake Appalachia, L.L.C. SWN Production Company, LLC	LESSEE TO THE TOTAL TOTA
12.50%	18.00%	20.00%	18.00%	18.00%	12.50%	18.00%	16.50%	16.50%	ROYALTY
10/40 20/733 10/552 30/480	14/599 30/480	50/739	40/607	40/607	9/532 10/226 10/541 30/480	14/586 30/480	9/596 20/733 10/552 30/480	9/526 20/733 10/552 30/480	BK/PG

4700 000284

				4/	, ,	<b>U</b>	<u>v</u>	<b>≫</b>
11)				10)				9)
03-0833-0054-0000-0000				03-0833-0055-0000-0000				03-0833-0010-0002-0000
Golden Eagle Resources II, LLC	Pattricia Ann Malestein	William Dean Counselman, Jr. and Nancy A. Cancelman, husband and wife	Carl F. and Deana Virginia Meinke, husband and wife	Stephen J. and Linda Lee Golembiewski, husband and wife				Beverly A. White, widow
SWN Production Company, LLC	SWN Production Company, LLC	SWN Production Company, LLC	SWN Production Company, LLC	SWN Production Company, LLC	SWN Production Company, LLC	Chesapeake Appalachia, L.L.C.	Range Resources - Appalachia, LLC	Great Lakes Energy Partners, L.L.C.
18.00%	18.00%	18.00%	18.00%	18.00%				12.50%
40/607	33/684	33/675	33/681	33/675	30/480	10/552	20/733	10/40

Office of Oil and Gas

JUL 3 0 2019

WV Department of Environmental Protection



SWN Production Company, LLC 1300 Fort Pierpont Dr, Ste 201 Morgantown, WV 26508 Tel: 304 884 1610 Fax: 304 471 2497 www.swn.com

July 18, 2019

Ms. Laura Adkins WV DEP Office of Oil & Gas 601 57<sup>th</sup> St., SE Charleston, WV 25304

RE: SWN's proposed New Well: Mildred Mani BRK 8H, Mildred Mani BRK 10H, and Mildred Mani BRK 210H in Brooke County, West Virginia, Drilling under Genteel Ridge Road and Pierce Run Road.

Dear Ms. Adkins:

SWN Production Company, LLC ("SWN") is applying for a drilling permit for the above referenced well. The State of West Virginia has raised some concern as to SWN's right to drill under Genteel Ridge Road and Pierce Run Road. Please be advised that SWN has leased all mineral owners under said route as it relates to the above-referenced well and unit.

Thank you.

Sincerely,

Michael H. Wilder Staff Landman

SWN Production Company, LLC

Office of Oil and Gas

JUL 3 0 2019

WW Department of Environmental Protection

R2 NV+°

The Right People doing the Right Things, wisely investing the cash flow from our underlying Assets, will create Value+®

# STATE OF WEST VIRGINIA DEPARTMENT OF ENVIRONMENTAL PROTECTION, OFFICE OF OIL AND GAS NOTICE CERTIFICATION

Date of Notic	ce Certification:		API No. 4	7- 009	
	-1001		Operator's	s Well N	0. Mildred Mani BRK 210H
			Well Pad I	Name:	Mildred Mani BRK
Notice has I	peen given:			_	
Pursuant to th	e provisions in West Virginia Code § 22-6	A, the Operator has pro	ovided the rea	quired pa	arties with the Notice Forms listed
	tract of land as follows:				
State:	West Virginia	— UTM NAD 83	Easting:	534,896	.15
County:	009-Brook	— UTWINAD 83	Northing:	4,456,00	7.38
District:	Buffalo	Public Road Acc	cess:	Brady's	Ridge Road
Quadrangle:	Stuebenville East/ Bethany	Generally used t	farm name:	Mildred	Mani
Watershed:	Upper Ohio South			7	

Pursuant to West Virginia Code § 22-6A-7(b), every permit application filed under this section shall be on a form as may be prescribed by the secretary, shall be verified and shall contain the following information: (14) A certification from the operator that (i) it has provided the owners of the surface described in subdivisions (1), (2) and (4), subsection (b), section ten of this article, the information required by subsections (b) and (c), section sixteen of this article; (ii) that the requirement was deemed satisfied as a result of giving the surface owner notice of entry to survey pursuant to subsection (a), section ten of this article six-a; or (iii) the notice requirements of subsection (b), section sixteen of this article were waived in writing by the surface owner; and Pursuant to West Virginia Code § 22-6A-11(b), the applicant shall tender proof of and certify to the secretary that the notice requirements of section ten of this article have been completed by the applicant.

Pursuant to West Virginia Code § 22-6A, the Opthat the Operator has properly served the require *PLEASE CHECK ALL THAT APPLY	perator has attached proof to this Notice Certification d parties with the following:	OOG OFFICE USE ONLY
$\square$ 1. NOTICE OF SEISMIC ACTIVITY or	NOTICE NOT REQUIRED BECAUSE NO SEISMIC ACTIVITY WAS CONDUCTED	RECEIVED/ NOT REQUIRED
2. NOTICE OF ENTRY FOR PLAT SURV	YEY or   NO PLAT SURVEY WAS CONDUCTED	☐ RECEIVED
■ 3. NOTICE OF INTENT TO DRILL or	☐ NOTICE NOT REQUIRED BECAUSE NOTICE OF ENTRY FOR PLAT SURVEY WAS CONDUCTED or	RECEIVED/ NOT REQUIRED
	☐ WRITTEN WAIVER BY SURFACE OWNER (PLEASE ATTACH)	
4. NOTICE OF PLANNED OPERATION	Offic RECEIVED	☐ RECEIVED
5. PUBLIC NOTICE	III and G	RECEIVED
6. NOTICE OF APPLICATION	JUL 3 0 2019  Environmental Frotection	□ promurp

Required Attachments:

The Operator shall attach to this Notice Certification Form all Notice Forms and Certifications of Notice that have been provided to the required parties and/or any associated written waivers. For the Public Notice, the operator shall attach a copy of the Class II Legal Advertisement with publication date verification or the associated Affidavit of Publication. The attached Notice Forms and Certifications of Notice shall serve as proof that the required parties have been noticed as required under West Virginia Code § 22-6A. Pursuant to West Virginia Code § 22-6A-11(b), the Certification of Notice to the person may be made by affidavit of personal service, the return receipt card or other postal receipt for certified mailing.

By:

### Certification of Notice is hereby given:

THEREFORE, I Brittany Woody , have read and understand the notice requirements within West Virginia Code § 22-6A. I certify that as required under West Virginia Code § 22-6A, I have served the attached copies of the Notice Forms, identified above, to the required parties through personal service, by registered mail or by any method of delivery that requires a receipt or signature confirmation. I certify under penalty of law that I have personally examined and am familiar with the information submitted in this Notice Certification and all attachments, and that based on my inquiry of those individuals immediately responsible for obtaining the information, I believe that the information is true, accurate and complete. I am aware that there are significant penalties for submitting false information, including the possibility of fine and imprisonment.

Well Operator: SWN Production Co., LLC

Brittany Woody

Its: Senior Regulatory Analyst

Telephone: 304-884-1610

Address: 1300 Fort Pierpont Dr., Suite 201

Morgantown, WV 26508

Facsimile: 304-884-1690

Email: Brittany\_Woody@swn.com



Subscribed and sworn before me this 34 day of June 2019

Notary Public

My Commission Expires (0/33/3

### Oil and Gas Privacy Notice:

The Office of Oil and Gas processes your personal information, such as name, address and telephone number, as part of our regulatory duties. Your personal information may be disclosed to other State agencies or third parties in the normal course of business or as needed to comply with statutory or regulatory requirements, including Freedom of Information Act requests. Our office will appropriately secure your personal information. If you have any questions about our use or your personal information, please contact DEP's Chief Privacy Officer at <a href="mailto:depprivacyofficer@wv.gov">depprivacyofficer@wv.gov</a>.

Office of Oil and Gas

JUL 3 0 2019

Environmental Protection

API NO. 47-009 - 0 0 2 6 4
OPERATOR WELL NO. Mildred Mani BRK 210H
Well Pad Name: Mildred Mani BRK

# STATE OF WEST VIRGINIA DEPARTMENT OF ENVIRONMENTAL PROTECTION, OFFICE OF OIL AND GAS NOTICE OF APPLICATION

Notice Time Requirement: notice shall be provided no later th	an the filing date of permit application.
Date of Notice: Date Permit Application Filed: Notice of:	tastia
☑ PERMIT FOR ANY ☐ CERTIFICATE OF APPLICATE OF APPLI	PROVAL FOR THE
	AN IMPOUNDMENT OR PIT
WEED WORK CONSTRUCTION OF	ALVINI OUNDMENT ORTH
Delivery method pursuant to West Virginia Code § 22-6A-10	0(b)
☐ PERSONAL ☐ REGISTERED ☐ METH	OD OF DELIVERY THAT REQUIRES A
	IPT OR SIGNATURE CONFIRMATION
sediment control plan required by section seven of this article, and the surface of the tract on which the well is or is proposed to be loc oil and gas leasehold being developed by the proposed well work, it described in the erosion and sediment control plan submitted pursus operator or lessee, in the event the tract of land on which the well p more coal seams; (4) The owners of record of the surface tract or trace well work, if the surface tract is to be used for the placement, const impoundment or pit as described in section nine of this article; (5) have a water well, spring or water supply source located within one provide water for consumption by humans or domestic animals; and proposed well work activity is to take place. (c)(1) If more than three subsection (b) of this section hold interests in the lands, the applicance records of the sheriff required to be maintained pursuant to section provision of this article to the contrary, notice to a lien holder is not	or signature confirmation, copies of the application, the erosion and the well plat to each of the following persons: (1) The owners of record of the surface tract or tracts overlying the of the surface tract is to be used for roads or other land disturbance as ant to subsection (c), section seven of this article; (3) The coal owner, proposed to be drilled is located [sic] is known to be underlain by one or facts overlying the oil and gas leasehold being developed by the proposed ruction, enlargement, alteration, repair, removal or abandonment of any Any surface owner or water purveyor who is known to the applicant to thousand five hundred feet of the center of the well pad which is used to d (6) The operator of any natural gas storage field within which the ce tenants in common or other co-owners of interests described in ant may serve the documents required upon the person described in the eight, article one, chapter eleven-a of this code. (2) Notwithstanding any to notice to a landowner, unless the lien holder is the landowner. W. Va. provide the Well Site Safety Plan ("WSSP") to the surface owner and any
☐ Application Notice ☐ WSSP Notice ☐ E&S Plan Notice	e ☑ Well Plat Notice is hereby provided to:
☑ SURFACE OWNER(s)	☐ COAL OWNER OR LESSEE
Name: Mildred Mani	Name: Starvaggi Industries, Inc. Attn: Richard Trzaskoma
Address: 1709 Bradys Ridge Road	Address: 401 Pennslyvania Ave  Weirton, WV 26062  COAL OPERATOR  Name:  Office of Oil and Gas
Wellsburg, WV 26070	Weirton, WV 26062 Office of CIVED
Name: Eriik Bauer	COAL OPERATOR  Name:  Address:  Solventration  JUL  3 0 2019
Address: 15475 Southest 36th Ave	24 3 //
Summerfield, FL 34491	Address: Environmental Protection
☐ SURFACE OWNER(s) (Road and/or Other Disturbance)	Environm Departm
Name:	SURFACE OWNER OF WATER WELL
Address:	AND/OR WATER PURVEYOR(s)
	Name: See Attachment 13
Name:	Address:
Address:	
	☐ OPERATOR OF ANY NATURAL GAS STORAGE FIELD
☐ SURFACE OWNER(s) (Impoundments or Pits)	Name;
Name:	Address:
Address:	324
	*Please attach additional forms if necessary

4700 000284

### ATTACHMENT 13

PARID	NAME_ALL	OWNER_ADDR	спи	STATE	ZIP	WATER SOURCES
03 B27002600000000	MANI MILDRED; BAUER MILES	1709 BRADYS RIDGE	WELLSBURG	WV	26070	1

Office of Oil and Gas

JUL 3 0 2019

Environmental Protection

WW-6A (8-13)

OPERATOR WELL NO. Mildred Mani BRK 210H Well Pad Name: Mildred Mani BRK

### Notice is hereby given:

Pursuant to West Virginia Code § 22-6A-10(b), notice is hereby given that the undersigned well operator has applied for a permit for well work or for a certificate of approval for the construction of an impoundment or pit.

### This Notice Shall Include:

Pursuant to W. Va. Code § 22-6A-10(b), this notice shall include: (1) copies of the application; (2) the erosion and sediment control plan required by section seven of this article; and (3) the well plat.

Pursuant to W. Va. Code § 22-6A-10(f), this notice shall include: (1) a statement of the time limits for filing written comments; (2) who may file written comments; (3) the name and address of the secretary for the purpose of filing the comments and obtaining additional information; and (4) a statement that the persons may request, at the time of submitting written comments, notice of the permit decision and a list of persons qualified to test water.

Pursuant to W. Va. Code R. § 35-8-5.7.a, the operator shall provide the Well Site Safety Plan to the surface owner and any water purveyor or surface owner subject to notice and water testing as provided in section 15 of this rule.

Pursuant to W. Va. Code R. § 35-8-15.2.c, this notice shall: (1) contain a statement of the surface owner's and water purveyor's right to request sampling and analysis; (2) advise the surface owner and water purveyor of the rebuttable presumption for contamination or deprivation of a fresh water source or supply; advise the surface owner and water purveyor that refusal to allow the operator to conduct a pre-drilling water well test constitutes a method to rebut the presumption of liability; (3) advise the surface owner and water purveyor of his or her independent right to sample and analyze any water supply at his or her own expense; advise the surface owner and water purveyor whether or not the operator will utilize an independent laboratory to analyze any sample; and (4) advise the surface owner and or water purveyor that he or she can obtain from the Chief a list of water testing laboratories in the subject area capable of and qualified to test water supplies in accordance with standard acceptable methods.

Additional information related to horizontal drilling may be obtained from the Secretary, at the WV Department of Environmental and the secretary of the secret Additional information related to horizontal drilling may be obtained from the Secretary, at the wv Department of Education Related to horizontal drilling may be obtained from the Secretary, at the wv Department of Education Related to horizontal drilling may be obtained from the Secretary, at the wv Department of Education Related to horizontal drilling may be obtained from the Secretary, at the wv Department of Education Related to horizontal drilling may be obtained from the Secretary, at the wv Department of Education Related to horizontal drilling may be obtained from the Secretary, at the wv Department of Education Related to horizontal drilling may be obtained from the Secretary Related to horizontal drilling may be obtained from the Secretary Related to horizontal drilling may be obtained from the Secretary Related to horizontal drilling may be obtained from the Secretary Related to horizontal drilling may be obtained from the Secretary Related to horizontal drilling may be obtained from the Secretary Related to horizontal drilling may be obtained from the Secretary Related to horizontal drilling may be obtained from the Secretary Related to horizontal drilling may be obtained from the Secretary Related to horizont

### Well Location Restrictions

WV Department of Pursuant to W. Va. Code § 22-6A-12, Wells may not be drilled within two hundred fifty feet measured horizontally from any existing Frotection water well or developed spring used for human or domestic animal consumption. The center of well pads may not be located within six hundred twenty-five feet of an occupied dwelling structure, or a building two thousand five hundred square feet or larger used to house or shelter dairy cattle or poultry husbandry. This limitation is applicable to those wells, developed springs, dwellings or agricultural buildings that existed on the date a notice to the surface owner of planned entry for surveying or staking as provided in section ten of this article or a notice of intent to drill a horizontal well as provided in subsection (b), section sixteen of this article was provided, whichever occurs first, and to any dwelling under construction prior to that date. This limitation may be waived by written consent of the surface owner transmitted to the department and recorded in the real property records maintained by the clerk of the county commission for the county in which such property is located. Furthermore, the well operator may be granted a variance by the secretary from these distance restrictions upon submission of a plan which identifies the sufficient measures, facilities or practices to be employed during well site construction, drilling and operations. The variance, if granted, shall include terms and conditions the department requires to ensure the safety and protection of affected persons and property. The terms and conditions may include insurance, bonding and indemnification, as well as technical requirements. (b) No well pad may be prepared or well drilled within one hundred feet measured horizontally from any perennial stream, natural or artificial lake, pond or reservoir, or a wetland, or within three hundred feet of a naturally reproducing trout stream. No well pad may be located within one thousand feet of a surface or ground water intake of a public water supply. The distance from the public water supply as identified by the department shall be measured as follows: (1) For a surface water intake on a lake or reservoir, the distance shall be measured from the boundary of the lake or reservoir. (2) For a surface water intake on a flowing stream, the distance shall be measured from a semicircular radius extending upstream of the surface water intake. (3) For a groundwater source, the distance shall be measured from the wellhead or spring. The department may, in its discretion, waive these distance restrictions upon submission of a plan identifying sufficient measures, facilities or practices to be employed during well site construction, drilling and operations to protect the waters of the state. A waiver, if granted, shall impose any permit conditions as the secretary considers necessary. (c) Notwithstanding the foregoing provisions of this section, nothing contained in this section prevents an operator from conducting the activities permitted or authorized by a Clean Water Act Section 404 permit or other approval from the United States Army Corps of Engineers within any waters of the state or within the restricted areas referenced in this section. (d) The well location restrictions set forth in this section shall not apply to any well on a multiple well pad if at least one of the wells was permitted prior to the effective date of this article. (e) The secretary shall, by December 31, 2012, report to the Legislature on the noise, light, dust and volatile organic compounds generated by the drilling of horizontal wells as they relate to the well location restrictions regarding occupied dwelling structures pursuant to this section. Upon a finding, if any, by the secretary that the well location restrictions regarding occupied dwelling structures are inadequate or otherwise require alteration to address the items

API NO. 44-009 U ... 0 0 2 8 4
OPERATOR WELL NO. Mildred Mani BRK 210H
Well Pad Name: Mildred Mani BRK

examined in the study required by this subsection, the secretary shall have the authority to propose for promulgation legislative rules establishing guidelines and procedures regarding reasonable levels of noise, light, dust and volatile organic compounds relating to drilling horizontal wells, including reasonable means of mitigating such factors, if necessary.

### Water Well Testing:

Pursuant to West Virginia Code § 22-6A-10(d), notification shall be made, with respect to surface landowners identified in subsection (b) or water purveyors identified in subdivision (5), subsection (b) of this section, of the opportunity for testing their water well. The operator shall provide an analysis to such surface landowner or water purveyor at their request.

### Water Testing Laboratories:

Pursuant to West Virginia Code § 22-6A-10(i), persons entitled to notice pursuant to subsection (b) of this section may contact the department to ascertain the names and locations of water testing laboratories in the subject area capable and qualified to test water supplies in accordance with standard accepted methods. In compiling that list of names the department shall consult with the state Bureau for Public Health and local health departments. A surface owner and water purveyor has an independent right to sample and analyze any water supply at his or her own expense. The laboratory utilized by the operator shall be approved by the agency as being certified and capable of performing sample analyses in accordance with this section.

### Rebuttable Presumption for Contamination or Deprivation of a Fresh Water Source or Supply:

W. Va. Code § 22-6A-18 requires that (b) unless rebutted by one of the defenses established in subsection (c) of this section, in any action for contamination or deprivation of a fresh water source or supply within one thousand five hundred feet of the center of the well pad for horizontal well, there is a rebuttable presumption that the drilling and the oil or gas well or either was the proximate cause of the contamination or deprivation of the fresh water source or supply. (c) In order to rebut the presumption of liability established in subsection (b) of this section, the operator must prove by a preponderance of the evidence one of the following defenses: (1) The pollution existed prior to the drilling or alteration activity as determined by a predrilling or prealteration water well test. (2) The landowner or water purveyor refused to allow the operator access to the property to conduct a predrilling or prealteration water well test. (3) The water supply is not within one thousand five hundred feet of the well. (4) The pollution occurred more than six months after completion of drilling or alteration activities. (5) The pollution occurred as the result of some cause other than the drilling or alteration activity. (d) Any operator electing to preserve its defenses under subdivision (1), subsection (c) of this section shall retain the services of an independent certified laboratory to conduct the predrilling or prealteration water well test. A copy of the results of the test shall be submitted to the department and the surface owner or water purveyor in a manner prescribed by the secretary. (e) Any operator shall replace the water supply of an owner of interest in real property who obtains all or part of that owner's supply of water for domestic, agricultural, industrial or other legitimate use from an underground or surface source with a comparable water supply where the secretary determines that the water supply has been affected by contamination, diminution or interruption proximately caused by the oil or gas operation, unless waived in writing by that owner. (f) The secretary may order the operator conducting the oil or gas operation to: (1) Provide an emergency drinking water supply within twenty-four hours; (2) Provide temporary water supply within seventy-two hours; (3) Within thirty days begin activities to establish a permanent water supply or submit a proposal to the secretary outlining the measures and timetables to be used in establishing a permanent supply. The total time in providing a permanent water supply may not exceed two years. If the operator demonstrates that providing a permanent replacement water supply cannot be completed within two years, the secretary may extend the time frame on case-by-case basis; and (4) Pay all reasonable costs incurred by the real property owner in securing a water supply. (g) A person as described in subsection (b) of this section aggrieved under the provisions of subsections (b), (e) or (f) of this section may seek relief in court... (i) Notwithstanding the denial of the operator of responsibility for the damage to the real property owner's water supply or the status of any appeal on determination of liability for the damage to the real property owner's water supply, the operator may not discontinue providing the required water service until authorized to do so by the secretary or a court of competent jurisdiction.

### Written Comment:

Pursuant to West Virginia Code § 22-6A-11(a), all persons described in subsection (b), section ten of this article may file written comments with the secretary as to the location or construction of the applicant's proposed well work within thirty days after the application is filed with the secretary. All persons described in West Virginia Code § 22-6A-10(b) may file written comments as to the location or construction of the applicant's proposed well work to the Secretary at:

Office of Oil and Gas

Chief, Office of Oil and Gas
Department of Environmental Protection
601 57<sup>th</sup> St. SE
Charleston, WV 25304
(304) 926-0450

JUL 3 0 2019

WW Department of Environmental Protection

Such persons may request, at the time of submitting written comments, notice of the permit decision and a list of persons qualified to test water. NOTE: YOU ARE NOT REQUIRED TO FILE ANY COMMENT.

WW-6A (8-13) API NO. 47-009 0 0 2 8 4
OPERATOR WELL NO, Midred Mani BRK 210H
Well Pad Name: Mildred Mani BRK

### Time Limits and Methods for Filing Comments.

The law requires these materials to be served on or before the date the operator files its Application. You have **THIRTY (30) DAYS** after the filing date to file your comments. Comments must be filed in person or received in the mail by the Chief's office by the time stated above. You may call the Chief's office to be sure of the date. Check with your postmaster to ensure adequate delivery time or to arrange special expedited handling. If you have been contacted by the well operator and you have signed a "voluntary statement of no objection" to the planned work described in these materials, then the permit may be issued at any time.

Pursuant to West Virginia Code § 22-6A-11(c)(2), Any objections of the affected coal operators and coal seam owners and lessees shall be addressed through the processes and procedures that exist under sections fifteen, seventeen and forty, article six of this chapter, as applicable and as incorporated into this article by section five of this article. The written comments filed by the parties entitled to notice under subdivisions (1), (2), (4), (5) and (6), subsection (b), section ten of this article shall be considered by the secretary in the permit issuance process, but the parties are not entitled to participate in the processes and proceedings that exist under sections fifteen, seventeen or forty, article six of this chapter, as applicable and as incorporated into this article by section five of this article.

### **Comment Requirements**

Your comments must be in writing and include your name, address and telephone number, the well operator's name and well number and the approximate location of the proposed well site including district and county from the application. You may add other documents, such as sketches, maps or photographs to support your comments.

Disclaimer: All comments received will be placed on our web site <a href="http://www.dep.wv.gov/oil-and-gas/Horizontal-Permits/Pages/default.aspx">http://www.dep.wv.gov/oil-and-gas/Horizontal-Permits/Pages/default.aspx</a> and the applicant will automatically be forwarded an email notice that such comments have been submitted. The applicant will be expected to provide a response to comments submitted by any surface owner, water purveyor or natural gas storage operator noticed within the application.

### Permit Denial or Condition

The Chief has the power to deny or condition a well work permit. Pursuant to West Virginia Code § 22-6A-8(d), the permit may not be issued or be conditioned, including conditions with respect to the location of the well and access roads prior to issuance if the director determines that:

- (1) The proposed well work will constitute a hazard to the safety of persons;
- (2) The plan for soil erosion and sediment control is not adequate or effective;
- (3) Damage would occur to publicly owned lands or resources; or
- (4) The proposed well work fails to protect fresh water sources or supplies.

A permit may also be denied under West Virginia Code § 22-6A-7(k), the secretary shall deny the issuance of a permit if the secretary determines that the applicant has committed a substantial violation of a previously issued permit for a horizontal well, including the applicable erosion and sediment control plan associated with the previously issued permit, or a substantial violation of one or more of the rules promulgated under this article, and in each instance has failed to abate or seek review of the violation within the time prescribed by the secretary pursuant to the provisions of subdivisions (1) and (2), subsection (a), section five of this article and the rules promulgated hereunder, which time may not be unreasonable.

Pursuant to West Virginia Code § 22-6A-10(g), any person entitled to submit written comments to the secretary pursuant to subsection (a), section eleven of this article, shall also be entitled to receive from the secretary a copy of the permit as issued or a copy of the order modifying or denying the permit if the person requests receipt of them as a part of the written comments submitted concerning the permit application. Such persons may request, at the time of submitting written comments, notice of the permit decision and a list of persons qualified to test water.

Office of Cil and Gas

WV Department of Environmental Protection WW-6A (8-13) API NO. 47-009 OPERATOR WELL NO. Mildred Mani BRK 210H
Well Pad Name: Mildred Mani BRK

Notice is hereby given by:

Well Operator: SWN Production Co., LLC

Telephone: \_304-884-1610 Email: Brittany\_Woody@swn.com

vn.com

Address: 1300 Fort Pierpont Dr., Suite 201

Morgantown, WV 26508

Facsimile: 304-884-1690

### Oil and Gas Privacy Notice:

The Office of Oil and Gas processes your personal information, such as name, address and telephone number, as part of our regulatory duties. Your personal information may be disclosed to other State agencies or third parties in the normal course of business or as needed to comply with statutory or regulatory requirements, including Freedom of Information Act requests. Our office will appropriately secure your personal information. If you have any questions about our use or your personal information, please contact DEP's Chief Privacy Officer at <a href="mailto:deprivacyofficer@wv.gov">deprivacyofficer@wv.gov</a>.

Official Seal
Notary Public, State Of West Virginia
Elizabeth Blankenship
941 Simpson Run Road
Weston WV 26452
My commission expires June 23, 2024

Subscribed and sworn before me this 24 day of June 2019.


Notary Public

My Commission Expires

Office of Oil and Gas

JUL 3 0 2019

Environmental Protection

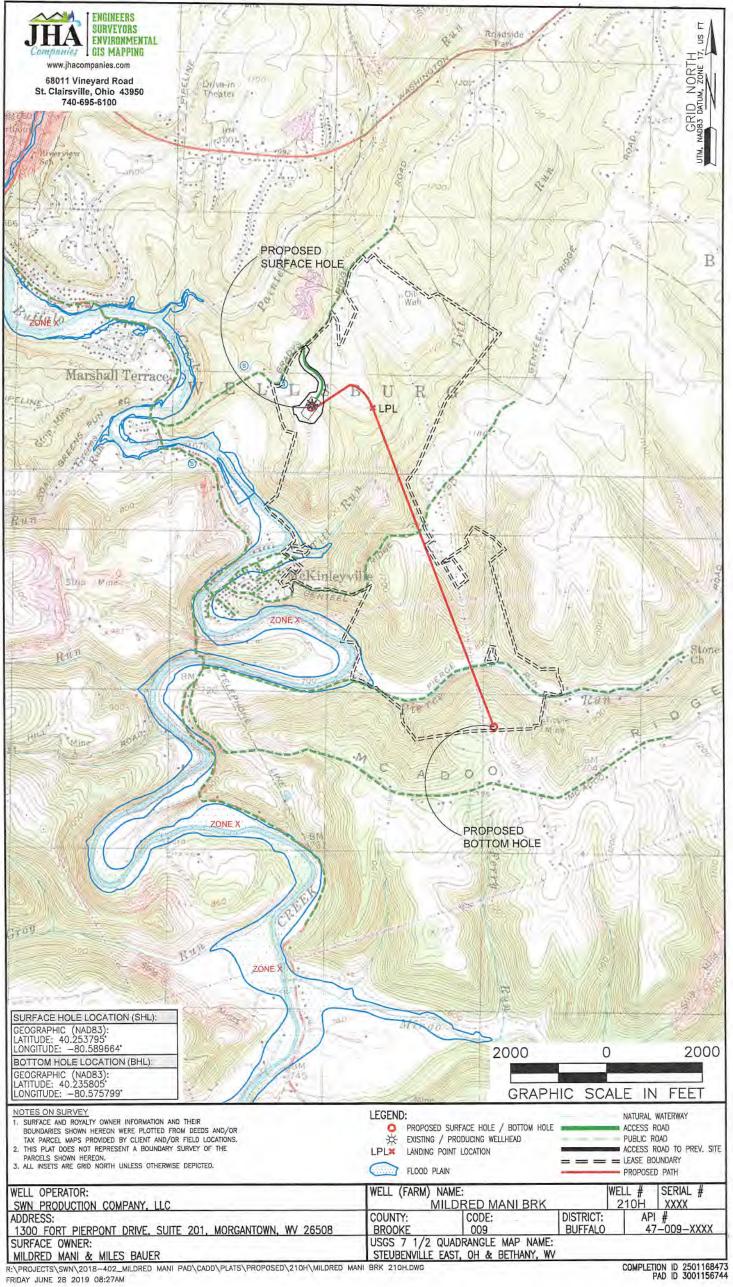

### STATE OF WEST VIRGINIA DEPARTMENT OF ENVIRONMENTAL PROTECTION, OFFICE OF OIL AND GAS NOTICE OF ENTRY FOR PLAT SURVEY

Notice entry	Time Require	ment: N	otice shall be prov	ided at least	SEVEN (7) da	ys but no more tha	n FORTY-FIV	E (45) days prior to	
	f Notice: 6/3/201	19	Date of Plan	nned Entry:	6/10/2019				
Delive	ry method pur	suant to	West Virginia C	ode § 22-6A-	10a				
Пр	ERSONAL		REGISTERED	Пмет	HOD OF DE	LIVERY THAT RE	FOLIRES A		
	ERVICE		MAIL			NATURE CONFIR			
Durena	nt to West Viro	inia Cod	a 8 22-64-10(a) F	Prior to filing	a nermit annli	cation the operator	chall provide r	otice of planned entry	
on to to but no beneat owner and Se Secreta enable	he surface tract more than forty h such tract that of minerals und diment Control ary, which state	to condu y-five day has filed lerlying s Manual ment sha ner to obt	ct any plat surveys ys prior to such end d a declaration pur- such tract in the co and the statutes an Il include contact tain copies from the	s required purity to: (1) The suant to section unty tax record d rules related information, is	suant to this a e surface owner on thirty-six, a rds. The notice d to oil and ga	rticle. Such notice s or of such tract; (2) rticle six, chapter t e shall include a sta	shall be provide to any owner or wenty-two of thatement that cop roduction may	d at least seven days lessee of coal seams his code; and (3) any lies of the state Erosion be obtained from the	
	JRFACE OWN				□ COA	L OWNER OR LE	CCFF		
	Mildred Mani	LIC(S)			- 001.	rvaggi Industries, Inc.	OSEL		
	S: 1709 Bradys Rid	ge Road		- 0	The second secon	401 Pennsylvania Ave			
	g, WV 26070			-	Weirton, WV 26062 Dec RECEIV				
Name:	Erik P. Bauer	-		-	-			Office of Oil and Gas	
	S: 15475 Southeast	36th Ave			I MIN	ERAL OWNER(s)		1111 00	
Summerfi	ield, FL 34491			3	Name: Mil	dred Mani		JUL 3 0 2019	
Name:				<u>-</u>		709 Bradys Ridge Road		WV Department of Environmental Protection	
Addres	s:				Wellsburg, W			Environmental Project	
					*please attac	h additional forms if ne	cessary	otection	
Pursua	wv Brooke Buffalo	inia Code ect of lane				ude & Longitude: Access:	operator is plan 40.253845, -80.589 Bradys Ridge Road Lower Buffalo Creek Mildred Mani		
nay be Charles obtaine Notice Well O	obtained from ston, WV 2530d from the Secretis hereby gives perator: SWN PE	the Secret 4 (304-92) etary by en by: RODUCTION	tary, at the WV D	epartment of of such docur	Environmenta ments or addit nd-gas/pages/o Address:	l Protection headqu onal information re	arters, located a elated to horizon	ration and production at 601 57 <sup>th</sup> Street, SE, ntal drilling may be	
Email:	Brittany	_Woody@sv	/n.com		Facsimile:	304-884-1690			
2.1	d Cas Prissan	NT 4*						7	

Oil and Gas Privacy Notice:

The Office of Oil and Gas processes your personal information, such as name, address and telephone number, as part of our regulatory duties. Your personal information may be disclosed to other State agencies or third parties in the normal course of business or as needed to comply with statutory or regulatory requirements, including Freedom of Information Act requests. Our office will appropriately secure your personal information. If you have any questions about our use or your personal information, please contact DEP's Chief Privacy Officer at depprivacyofficer@wv.gov.

# STATE OF WEST VIRGINIA DEPARTMENT OF ENVIRONMENTAL PROTECTION, OFFICE OF OIL AND GAS NOTICE OF ENTRY FOR PLAT SURVEY

	Requirement:	Notice shall be prov	ided at least SEVEN (7) day	s but no more tha	n FORTY-FIV	E (45) days prior to	
entry Date of Notic	ce: 6/3/2019	Date of Plan	ned Entry:				
Delivery me	hod pursuant	to West Virginia C	ode § 22-6A-10a				
☐ PERSO	NAI.	REGISTERED	☐ METHOD OF DELI	IVERY THAT RE	EOUIRES A		
SERVIC		MAIL	RECEIPT OR SIGN				
on to the surfibut no more to beneath such owner of min and Sediment Secretary, whenable the sur	ace tract to cond han forty-five d tract that has fil erals underlying Control Manua ich statement sl face owner to o	duct any plat surveys ays prior to such end ed a declaration pur- g such tract in the co all and the statutes an hall include contact obtain copies from the	rior to filing a permit application required pursuant to this article to:  (1) The surface owner suant to section thirty-six, article tax records. The notice of rules related to oil and gas information, including the address secretary.	of such notice s of such tract; (2) ticle six, chapter to shall include a sta exploration and p	shall be provide to any owner or wenty-two of that tement that cop roduction may	ed at least seven days r lessee of coal seams nis code; and (3) any pies of the state Erosion be obtained from the	
	eby provided to	0:	Посит	000 ID 00 I E	CORR		
	CE OWNER(s)			OWNER OR LE			
Name: Erik P.B	auer 5 Southeast 36th Ave		Name:				
Address: 1547 Summerfield, FL 3			Address: _				
The second second							
Address:			■ MINE	RAL OWNER(s)			
			Name: Erik	P.Bauer		Office of Oil and Gas	
Name:				5475 Southeast 36th Ave		Office of Oil and Gas	
Address:				Summerfield, FL 34491 *please attach additional forms if necessary			
			*please attach	additional forms if ne	cessary	JUL 3 0 2019	
Notice is he Pursuant to W a plat survey State: County: District:	reby given: Vest Virginia Coon the tract of la WW Brooke Buffalo	ode § 22-6A-10(a), n and as follows:	otice is hereby given that the Approx. Latitu Public Road A Watershed:	de & Longitude:		9673	
Quadrangle:	Stuebenville East		Generally used	farm name:	Mildred Mani		
may be obtain	ned from the Sec VV 25304 (304-	cretary, at the WV D -926-0450). Copies	Manual and the statutes and epartment of Environmental of such documents or additional wv.gov/oil-and-gas/pages/documents	Protection headquonal information re	uarters, located	at 601 57th Street, SE,	
	the Secretary t						
obtained from	reby given by	:					
Notice is he Well Operator	reby given by	: TON COMPANY, LLC	Address:	1300 Fort Pierpont Dr.,	Suite 201		
obtained from	reby given by		Address:	1300 Fort Pierpont Dr., 3 Morgantown, WV 26508			

Oil and Gas Privacy Notice:

The Office of Oil and Gas processes your personal information, such as name, address and telephone number, as part of our regulatory duties. Your personal information may be disclosed to other State agencies or third parties in the normal course of business or as needed to comply with statutory or regulatory requirements, including Freedom of Information Act requests. Our office will appropriately secure your personal information. If you have any questions about our use or your personal information, please contact DEP's Chief Privacy Officer at depprivacyofficer@wv.gov.

# STATE OF WEST VIRGINIA DEPARTMENT OF ENVIRONMENTAL PROTECTION, OFFICE OF OIL AND GAS NOTICE OF INTENT TO DRILL

Pursuant to W. Va. Code § 22-6A-16(b), the Notice of Intent to Drill is only required if the notice requirements of W. Va. Code § 22-6A-10(a) have NOT been met or if the Notice of Intent to Drill requirement has NOT been waived in writing by the surface owner.

Notice Time I Date of Notic	Requirement: Notice shall be provided at ee: 06/12/2019 Date Per	t least TEN (10) days prior to filing a mit Application Filed:	permit application.	
Delivery met	hod pursuant to West Virginia Code § 2	22-6A-16(b)		
☐ HAND DELIVE	CERTIFIED MAIL RY RETURN RECEIPT REC	QUESTED		
receipt reques drilling a hori of this subsect subsection ma and if availab	V. Va. Code § 22-6A-16(b), at least ten da ted or hand delivery, give the surface own zontal well: <i>Provided</i> , That notice given tion as of the date the notice was provided by be waived in writing by the surface own le, facsimile number and electronic mail a reby provided to the SURFACE OV	ner notice of its intent to enter upon the pursuant to subsection (a), section tend to the surface owner: <i>Provided, how</i> ner. The notice, if required, shall includdress of the operator and the operator	e surface owner's land to n of this article satisfies ever, That the notice reduce the name, address, to	for the purpose of the requirements quirements of this elephone number,
Name: Mildred M		Name:		
Address: 1709	Bradys Ridge Road	Address:		
Wellsburg, WV 26	5070			-
the surface ov State: County: District: Quadrangle:	/est Virginia Code § 22-6A-16(b), notice vner's land for the purpose of drilling a howest Virginia  Brooke  Buffalo  Steubenville East, OH/Bethany, WV			Office of Oil -
Pursuant to V facsimile nun related to hor	Shall Include: West Virginia Code § 22-6A-16(b), this other and electronic mail address of the rizontal drilling may be obtained from the 157th Street, SE, Charleston, WV 25304 (	e Secretary, at the WV Department of	f Environmental Protect	tion headquarters,
	reby given by: r: SWN Production Company, LLC	Authorized Representative:	Mike Yates	
Address:	1300 Fort Pierpont Dr., Suite 201	Address;	1300 Fort Pierpont Dr., Suit	te 201
	Morgantown, WV 26508		Morgantown, WV 26508	
Telephone:	304-517-6603	Telephone:	304-517-6603	
Email:	Michael_Yates@swn.com	Email:	Michael_Yates@swn.com	
Facsimile:	304-884-1691	Facsimile:	304-884-1691	
			-	

### Oil and Gas Privacy Notice:

The Office of Oil and Gas processes your personal information, such as name, address and telephone number, as part of our regulatory duties. Your personal information may be disclosed to other State agencies or third parties in the normal course of business or as needed to comply with statutory or regulatory requirements, including Freedom of Information Act requests. Our office will appropriately secure your personal information. If you have any questions about our use or your personal information, please contact DEP's Chief Privacy Officer at <a href="mailto:deprivacyofficer@wv.gov">deprivacyofficer@wv.gov</a>.

# STATE OF WEST VIRGINIA DEPARTMENT OF ENVIRONMENTAL PROTECTION, OFFICE OF OIL AND GAS NOTICE OF INTENT TO DRILL

Pursuant to W. Va. Code § 22-6A-16(b), the Notice of Intent to Drill is only required if the notice requirements of W. Va. Code § 22-6A-10(a) have NOT been met or if the Notice of Intent to Drill requirement has NOT been waived in writing by the surface owner.

Date of Notice		least TEN (10) days prior to filing a mit Application Filed:	permit application.
Delivery meth	nod pursuant to West Virginia Code § 2	22-6A-16(b)	
☐ HAND	■ CERTIFIED MAIL		
DELIVE		DUESTED	
DELLYE	KI KETOKIV KECELI I KEQ	(0131111)	
receipt request drilling a horiz of this subsect subsection ma and if available	ted or hand delivery, give the surface own zontal well: <i>Provided</i> , That notice given ion as of the date the notice was provided y be waived in writing by the surface own e, facsimile number and electronic mail as	ner notice of its intent to enter upon the pursuant to subsection (a), section to to the surface owner: <i>Provided, hower.</i> The notice, if required, shall includers of the operator and the operator	an operator shall, by certified mail return the surface owner's land for the purpose of an of this article satisfies the requirements bever, That the notice requirements of this aude the name, address, telephone number, r's authorized representative.
Nouce is ner Name: Erik P. Ba	eby provided to the SURFACE OW	Name:	
Address: 15475		Address:	
Summerfield, FL 3		Address.	
the surface ow	ner's land for the purpose of drilling a ho	rizontal well on the tract of land as fo	
the surface ow State: County:			
the surface ow State: County: District:	rner's land for the purpose of drilling a ho West Virginia Brooke	rizontal well on the tract of land as fo  UTM NAD 83  Easting: Northing:	Ilows: 534,896.15 4,456,007.38
	ner's land for the purpose of drilling a ho West Virginia Brooke Buffalo	rizontal well on the tract of land as fo  UTM NAD 83  Easting: Northing: Public Road Access:	Ilows: 534,896.15 4,456,007.38 Bradys Ridge Road
the surface ow State: County: District: Quadrangle: Watershed: This Notice Pursuant to W facsimile num	mer's land for the purpose of drilling a howest Virginia  Brooke  Buffalo  Steubenville East, OH/Bethany, WV  Upper Ohio South  Shall Include: West Virginia Code § 22-6A-16(b), this aber and electronic mail address of the dizontal drilling may be obtained from the	rizontal well on the tract of land as for the control of land as for lan	Illows: 534,896.15 4,456,007.38 Bradys Ridge Road Mildred Mani UP BRK  ress, telephone number, and if available, ed representative. Additional information of Environmental Protection headquarters,
the surface ow State: County: District: Quadrangle: Watershed: This Notice Pursuant to W facsimile num related to hori located at 601	rner's land for the purpose of drilling a how West Virginia  Brooke  Buffalo  Steubenville East, OH/Bethany, WV  Upper Ohio South  Shall Include: West Virginia Code § 22-6A-16(b), this aber and electronic mail address of the object of the company of the company of the step of the step of the company of th	rizontal well on the tract of land as for the control of land as for lan	Illows: 534,896.15 4,456,007.38 Bradys Ridge Road Mildred Mani UP BRK  ress, telephone number, and if available, ed representative. Additional information of Environmental Protection headquarters, property and cost/pages/default aspy
the surface ow State: County: District: Quadrangle: Watershed: This Notice Pursuant to W facsimile num related to hori located at 601	mer's land for the purpose of drilling a howest Virginia  Brooke  Buffalo  Steubenville East, OH/Bethany, WV  Upper Ohio South  Shall Include: West Virginia Code § 22-6A-16(b), this aber and electronic mail address of the dizontal drilling may be obtained from the	rizontal well on the tract of land as for the control of land as for lan	Illows: 534,896.15 4,456,007.38  Bradys Ridge Road  Mildred Mani UP BRK  ress, telephone number, and if available, and representative. Additional information of Environmental Protection headquarters, ap.wv.gov/oil-and-gas/pages/default.aspx.  Office of Oil and Ga
the surface ow State: County: District: Quadrangle: Watershed: This Notice: Pursuant to W facsimile num related to hori located at 601 Notice is her Well Operator	rner's land for the purpose of drilling a ho West Virginia Brooke Buffalo Steubenville East, OH/Bethany, WV Upper Ohio South  Shall Include: West Virginia Code § 22-6A-16(b), this aber and electronic mail address of the object of the control of the steel of the ste	rizontal well on the tract of land as for Easting:  UTM NAD 83 Easting: Northing: Public Road Access: Generally used farm name:  notice shall include the name, addresses authorize experience and the operator's authorize experience at the WV Department of 304-926-0450) or by visiting www.de	Illows: 534,896.15  4,456,007.38  Bradys Ridge Road  Mildred Mani UP BRK  ress, telephone number, and if available, ed representative. Additional information ff Environmental Protection headquarters, ep.wv.gov/oil-and-gas/pages/default.aspx.  Office of Oil and Gallery a
the surface ow State: County: District: Quadrangle: Watershed: This Notice: Pursuant to W facsimile num related to hori located at 601 Notice is her Well Operator	rner's land for the purpose of drilling a ho West Virginia  Brooke  Buffalo  Steubenville East, OH/Bethany, WV  Upper Ohio South  Shall Include: West Virginia Code § 22-6A-16(b), this aber and electronic mail address of the of izontal drilling may be obtained from the 57 <sup>th</sup> Street, SE, Charleston, WV 25304 (2)  reby given by:	rizontal well on the tract of land as for Easting:  UTM NAD 83 Easting: Northing: Public Road Access: Generally used farm name:  notice shall include the name, addresperator and the operator's authorize escretary, at the WV Department of 304-926-0450) or by visiting www.defauthorized Representative:	Illows: 534,896.15  4,456,007.38  Bradys Ridge Road  Mildred Mani UP BRK  ress, telephone number, and if available, ed representative. Additional information of Environmental Protection headquarters, ep.wv.gov/oil-and-gas/pages/default.aspx.  Office of Oil and Ga
the surface ow State: County: District: Quadrangle: Watershed: This Notice Pursuant to W facsimile num related to hori located at 601	rner's land for the purpose of drilling a ho West Virginia  Brooke  Buffalo  Steubenville East, OH/Bethany, WV  Upper Ohio South  Shall Include: Vest Virginia Code § 22-6A-16(b), this aber and electronic mail address of the of izontal drilling may be obtained from the 57 <sup>th</sup> Street, SE, Charleston, WV 25304 (c)  reby given by:  SWN Production Company, LLC  1300 Fort Pierpont Dr., Suite 201	rizontal well on the tract of land as for Easting:  UTM NAD 83 Easting: Northing: Public Road Access: Generally used farm name:  notice shall include the name, addresperator and the operator's authorize escretary, at the WV Department of 304-926-0450) or by visiting www.defauthorized Representative:	Illows: 534,896.15  4,456,007.38  Bradys Ridge Road  Mildred Mani UP BRK  ress, telephone number, and if available, ed representative. Additional information ff Environmental Protection headquarters, ep.wv.gov/oil-and-gas/pages/default.aspx.  Office of Oil and Gallery a
the surface ow State: County: District: Quadrangle: Watershed: This Notice Pursuant to W facsimile num related to hori located at 601 Notice is her Well Operator Address:	rner's land for the purpose of drilling a ho West Virginia  Brooke  Buffalo  Steubenville East, OH/Bethany, WV Upper Ohio South  Shall Include: Vest Virginia Code § 22-6A-16(b), this aber and electronic mail address of the o izontal drilling may be obtained from the 57 <sup>th</sup> Street, SE, Charleston, WV 25304 (Company)  Teby given by:  SWN Production Company, LLC  1300 Fort Pierpont Dr., Suite 201 Morgantown, WV 26508	rizontal well on the tract of land as for Easting:	Blows: 534,896.15 4,456,007.38 Bradys Ridge Road Mildred Mani UP BRK  ress, telephone number, and if available, and representative. Additional information of Environmental Protection headquarters, app.wv.gov/oil-and-gas/pages/default.aspx.  Office of Oil and Ga

### Oil and Gas Privacy Notice:


The Office of Oil and Gas processes your personal information, such as name, address and telephone number, as part of our regulatory duties. Your personal information may be disclosed to other State agencies or third parties in the normal course of business or as needed to comply with statutory or regulatory requirements, including Freedom of Information Act requests. Our office will appropriately secure your personal information. If you have any questions about our use or your personal information, please contact DEP's Chief Privacy Officer at <a href="mailto:deprivacyofficer@wv.gov">deprivacyofficer@wv.gov</a>.

### Operator Well No. Madred Man BRK 270H 8 4

# STATE OF WEST VIRGINIA DEPARTMENT OF ENVIRONMENTAL PROTECTION, OFFICE OF OIL AND GAS NOTICE OF PLANNED OPERATION

Pursuant to Voperation or State: County: District: Quadrangle: Watershed: This Notice Pursuant to Voto be provide horizontal wourface affectinformation	West Virginia Code § 22-6A-16(c), not the surface owner's land for the purp West Virginia  Brooke  Buffalo  Steubenville East, OH/Bethany, WV  Upper Ohio South  Shall Include: West Virginia Code § 22-6A-16(c), the deby W. Va. Code § 22-6A-10(b) tell; and (3) A proposed surface use a sted by oil and gas operations to the related to horizontal drilling may be located at 601 57th Street, SE, fault.aspx.	Public Road Generally use  nis notice shall include: (I to a surface owner whose and compensation agreeme extent the damages are controlled to the controlled to the compensation agreement the damages are controlled to the contro	A copy of this e land will be und containing an ompensable und tary, at the WV (304-926-0450)  1300 Fort Pierpont I Morgantown, WV 26	ct of land as for 534,896.15 4,456,007.38  Bradys Ridge Ros Mildred Mani BRK  code section; (ased in conjunt offer of comper article six-b Department of the conjunt of the	(2) The information required action with the drilling of a pensation for damages to the profession of this chapter. Additional of Environmental Protection
Pursuant to Voperation or State: County: District: Quadrangle: Watershed:  This Notice Pursuant to Voto be provide horizontal we surface affect information headquarters gas/pages/de  Well Operator Telephone:	West Virginia Code § 22-6A-16(c), not the surface owner's land for the purpose buffalo  Steubenville East, OH/Bethany, WV Upper Ohio South  Shall Include: West Virginia Code § 22-6A-16(c), the deby W. Va. Code § 22-6A-10(b) tell; and (3) A proposed surface use a sted by oil and gas operations to the related to horizontal drilling may be located at 601 57th Street, SE, fault.aspx.  Dr: SWN Production Company, LLC 304-517-6603	Public Road Generally use  his notice shall include: (I to a surface owner whose and compensation agreeme extent the damages are contained from the Secret Charleston, WV 25304  Address:	A well on the tra Easting: Northing: Access: ed farm name:  A copy of this e land will be unt containing an ompensable undtary, at the WV (304-926-0450)  1300 Fort Pierpont I Morgantown, W 26	ct of land as for 534,896.15 4,456,007.38  Bradys Ridge Ros Mildred Mani BRK  code section; (ased in conjunt offer of comper article six-b Department of the conjunt of the	2) The information required action with the drilling of a pensation for damages to the coof this chapter. Additional of Environmental Protection www.dep.wv.gov/oil-and-Office of Oil and Gas
Pursuant to Voperation or State: County: District: Quadrangle: Watershed: This Notice Pursuant to Voto be provide horizontal wasurface affect information headquarters gas/pages/de Well Operate	West Virginia Code § 22-6A-16(c), no the surface owner's land for the purp West Virginia  Brooke  Buffalo  Steubenville East, OH/Bethany, WV  Upper Ohio South  Shall Include: West Virginia Code § 22-6A-16(c), the de by W. Va. Code § 22-6A-10(b) tell; and (3) A proposed surface use a sted by oil and gas operations to the related to horizontal drilling may be located at 601 57th Street, SE, fault.aspx.  Dr: SWN Production Company, LLC	Public Road Generally use  nis notice shall include: (I to a surface owner whose and compensation agreeme extent the damages are ce obtained from the Secret Charleston, WV 25304	A well on the tra Easting: Northing: Access: ed farm name:  A copy of this e land will be unt containing an ompensable und tary, at the WV (304-926-0450)	ct of land as for 534,896.15 4,456,007.38 Bradys Ridge Ros Mildred Mani BRK  code section; (ased in conjunt offer of comper article six-bet or by visiting	2) The information required action with the drilling of a pensation for damages to the coof this chapter. Additional of Environmental Protection www.dep.wv.gov/oil-and-Office of Oil and Gas
Pursuant to Voperation or State: County: District: Quadrangle: Watershed: This Notice Pursuant to Voto be provide horizontal wourface affect information headquarters gas/pages/de	West Virginia Code § 22-6A-16(c), not the surface owner's land for the purp West Virginia  Brooke  Buffalo  Steubenville East, OH/Bethany, WV  Upper Ohio South  Shall Include: West Virginia Code § 22-6A-16(c), the deby W. Va. Code § 22-6A-10(b) tell; and (3) A proposed surface use a sted by oil and gas operations to the related to horizontal drilling may be located at 601 57th Street, SE, fault.aspx.	Public Road Generally use  nis notice shall include: (I to a surface owner whose and compensation agreeme extent the damages are ce obtained from the Secret Charleston, WV 25304	A copy of this e land will be und containing and compensable und tary, at the WV	ct of land as for 534,896.15  4,456,007.38  Bradys Ridge Roa Mildred Mani BRK  code section; (ased in conjunt offer of comper article six-b Department of	2) The information required action with the drilling of a pensation for damages to the coof this chapter. Additional of Environmental Protection www.dep.wv.gov/oil-and-Office of Oil and Gas
Pursuant to Voperation or State: County: District: Quadrangle:	West Virginia Code § 22-6A-16(c), not the surface owner's land for the purp West Virginia  Brooke  Buffalo  Steubenville East, OH/Bethany, WV	pose of drilling a horizonta  UTM NAD 8  Public Road	If well on the tra Easting: Northing: Access:	ot of land as for 534,896.15 4,456,007.38 Bradys Ridge Roa	ollows:
Pursuant to Voperation or State: County: District:	West Virginia Code § 22-6A-16(c), not the surface owner's land for the purp West Virginia  Brooke  Buffalo	pose of drilling a horizonta  UTM NAD 8  Public Road	If well on the tra Easting: Northing: Access:	ot of land as for 534,896.15 4,456,007.38 Bradys Ridge Roa	ollows:
Pursuant to Voperation or State: County:	West Virginia Code § 22-6A-16(c), no the surface owner's land for the purp West Virginia Brooke	pose of drilling a horizonta UTM NAD 8	If well on the tra Easting: Northing:	ct of land as fo 534,896.15 4,456,007.38	ollows:
Pursuant to Voperation or State:	West Virginia Code § 22-6A-16(c), no the surface owner's land for the purp	pose of drilling a horizonta	I well on the tra Easting:	ct of land as fo	
Notice to 1	reby given:				
Wellsburg, WV 2	6070	· ·			
(at the addre Name: Mildred	reby provided to the SURFACE OV ss listed in the records of the sheriff a Mani 9 Bradys Ridge Road		s:		
return receip the planned required to b drilling of a damages to t	W. Va. Code § 22-6A-16(c), no later t requested or hand delivery, give the operation. The notice required by the e provided by subsection (b), section horizontal well; and (3) A proposed the surface affected by oil and gas operates required by this section shall be given	e surface owner whose land this subsection shall inclu- ten of this article to a surfall I surface use and compense erations to the extent the day	d will be used for de: (1) A copy ace owner whost sation agreement amages are com	or the drilling of of this code see land will be t containing a pensable under	of a horizontal well notice of section; (2) The information used in conjunction with the n offer of compensation for r article six-b of this chapter.
RETU	RN RECEIPT REQUESTED	DELIVERY			
	IFIED MAIL	☐ HAND			
	thod pursuant to West Virginia Co	ode § 22-6A-16(c)			
Delivery me					
Date of Not		nit Application Filed:	10011		

The Office of Oil and Gas processes your personal information, such as name, address and telephone number, as part of our regulatory duties. Your personal information may be disclosed to other State agencies or third parties in the normal course of business or as needed to comply with statutory or regulatory requirements, including Freedom of Information Act requests. Our office will appropriately secure your personal information. If you have any questions about our use or your personal information, please contact DEP's Chief Privacy Officer at <a href="mailto:deprivacyofficer@wv.gov">deprivacyofficer@wv.gov</a>.

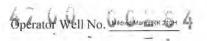

### STATE OF WEST VIRGINIA DEPARTMENT OF ENVIRONMENTAL PROTECTION, OFFICE OF OIL AND GAS NOTICE OF PLANNED OPERATION

operation on State: County: District: Quadrangle: Watershed: This Notice S Pursuant to W to be provide horizontal we surface affect	dest Virginia Code § 22-6A-16(c), in the surface owner's land for the purity west Virginia  Brooke  Buffalo  Steubenville East, OH/Bethany, WV  Upper Ohio South  Shall Include:  Vest Virginia Code § 22-6A-16(c), and by W. Va. Code § 22-6A-10(b)  Il; and (3) A proposed surface use ed by oil and gas operations to the elated to horizontal drilling may be located at 601 57th Street, SE, sault.aspx.	this notice shall include: (1 to a surface owner whose and compensation agreeme e extent the damages are cope obtained from the Secre Charleston, WV 25304  Address:	Easting: Northing: Access: ed farm name:  OA copy of this e land will be int containing an ompensable uncary, at the WV	534,896.15  4,456,007.38  Bradys Ridge Road  Mildred Mani BRK  code section; (2) The information required used in conjunction with the drilling of an offer of compensation for damages to the der article six-b of this chapter. Additional Department of Environmental Protection or by visiting www.dep.wv.gov/oil-and-Dr., Suite 201
Pursuant to Webperation on State: County: District: Quadrangle: Watershed: This Notice Sepursuant to Webperation of the provide horizontal websurface affect information reheadquarters, gas/pages/def	dest Virginia Code § 22-6A-16(c), in the surface owner's land for the purity west Virginia  Brooke  Buffalo  Steubenville East, OH/Bethany, WV  Upper Ohio South  Shall Include:  Vest Virginia Code § 22-6A-16(c), and by W. Va. Code § 22-6A-10(b)  Il; and (3) A proposed surface use ed by oil and gas operations to the elated to horizontal drilling may be located at 601 57th Street, SE, sault.aspx.	this notice shall include: (1) to a surface owner whose and compensation agreeme e extent the damages are cope obtained from the Secre Charleston, WV 25304	Hell on the tra Easting: Northing: Access: ed farm name:  A copy of this e land will be not containing an ompensable unclary, at the WV (304-926-0450)	act of land as follows:  534,896.15  4,456,007.38  Bradys Ridge Road  Mildred Mani BRK   code section; (2) The information required used in conjunction with the drilling of an offer of compensation for damages to the der article six-b of this chapter. Additional Department of Environmental Protection or by visiting www.dep.wv.gov/oil-and-Dr., Suite 201
Pursuant to Webperation on State: County: District: Quadrangle: Watershed:  This Notice Sepursuant to Webperovide thorizontal websurface affect information readquarters,	dest Virginia Code § 22-6A-16(c), ithe surface owner's land for the pure West Virginia  Brooke  Buffalo  Steubenville East, OH/Bethany, WV  Upper Ohio South  Shall Include:  Vest Virginia Code § 22-6A-16(c), id by W. Va. Code § 22-6A-10(b)  Il; and (3) A proposed surface use ed by oil and gas operations to the elated to horizontal drilling may be located at 601 57th Street, SE,	rpose of drilling a horizonta  UTM NAD 8  Public Road Generally use  this notice shall include: (1 to a surface owner whose and compensation agreeme e extent the damages are cope obtained from the Secre	Easting: Northing: Access: ed farm name:  OA copy of this e land will be int containing an ompensable uncary, at the WV	act of land as follows:  534,896,15  4,456,007,38  Bradys Ridge Road  Mildred Mani BRK   code section; (2) The information required used in conjunction with the drilling of an offer of compensation for damages to the der article six-b of this chapter. Additional Department of Environmental Protection
Pursuant to Woperation on State: County: District: Quadrangle:	dest Virginia Code § 22-6A-16(c), in the surface owner's land for the pure West Virginia  Brooke  Buffalo  Steubenville East, OH/Bethany, WV	rpose of drilling a horizonta UTM NAD 8 Public Road	I well on the tra Easting: Northing: Access:	tet of land as follows: 534,896.15 4,456,007.38 Bradys Ridge Road
Pursuant to Woperation on State: County: District:	est Virginia Code § 22-6A-16(c), i the surface owner's land for the pu West Virginia Brooke Buffalo	rpose of drilling a horizonta UTM NAD 8 Public Road	I well on the tra Easting: Northing: Access:	tet of land as follows: 534,896.15 4,456,007.38 Bradys Ridge Road
Pursuant to Woperation on State: County:	est Virginia Code § 22-6A-16(c), i the surface owner's land for the pu West Virginia Brooke	rpose of drilling a horizonta UTM NAD 8	I well on the tra Easting: Northing:	act of land as follows: 534,896,15 4,456,007.38
Pursuant to Woperation on State:	est Virginia Code § 22-6A-16(c), the surface owner's land for the pu West Virginia	rpose of drilling a horizonta	I well on the tra Easting:	act of land as follows: 534,896,15
Pursuant to Woperation on	est Virginia Code § 22-6A-16(c), the surface owner's land for the pu	rpose of drilling a horizonta	I well on the tra	act of land as follows:
Summerned, FL	4401-4720	-		
Address: 1547 Summerfield, FL 3		Addres		
at the address Name: Erik P. B		at the time of notice): Name:		
return receipt the planned of required to be drilling of a l damages to th (d) The notice of notice.	requested or hand delivery, give the peration. The notice required by provided by subsection (b), section norizontal well; and (3) A propose e surface affected by oil and gas ones required by this section shall be a	ne surface owner whose land this subsection shall inclu in ten of this article to a surf ed surface use and compens perations to the extent the da given to the surface owner a	I will be used for de: (1) A copy ace owner whost sation agreement amages are com	or the drilling of a horizontal well notice of of this code section; (2) The information see land will be used in conjunction with the at containing an offer of compensation for pensable under article six-b of this chapter sted in the records of the sheriff at the time
		er than the date for filing t	he nermit annli	cation, an operator shall, by certified mai
	FIED MAIL RN RECEIPT REQUESTED	☐ HAND DELIVERY		
	nou parsume to west vinginia c	ode § 22-0A-10(c)		
Denvery med		ada \$ 22 64 16(a)		
Delivery met	hod pursuant to West Virginia C			

The Office of Oil and Gas processes your personal information, such as name, address and telephone number, as part of our regulatory duties. Your personal information may be disclosed to other State agencies or third parties in the normal course of business or as needed to comply with statutory or regulatory requirements, including Freedom of Information Act requests. Our office will appropriately secure your personal information. If you have any questions about our use or your personal information, please contact DEP's Chief Privacy Officer at depprivacyofficer@wv.gov.



### WEST VIRGINIA DEPARTMENT OF TRANSPORTATION **Division of Highways**

1900 Kanawha Boulevard East . Building Five . Room 110 Charleston, West Virginia 25305-0430 • (304) 558-3505

June 19, 2019

Byrd E. White, III Secretary of Transportation

> Jimmy Wriston, P. E. Deputy Secretary/ **Acting Commissioner**

James A. Martin, Chief Office of Oil and Gas Department of Environmental Protection 601 57th Street, SE Charleston, WV 25304

Subject: DOH Permit for the Mildred Mani Pad, Brooke County Mildred Mani BRK 210H Well site

Dear Mr. Martin,

This well site will be accessed from a DOH permit #06-2013-0277 issued to Southwestern Energy for access to the State Road for a well site located off of Brooke County Route 27/3 SLS.

This operator is in compliance with §22-6A-20 of the WV Code. Operator has signed a STATEWIDE OIL AND GAS ROAD MAINTENANCE BONDING AGREEMENT and provided the required Bond. This operator is currently in compliance with the DOH OIL AND GAS POLICY dated October 1, 2018.

Very Truly Yours,

Office of Oil and Gas

Gary K. Clayton, P.E.

Regional Maintenance Engineer Central Office O&G Coordinator

any K. Clayton

Cc: Brittany Woody Southwestern Energy

CH, OM, D-6

File

		Attachment VI Frac Additives	77000	U Z O
Product Name	Product Use	Chemical Name		CAS Mumber
AI-303 (U.S. Well Services)	Mixture	Ethylene glycol	And the second second	107-21 1 104-55 2
		Cinnamaldehyde		
		Butyl cellosolve		111-76 2 64-18 6
		Formic acid		
		Polyether		Proprietary
		Acetophenone, thiourea, formaldehyde polym	er	68527-49 1
AP ONE (U.S. Well Services)	Breaker	Ammonium persulfate		7727-54-0
Bactron K-139 (Champion Technologies)	Biocide	Glutaraldehyde		111-30-8
		Quaternary Ammonium Compounds, Benzyl-C	12-16-Alkyldimethyl, Chlorides	68424-85-1
		Ethanol	to a way to be to be	64-17-5
Bactron K-219 (Champion Technologies)	Biocide	Methanol		67-56-1
		Quaternary Ammonium Compounds, Benzyl-C	12-16-Alkyldimethyl, Chlorides	68424-85-1
arboNRT	Tracer	Ceramic Proppant		66402-68-4
C6486A (Nalco Champion)	Scale Inhibitor	Amine Triphosphate		Proprietary
		Ethylene Glycol		107-21-1
C6734A (Champion Technologies)	Biocide	Hydrogen Peroxide		7722-84-1
		Acetic Acid		64-19-7
		Peroxyacetic Acid		79-21-0
cono-CI200 (SWN Well Services)	Corrosion Inhibitor	Methanol		67-56-1
		Oxyalkylated fatty acid		68951-67-7
		Fatty acids		61790-12-3
		Modified thiourea polymer		68527-49-1
		Water		7732-18-5
		Hydrochloric acid		7647-01-0
		Potassium acetate		127-08-2
		Formaldehyde		50-00-0
copol-FEAC (SWN Well Services)	Iron Control	Acetic Acid		64-19-7
, , , , , , , , , , , , , , , , , , , ,		Citric Acid		77-92-9
		Water		7732-18-5
DP-S1176-15 (Halliburton)	Friction Reducer	Polyacylate		Proprietary
DF-31176-13 (Halliburtoll)	Friction Reducer	Hydrotreated light petroleum distillate		64742-47-8
LOJET DR900 LPP (SWN Well Services)	Friction Reducer	Distillates (petroleum) hydrotreated light		64674-47-8
LOJET DR900 LPP (SWIN Well Services)	Friction Reducer	Ethylene Glycol		107-21-1
		Alcohols, C12-16, Exoxylated propoxylated		68213-24-1
	<del></del>			Proprietary
		Fatty Alcohols ethoxylated Water		7732-18-5
	ar-ton-market areas			
LOJET DRP 1130X (SWN Well Services)	Friction Reducer	Proprietary	y	Proprietary
R-76 (Halliburton)	Friction Reducer	Hydrotreated light petroleum distillate		64742-47-8
		Inorganic Salt		Proprietary
SYPTRON T-390 (Champion Technologies)	Scale Inhibitor	Methanol		67-56-1
		Nonylphenol Ethoxylate		Proprietary
IAI-150E (Halliburton)	Corrosion Inhibitor	No hazardous substance		N/A
ICL (SWN Well Services)	Hydrocholic Acid	Hydrochloric Acid		7647-01-0
		Water		7732-18-5
P-65 MC (Halliburton)	Scale Inhibitor	Organic phosphonate		Proprietary
So mo (manazine)		Ammonium Chloride		12125-02-9
PTI-FLEX (U.S. Well Services)	Viscosifying Agent	Distillates, petroleum, hydrotreated light	more and a second	64742-47-8
lexslick 930	Friction Reducer			Proprietary
IEVOIICE 300	Triction Reducer	Copolymer of 2-propenamide  Hydrotreated Distillate		64742-47-8
		Sodium Chloride	RECEIVED	7647-14-5
		Alcohols, C12-16, Exoxylated	Office of Gil and Gas	68551-12-2
		Oleic Acid Diethanolamide		93-83-4
		Ammonium Chloride	JUL 3 0 2019	12125-02-9
laudial DES	Falatina Dadinas		0 7 2010	
lexslick 953	Friction Reducer	Petroleum Distillate	WV Denartment of	64742-47-8
		Sodium Chloride	WV Department of Environmental Protection	7647-14-5
		Ammonium Chloride		12125-02-9
		N,N-bis (2-hydroxyethyl) oleamide	- West	93-83-4
lexslick 957	Friction Reducer	Petroleum Distillate		64742-47-8
		Ammonium Chloride		12125-02-9
		Oleic Acid Diethanolamide		93-83-4
		Alcohols, C12-16, Exoxylated		68551-12-2
		Water		7732-15-5
WFRA-2000 (U.S. Well Services)	Anionic Friction Reducer	Hydrotreated light distillate (petroleum)		64742-47-8

# ENTRANCE BRADY'S RIDGE ROAD

### USGS 7.5 BETHANY/STEUBENVILLE EAST QUAD MAPS



**WVDEP OOG** ACCEPTED AS-BUILT 9/10/2019



### MILDRED MANI BRK WELL PAD

### CONSTRUCTION AS-BUILT & RECLAMATION PLAN

BUFFALO DISTRICT, BROOKE COUNTY, WV AUGUST 2017

LOCATION COORDINATES: ACCESS ROAD ENTRANCE

LATITUDE: 40.257203 LONGITUDE: -80.590345 (NAD-83) F 534835.5 (UTM ZONE 17 METERS)

WELL PAD CENTER

LATITUDE 40.253753 LONGITUDE: -80.589684 N 4456002.7 E 534898.2 (NAD-83) (UTM ZONE 17 METERS)

THE AS-BUILT INFORMATION SHOWN HEREON REFLECTS FIELD DATA COLLECTED RELATING TO THE FINAL GRADING OF THE DISTURBED AREA AS OF JULY 26, 2017, LARSON DESIGN GROUP IS NOT RESPONSIBLE FOR ANY CHANGES MADE TO THE SITE AFTER THE ABOVE MENTIONED DATE.

2. PROPERTY INFORMATION SHOWN HEREON WAS PROVIDED BY SOUTHWESTERN ENERGY AND MAY NOT REFLECT CURRENT BOUNDARY LOCATION.



WELL NAMES	WV NORTH NAD 27	WW NORTH NAD 83	UTM (METERS) ZONE 17	A TAJ ES DAM EMOJ	ELEVATION	
	AS-CRILLED COORDINATES				1,000	
MY DRED MANT BRY 14 (DRESED) APW 47-008-001-56	N 640682,79 E 1695811.59	N 640719.86 E 1664377.00	N 4455028.13 E 534901.96	LAT 40.253992' LONG -80.589595"	1075,33	
WEDRED MANUERS 34 (DRELED) APW 47 COBOCIED	N 640571.29 E 1695826.48	N 640709,36 € 1664393.89	N 4456024.71 £ 534907.16	LAT 49,253951" LONG 488 589534"	1075,25	
MILDWED MANIERS 501 (DRICE-D) AFFR AFFOR 500 (	N 640648,52 E 1695813 13	N 640685,59 E 1664378.54	N 4456017,70 E 534902,60	LONG -80.589588	1076,04	
(DRILLED) AFIE 27-03-0016*	N 640671,22 E 1695803,81	N 640708.29 E 1664369.32	N 4456024.57 E 534899.68	LAT 40.253950* LONG -80.589622*	1075,46	
MACRED MAN BRICOSH (DRILLED) API# 47-468-00159	N 540650.09 E 1695820.81	N 640597.16 E 1654366.21	N 4455021.26 E 534904.88	LAT 40.253920° LONG -80.589561°	1075.17	

### SHEET INDEX

2-3

1	COVER	SHEE

EVACUATION ROUTE/PREVAILING WINDS

AS-BUILT OVERALL PLAN SHEET INDEX

5-6 AS-BUILT PLAN SHEETS

ACCESS ROAD AS-BUILT PROFILE

WELL PAD AS-BUILT PROFILE

AS-BUILT RECLAMATION OVERALL PLAN SHEET INDEX

10-11 AS-BUILT RECLAMATION PLAN SHEETS

12 GENERAL NOTES AND DETAILS

13-14 DETAILS

### DESIGN CERTIFICATION

THE DRAWINGS, CONSTRUCTION NOTES, AND REFERENCE DIAGRAMS ATTACHED HERETO HAVE BEEN PREPARED IN ACCORDANCE WITH THE WEST VIRGINIA CODE OF STATE RULES, DIVISION OF ENVIRONMENTAL PROTECTION, OFFICE OF OIL AND GAS CSR 35-8.





MISS Utility of West Virginia 1-800-245-4648 West Virginia State Law (Section XIV: Chapter 24-C) Requires that you call two business days before you dig in the state of West Virginia. IT'S THE LAW!!



Larson Design Group

BLG AEH

AD

MANI RICT. BROOM

MILDRED I BUFFALO DISTRI In Company, LLC

OF 14 7688-016-005

