


Plat of the proposed Location of Well No. 1, of the Little Five Company of Salem, W. Va., on the Simon H. Garner Farm, consisting of 112.5 Acres, Located in McClellan District Doddridge County.

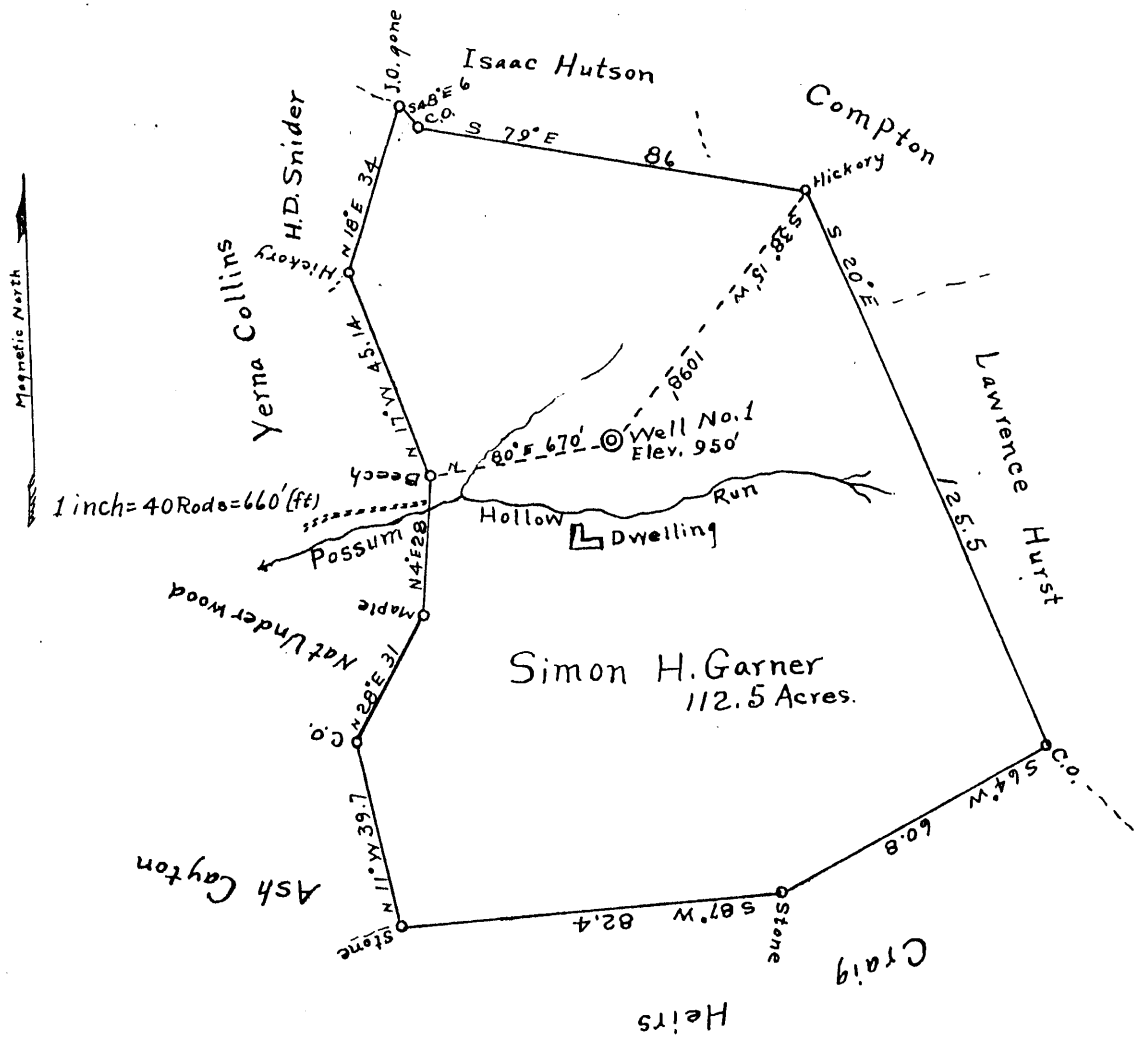

Engineer's Certificate.

I, the undersigned, hereby certify that this map is correct and shows all the information to the best of my knowledge and belief, required by the oil and gas section of the mining Laws of West Virginia.

C.C. Freeman
Civil Engineer.

DOD-10

Acknowledged before me a Notary Public of West Virginia, this 18th day of August, 1929

C. H. Schutte
Notary Public.

My commission expires Jan 22 1935,

LATITUDE 39° 22' 30"

80° 32' 30"

LONGITUDE

[Handwritten scribble]
6676
7.5' loc

2.50S
1.24W

7.5 OGIS topo location

7.5' loc ~~1.99S~~ 15' loc ~~1.99S~~
~~2.09W~~ (calc.) ~~4.82W~~

Company Little Fine Co.

Farm Simon H Garner

Quad Salem 7.5' Centerpoint-se

County Ada.

District McClellan

WELL LOCATION MAP

File No. 017-10

STATE OF WEST VIRGINIA
DEPARTMENT OF MINES
OIL AND GAS DIVISION

WELL RECORD

Permit No. DOD-10

Oil or Gas Well.....
(KIND)

Company <u>Little Five Oil Company</u> Address <u>Salem, W. Va.</u> Farm <u>S. H. Garner</u> Acres..... Location (waters)..... Well No. <u>1</u> Elev..... District <u>McClalland</u> County <u>Doodridge</u> The surface of tract is owned in fee by..... Address..... Mineral rights are owned by..... Address..... Drilling commenced..... Drilling completed..... Date Shot..... From..... To..... With..... Open Flow <u>18/10ths</u> Water in <u>1/8"</u> Inch /10ths Merc. in..... Inch Volume..... Cu. Ft. Rock Pressure..... lbs..... hrs. Oil..... bbls., 1st 24 hrs. Fresh water..... feet..... feet Salt water..... feet..... feet	<table border="1" style="width: 100%; border-collapse: collapse;"> <tr> <th style="width: 15%;">Casing and Tubing</th> <th style="width: 15%;">Used in Drilling</th> <th style="width: 15%;">Left in Well</th> <th style="width: 55%;">Packers</th> </tr> <tr> <td>Size</td> <td></td> <td></td> <td></td> </tr> <tr> <td>16 Conductor</td> <td></td> <td>16'</td> <td>Kind of Packer.....</td> </tr> <tr> <td>13</td> <td></td> <td></td> <td></td> </tr> <tr> <td>10</td> <td></td> <td>376'</td> <td>Size of.....</td> </tr> <tr> <td>8 1/4</td> <td></td> <td>1444'</td> <td></td> </tr> <tr> <td>6 5/8</td> <td></td> <td>2176'</td> <td>Depth set.....</td> </tr> <tr> <td>5 3/16</td> <td></td> <td></td> <td></td> </tr> <tr> <td>3</td> <td></td> <td></td> <td>Perf. top.....</td> </tr> <tr> <td>2</td> <td></td> <td></td> <td>Perf. bottom.....</td> </tr> <tr> <td>Liners Used.....</td> <td></td> <td></td> <td>Perf. top.....</td> </tr> <tr> <td></td> <td></td> <td></td> <td>Perf. bottom.....</td> </tr> </table> <p>CASING CEMENTED..... SIZE..... No. Ft..... Date.....</p> <p>COAL WAS ENCOUNTERED AT..... FEET..... INCHES FEET..... INCHES..... FEET..... INCHES FEET..... INCHES..... FEET..... INCHES</p>	Casing and Tubing	Used in Drilling	Left in Well	Packers	Size				16 Conductor		16'	Kind of Packer.....	13				10		376'	Size of.....	8 1/4		1444'		6 5/8		2176'	Depth set.....	5 3/16				3			Perf. top.....	2			Perf. bottom.....	Liners Used.....			Perf. top.....				Perf. bottom.....
Casing and Tubing	Used in Drilling	Left in Well	Packers																																														
Size																																																	
16 Conductor		16'	Kind of Packer.....																																														
13																																																	
10		376'	Size of.....																																														
8 1/4		1444'																																															
6 5/8		2176'	Depth set.....																																														
5 3/16																																																	
3			Perf. top.....																																														
2			Perf. bottom.....																																														
Liners Used.....			Perf. top.....																																														
			Perf. bottom.....																																														

Formation	Color	Hard or Soft	Top	Bottom	Oil, Gas or Water	Depth Found	Remarks
Water 1/2 bbl.				121'			
Coal				118'			
Water 1/2 bbl.				203'			
Coal			360'	365'			
10" casing				376'			
Coal			518'	520'			
Sand & slate			400'	600'			
Coal			830'	832'			
Pittsburg coal - steel line			907'	915'			
Sand			990'	1000'			
Sand			1015'	1035'			
Red rock			1120'	1160'			
Gritty shells			1210'	1240'			
Lime			1250'	1280'			
Little Dunkard sandy lime			1321'	1350'			
Black slate			1390'	1420'			
White slate			1420'	1426'			
Lime shell			1426'	1429'			
White cave			1429'	1440'			
Big Dunkard sand			1440'	1498'			
8 1/4" casing			1444'				
Gritty Lime			1570'	1595'			
Salt sand			1738'	1748'			
2nd Salt Sand			1776'	1820'			
Sand			1860'	1875'			
Sand shells			1950'	1965'			
Pure sand			1965'	1992'			
Sand			1994'	2047'			
Water 1 bbl. per hr.			2032'	2035'			
Gritty white lime			2055'	2067'			
Red rock			2093'	2096'			
Hard & gritty			2096'	2104'			
Little lime			2128'	2140'			
Steel line			2137'				
Pencil cave			2140'	2162'			
Big lime			2162'	2210'			
6-5/8" casing			2176'				
Big Injun			2210'	2323'			
Squaw			2427'	2534'			
Soft greasy slate			2575'	2600'			
Berea Grit			2667'	2725'			
Gantz Sand			2750'	2765'			

Formation	Color	Hard or Soft	Top	Bottom	Oil, Gas or Water	Depth Found	Remarks
50 feet			2779'	2797'			
30 foot shell			2854'	2860'			
Steel line run				2861' 4/12			
30 feet hard sand			2867'	2895'			
Hard shell			2913'	2917'			
Well shot with one stick dynamite to every feet from			2774'	2926'			
Well cemented 2 & 1 mix			2734'	2926'			
Let well stand six days & drilled out hard shell			2926'	2930'			
Gordon's stray			2932'	2969' 2/69			
Gas			2945'	2945 1/2			
Gas & Blk. skim oil			2951'	2952'			
Steel line run at			2952'				
Soft sand			2960'	2963'			
Gordon Sand			2987'	3005'			
Little pay of oil & gas			2997'	3002'			
Total depth			3024'				

Date....., 194

APPROVED....., Owner

By.....
(Title)

Open flow
Water test 18/10 through 1/2" pipe.

Gordon stray	---	2932	2969	Coal	----	830	382
Gas	---	2945	2945	Pittsburg coal-steel-line	----	907	915
Gas & Blk. skim oil	---	2951	2952	Sand	---	990	1000
Steel line run at		2952		Sand	---	1015	1035
Soft sand		2960	2963	Red rock	---	1120	1160
Gordon Sand	--	2987	3005	Gritty shells	--	1210	1240
Little pay of oil & gas		2997	3002	Lime	--	1250	1280
Total depth		3024		Little Dunkard sandy lime		1321	1350
Well shot Dec. 16 1929 20 qts.				Dec. 14, 1929			
Top of shell	2994	Bottom	3002	Black slate	--	1390	1420
Shot well Dec. 19, 1929, 30 qts.							
Top of shell	2995	Bottom	3002				
Shot Stray Dec. 20, 1929, 20 qts.							
Top of shell	2949	Bottom	2955				
Pencil cave	---	2140	2162				
Big Lime	--	2162	2210				
6 5/8 Casing	--	2176					
Big Injun	--	2210	2323				
Squaw	--	2427	2534				
Soft greasy slate	--	2575	2600				
Berea Grit	--	2667	2725				
Gantz Sand	--	2750	2765				
50 feet	--	2779	2797				
30 feet shell	--	2854	2860				
Steel line run	--		2861				
30 feet hard sand	--	2867	2895				
Hard shell		2913	2917				
Well shot with one stick dynamite to every foot from		2774	2926				
Well cemented 2 & 1 mix		2734	2926				
Let well stand six days & drilled out							
Hard shell	--	2926	2930				
White slate	--	1420	1426				
Lime shell	--	1426	1429				
White cave	--	1429	1440				
Big Dunkard sand	--	1440	1498				
8 1/2" Casing	--	1444					
Gritty Lime	--	1570	1595				
Salt sand	--	1738	1748				
2 nd. Salt sand	--	1776	1820				
Sand	--	1860	1875				
Sand shells	--	1950	1965				
Pure sand	--	1965	1992				
Sand	--	1994	2047				
Water 1 bbl. per hr.	--	2032	2035				
Gritty white lime	--	2055	2067				
Red rock	---	2093	2096				
Hard & gritty	--	2096	2104				
Little lime	--	2128	2140				
Steel line	--	2137					
Conductor			16				
Water 1/2 bbl.	---		121				
Coal	---		118				
Water 1/2 bbl.	---		203				
Coal	---	360	365				
10" Casing	---		376				
Coal	---	518	520				
Sand & slate	---	400	600				

4th part

3rd part

2d part