


Plat of the Proposed Location of Well No. 1, of W.L.Travis of Smithburg, West Virginia, on the S.S.Spencer Farm, consisting of 100 acres, located in West Union District, Doddridge County.

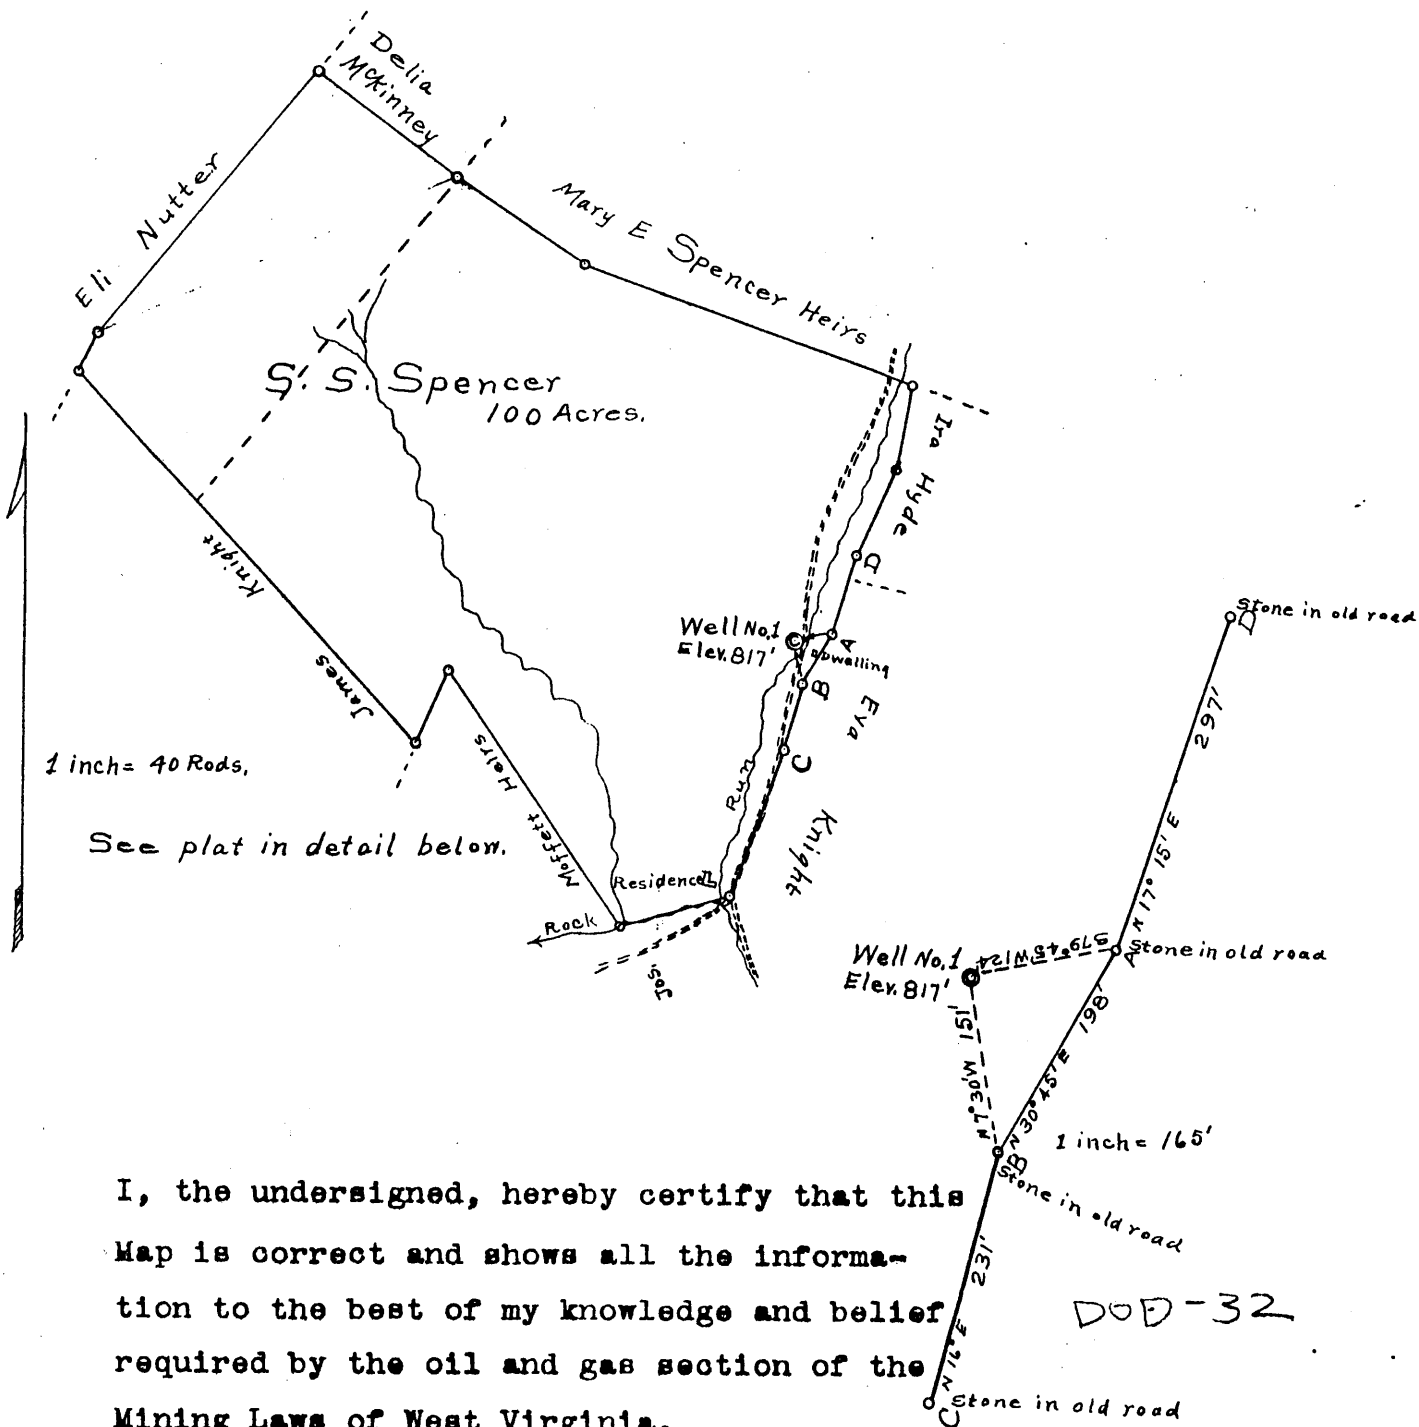

I, the undersigned, hereby certify that this Map is correct and shows all the information to the best of my knowledge and belief required by the oil and gas section of the Mining Laws of West Virginia.

C. C. Freeman
Civil Engineer.

Acknowledged before me a Notary Public of Harrison County, West Virginia, this the 14th day of November, 1930.

Chas R. Carter
Notary Public.

My commission expires
Sept. 18th, 1935.

LATITUDE 39° 20'

LONGITUDE 94° 08'

T5 OGIS topo location

7.5' loc	<u>1.66^S</u>	15' loc	<u>1.66^S</u>
	<u>0.14^W</u>	(calc.)	<u>0.14^W</u>

Company W. D. GRIBBLE

Farm S. S. SPENCER 1

Quad WEST UNION +15' SE

County Dodd

District WEST UNION

WELL LOCATION MAP

File No. 017 - 32



COPY

568

STATE OF WEST VIRGINIA
DEPARTMENT OF MINES
OIL AND GAS DIVISION

WELL RECORD

Permit No. DOD-32

Oil or Gas Well Gas
(KIND)

Company W. D. Gribble
Address West Union, W. Va.
Farm S. S. Spencer Acres 100
Location (waters) Rock Run
Well No. 1 Elev. 817
District West Union County Doddridge
The surface of tract is owned in fee by B. E. Fox
Address West Union
Mineral rights are owned by Same
Address _____
Drilling commenced _____
Drilling completed _____
Date Shot _____ From _____ To _____
With _____
Open Flow 54 /10ths Water in 2 Inch
_____ /10ths Merc. in _____ Inch
Volume 310 Mcf Cu. Ft.
Rock Pressure _____ lbs. _____ hrs.
Oil _____ bbls., 1st 24 hrs.
Fresh water 35 feet _____ feet
Salt water _____ feet _____ feet

Casing and Tubing	Used in Drilling	Left in Well	Packers
Size			Kind of Packer
16			
13			
10	435	None	Size of
8 1/4	888	None	
6 3/8	1387	1387	Depth set
5 3/16			
3			Perf. top
2			Perf. bottom
Liners Used			Perf. top
			Perf. bottom

CASING CEMENTED _____ SIZE _____ No. Ft. _____ Dat _____
COAL WAS ENCOUNTERED AT _____ FEET _____ INCHES
_____ FEET _____ INCHES _____ FEET _____ INCHES
_____ FEET _____ INCHES _____ FEET _____ INCHES

Formation	Color	Hard or Soft	Top	Bottom	Oil, Gas or Water	Depth Found	Remarks
Sand	brown	soft	20	65			
Red rock	red	soft	65	120			
Lime	white	hard	120	175			
Sand	white	hard	883	896			
Sand	white	hard	980	1014			
Sand	white	hard	1039	1070			
Sand	white	hard	1081	1250			
Sand	white	hard	1403	1469			
Sand	gray	hard	1556	1609			
Lime	white	hard	1609	1665			
Slate	dark	soft	1665	1673			
Lime	white	hard	1673	1745			
Sand	white	hard	1745	1850	in Gas	1793-1803	
Slate	black	soft	1850	1860			
Sand	white	hard	1860	1875			
Slate	black	soft	1875	1952			