


Plat of proposed Location of Well No. 11, of J. H. Pentz of Dubois, Pa. on the Zadok Underwood farm of 150 acres, in McClellan District, Doddridge County, West Virginia.

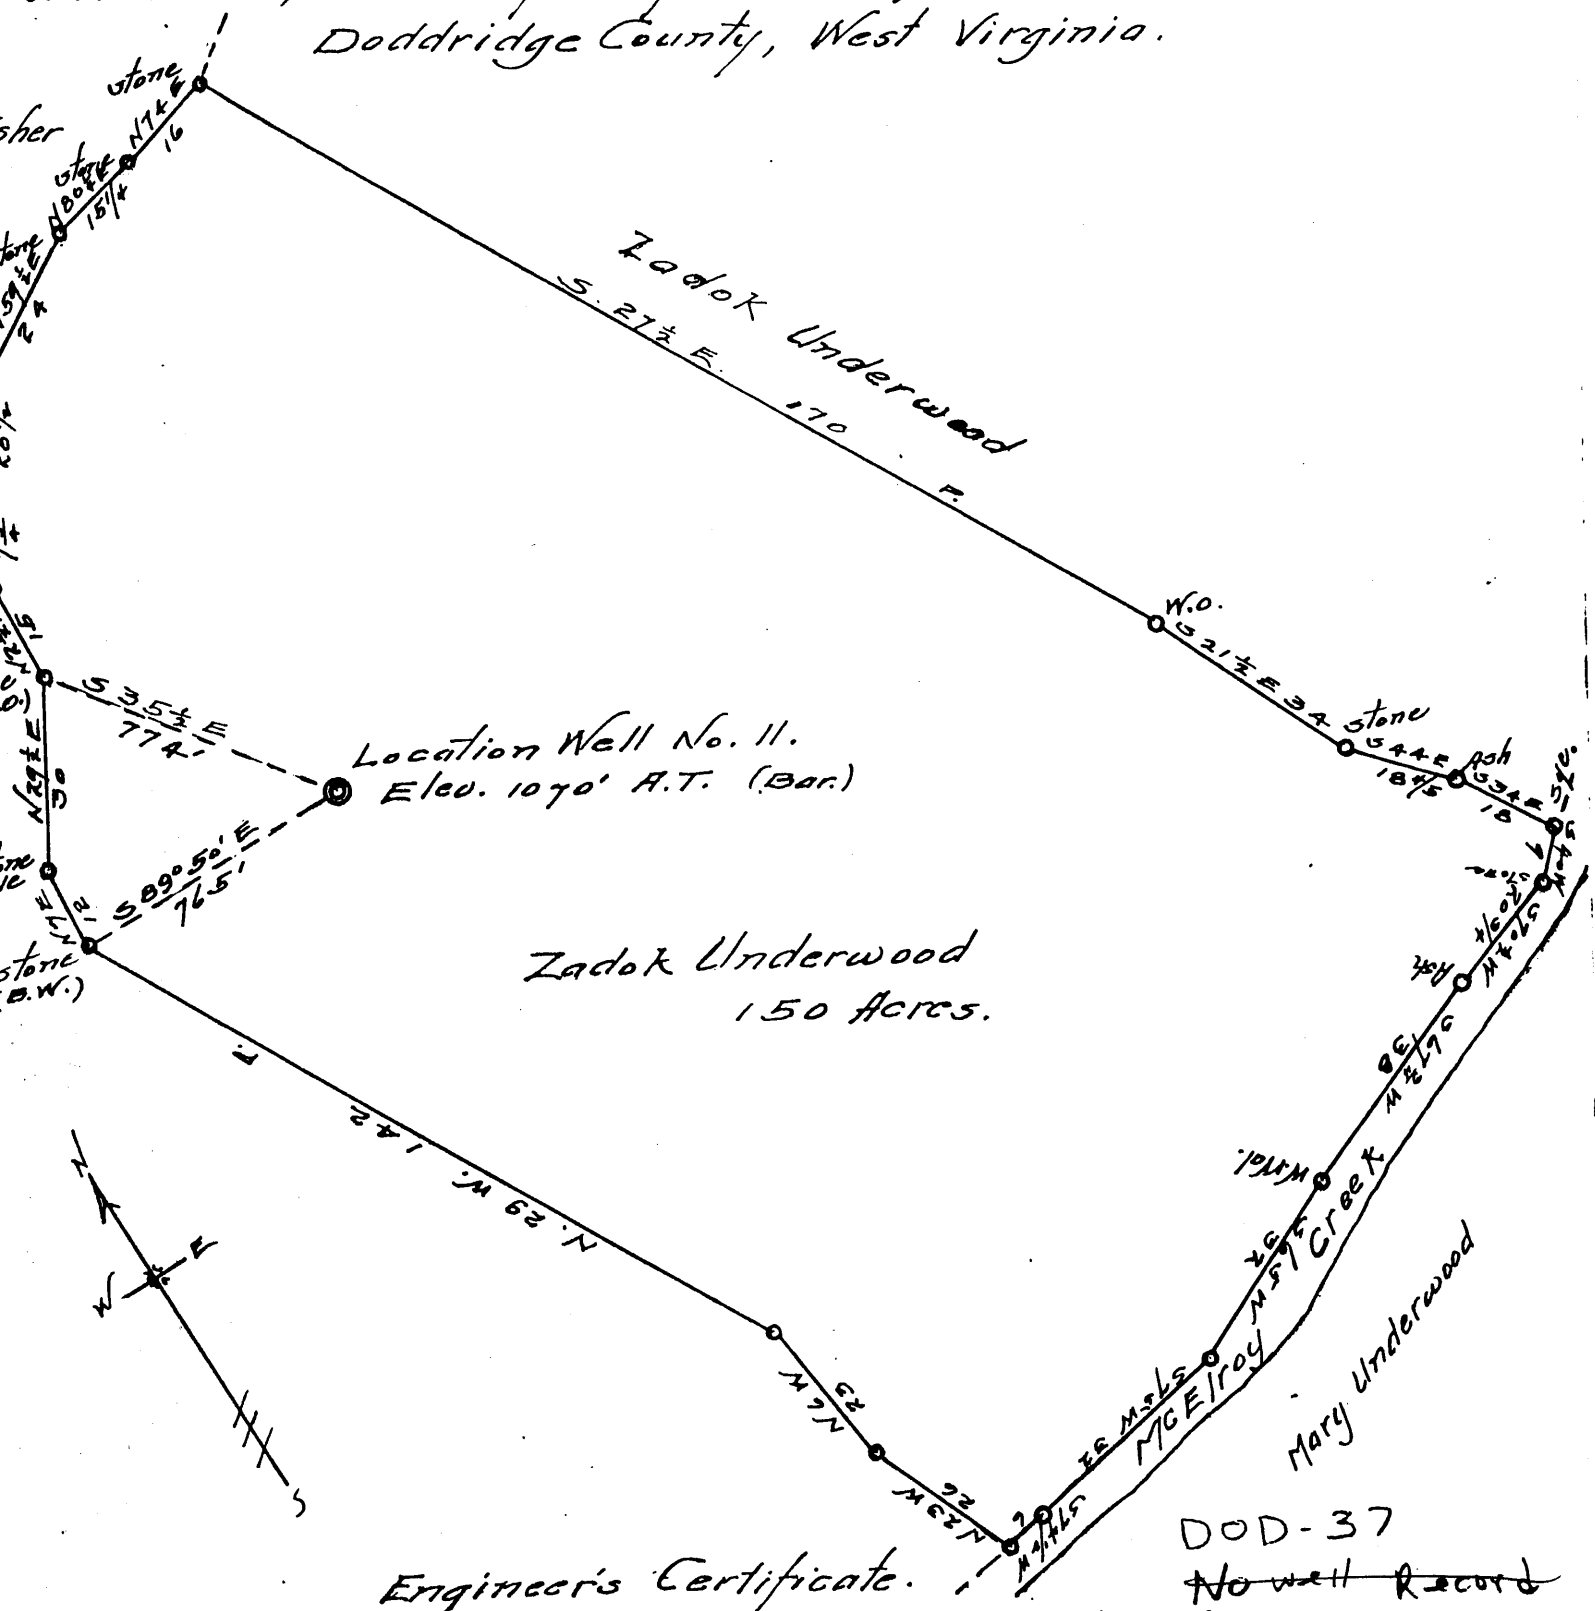


Engineer's Certificate.

I, the undersigned, hereby certify that this map is correct and shows all the information, to the best of my knowledge and belief, required by the Oil and Gas Section of the Mining Laws of West Virginia.

P. P. Berkeley
Engineer for C.

Acknowledged before me, a notary public in and for Tyler County West Va. this 23rd. day of March, 1931.

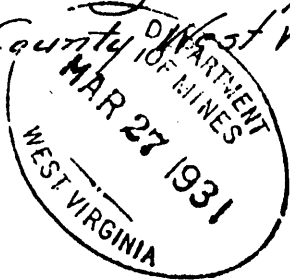

M. C. Burghesser
Notary public.
My Commission expires Nov. 10, 1932

LATITUDE 39° 25'



104.08 LONGITUDE

7'5 OGIS topo location

7.5' 10C	<u>0.96 S</u>	15' 10C	<u>0.96 S</u>
	<u>1.68 W</u>	(calc.)	<u>1.68 W</u>

Company J. H. PENTZ

Farm ZADOK UNDERWOOD II

Quad CENTER POINT ^{+15'} WC

County DODD

District McCLELLAN

WELL LOCATION MAP

File No. 017-37

no plugging record 4(27) 100

WEST VIRGINIA DEPARTMENT OF MINES

Oil and Gas Section

PRELIMINARY DATA SHEET NO. 1

File No. Dod 37 Well No. 11

J. H. Penz Company, of Burbais, Pa

on the gadol underwood Farm containing 150 acres. Location No 11

McClelland District, in Ward County, West Virginia.

The surface of the above tract is owned in fee by gadol underwood of Canton west va post office address, and the mineral rights are owned by gadol underwood of Canton W. Va

The oil and gas privileges are held under lease by the above named company, and this well is drilled under permit No. 11-1 issued by the West Virginia Department of Mines, Oil and Gas Section, 19.....

Elevation of surface at top of well, 1070 Spirit Barometric.

The number of feet of the different sized casings used in the well.

feet	size	material
.....	<u>1 3/4 inch</u>	Wood conductor.
<u>10 inch</u> sized csg.
<u>8 1/4 "</u> sized csg.
<u>6 5/8 "</u> sized csg.

..... packer of size, set at

..... in casing perforated at feet to feet.

Coal was encountered at feet; thickness inches, and at feet; thickness inches; and at feet; thickness inches.

Liners were used as follows: (Give details)

Date. Approved J. H. Penz, Owner. By (Title)