


Latitude 39° 15' 7.5"

Longitude 80° 50' 7.5"

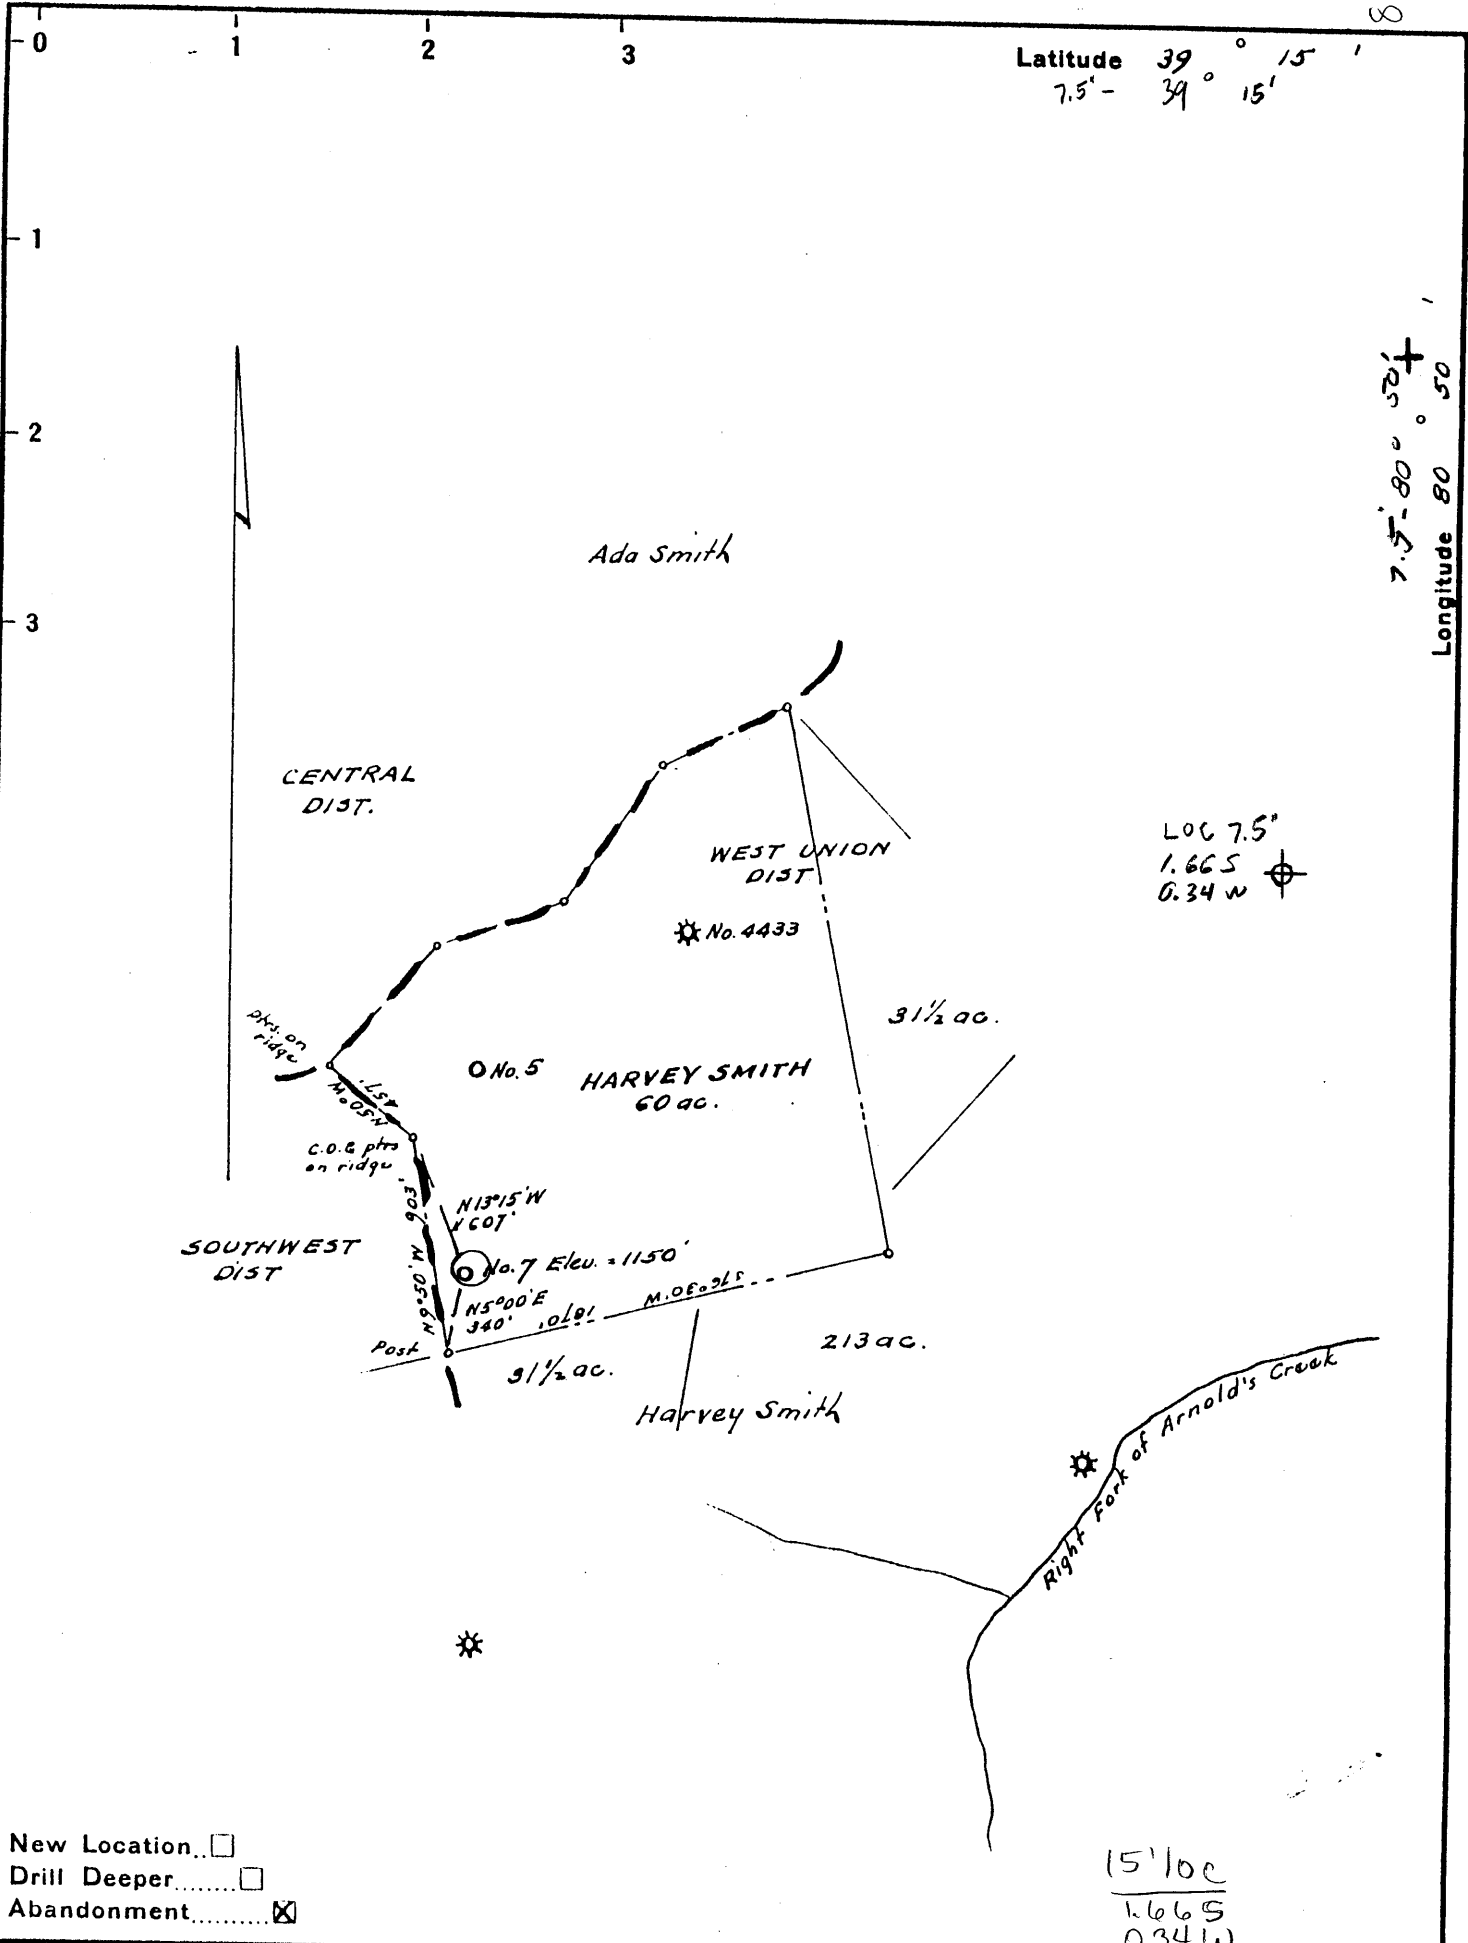

LOG 7.5°
1.665
0.34 W

15' 10c
1.665
0.34 W

New Location
 Drill Deeper
 Abandonment

Company SAM BEREN
 Address Marietta, Ohio
 Farm Harvey Smith
 Tract _____ Acres 60 Lease No. _____
 Well (Farm) No. Seven Serial No. _____
 Elevation (Spirit Level) 1150
 Quadrangle Oxford Halbrook + 15' NC
 County Doddridge District West Union
 Engineer W. Black
 Engineer's Registration No. 1227
 File No. _____ Drawing No. _____
 Date Oct. 1948 Scale 1" = 800'

STATE OF WEST VIRGINIA
 DEPARTMENT OF MINES
 OIL AND GAS DIVISION
 CHARLESTON

WELL LOCATION MAP

FILE NO. DOD-737-A
DODD-50

+ Denotes location of well on United States Topographic Maps, scale 1 to 62,500, latitude and longitude lines being represented by border lines as shown.

- Denotes one inch spaces on border line of original tracing.

"IMPERIAL" TRACING CLOTH
 K & E CO., N. Y.

Plat of WELL No 201 & LOCATION FOR WELL No 3568

HOPE CONSTRUCTION & REFINING CO.

of the
Clarksburg, W. Va., on the

HARVEY SMITH


Farm consisting of 450 Acres

WEST UNION

District

DODDRIDGE

County, W. Va.

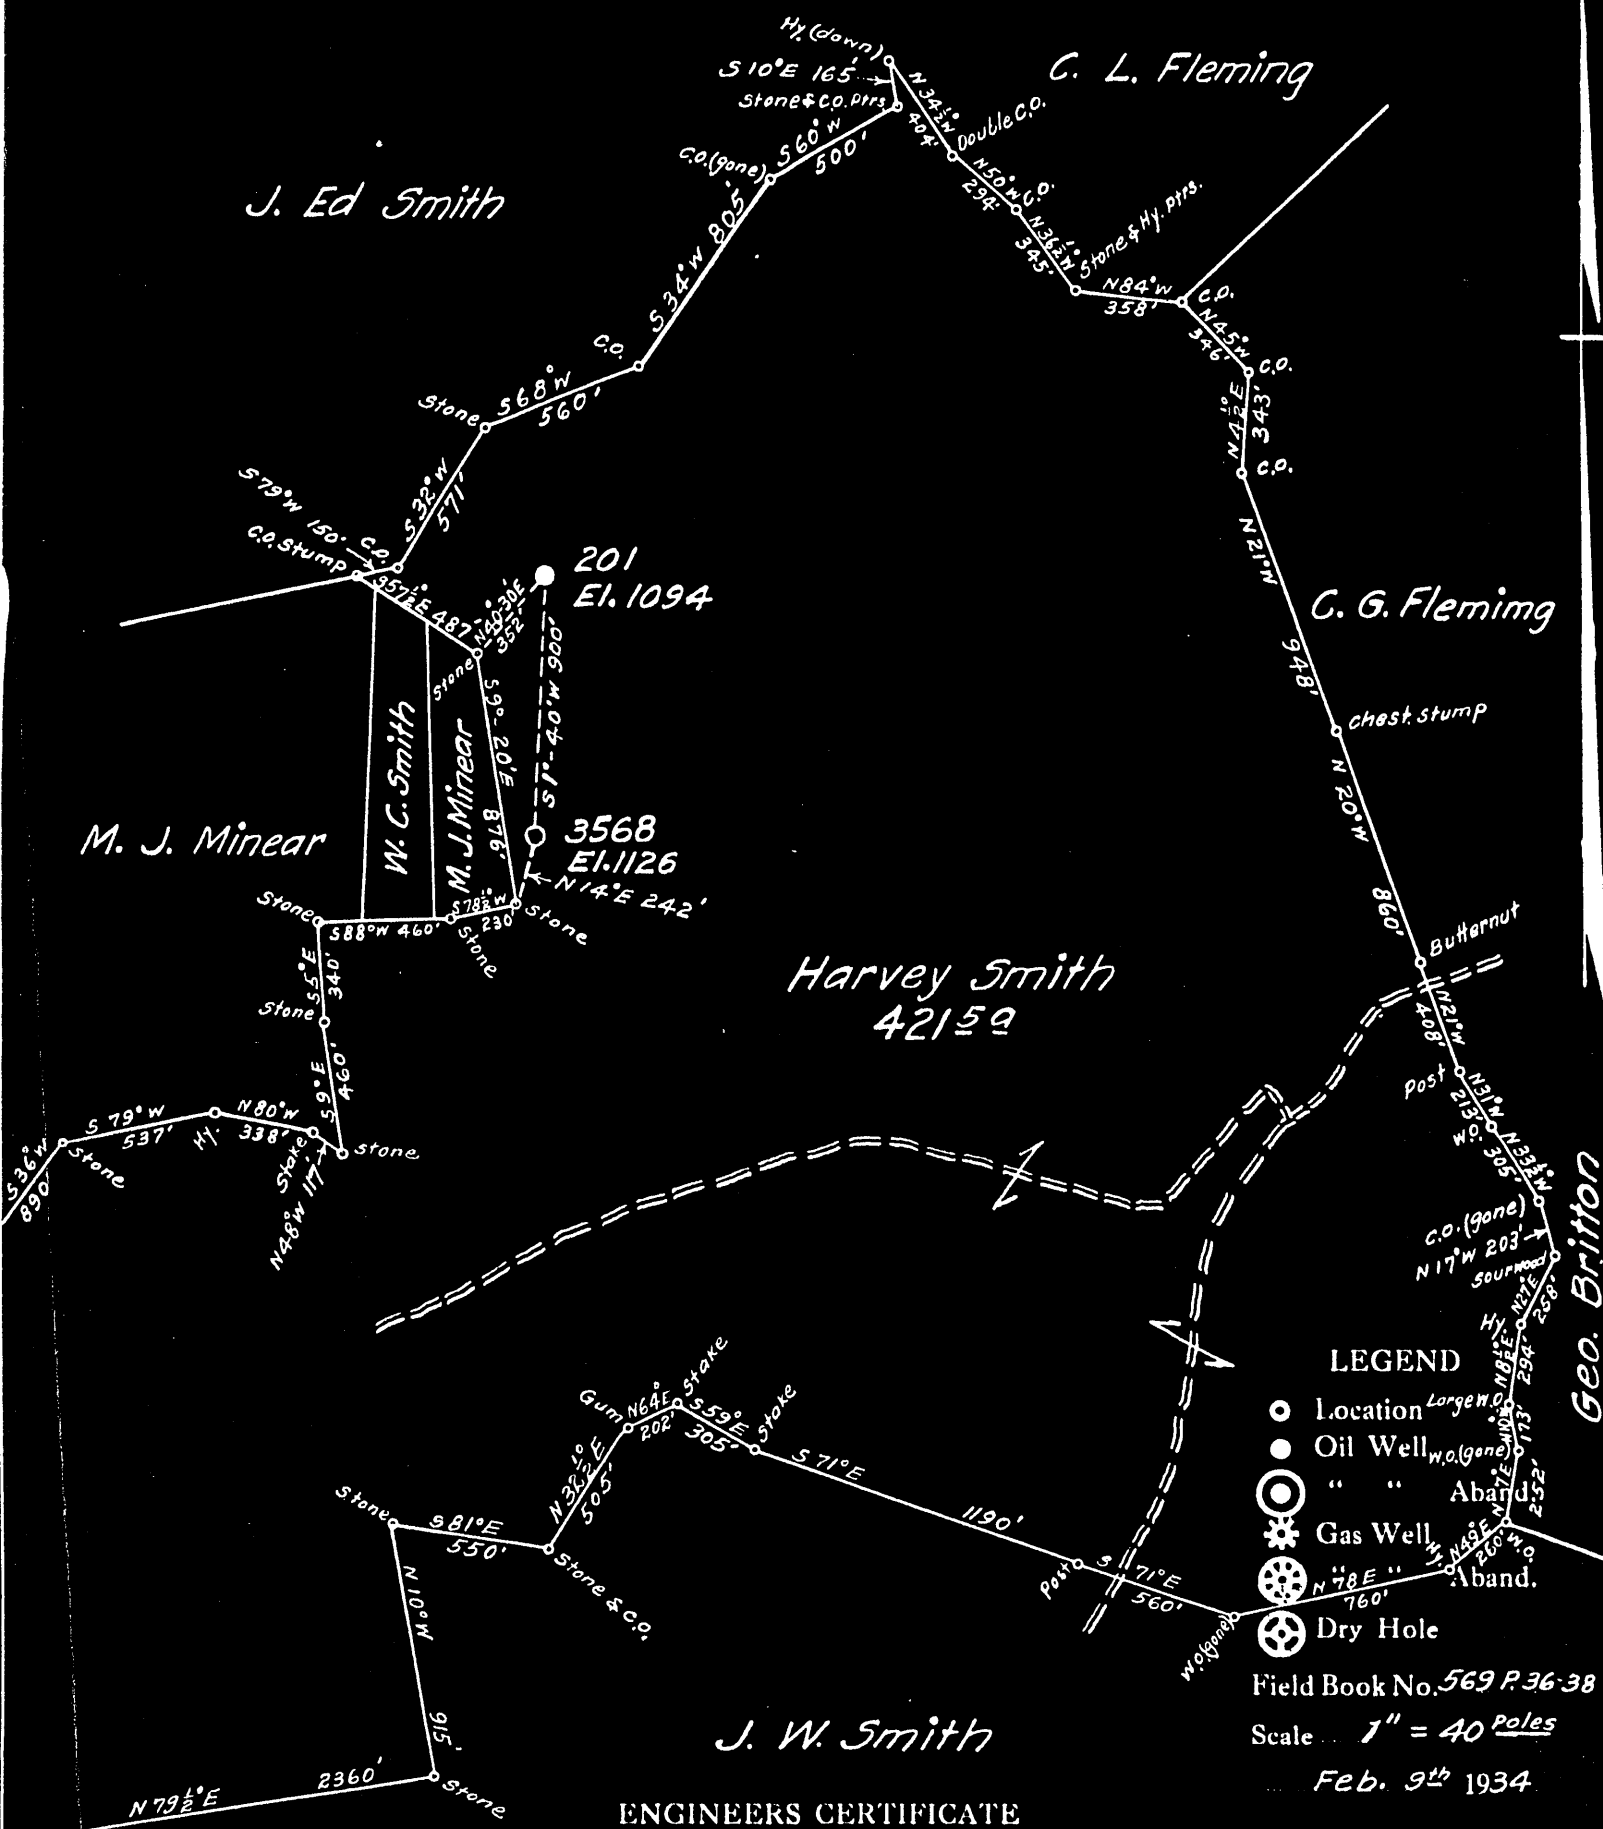

I, the undersigned, hereby certify that this map is correct and shows all the information to the best of my knowledge and belief, required by the oil and gas section of the mining laws of West Virginia.

W. H. Hadden
ENGINEER

Acknowledged before me a Notary Public in and for the County of Harrison and State of West Virginia

this 14th day of February 1934

My Commission expires Feb 18 - 1936 *Geo. H. Cunningham N.P.*

Dod-50

WEST VIRGINIA DEPARTMENT OF MINES

OIL AND GAS DIVISION

PRELIMINARY DATA SHEET NO. 1

File No. Dod-50

Well No. 3569

Hope Construction & Refining Company, of 445 West Main St.

Clarksburg, W. Va. on the Harvey Smith Farm

containing 450 acres. Location.....

West Union District, in Doddridge County, West Virginia

The surface of the above tract is owned in fee by Harvey Smith Heirs.

of Clarksburg, W. Va. address, and the mineral rights are owned by

Harvey Smith Heirs. of Clarksburg, W. Va.

The oil and gas privileges are held under lease by the above named company, and this well is drilled under permit No. Dod-50 issued by the West Virginia Department of Mines, Oil and Gas Division

March 2nd, 1934. 193.....

Elevation of surface at top of well, 1126 Spirit Barometric

The number of feet of the different sized casings used in the well.

..... feet..... size. Wood conductor.

624 feet 10" size, csg. 1175 feet 8 1/2" sized csg.

1875 feet 6-5/8" size, csg. feet..... sized csg.

..... feet..... size, csg. feet..... sized csg.

..... packer of..... size, set at.....

..... packer of..... size, set at.....

....., in casing perforated at..... feet to..... feet.

....., in casing perforated at..... feet to..... feet.

Coal was encountered at 410 feet; thickness 56 inches, and at.....

feet; thickness..... inches; and at..... feet; thickness..... inches.

Liners were used as follows: (Give details).....

10" casing provided with steel casing shoe, set in 20 feet of good mud.

April 19th, 1934. Date.

Approved Hope Construction & Refining Co., Owner.

By H. B. Musgrave (TITLE) Well Supervisor

APR 20 1934

4/20/34

Hope Construction & Refining Company

COMPLETION DATA SHEET

Clarksburg, W. Va. Address

No. 2

Well No. 3568

FORMATION RECORD

Name	Color	Character	Oil, Gas or Water	Top	Bottom	Thickness	Total Depth	Remarks
Native Coal				410	413	3'		
Sand			Fresh Water-- 585	525	615	90'		10" Casg. 624'
Little Dunkard Sand				1170	1187	17'		8 1/4" " 1175'
Big Dunkard Sand			Show Oil-- 1270 to 1274	1230	1287	57'		
Gas Sand				1360	1425	65'		
First Salt Sand			Show Oil-- 1512	1500	1525	25'		
Second Salt Sand			Salt Water-- 1515	1690	1720	30'		
Maxon Sand			Salt Water-- 1868	1834				6-5/8" Casg. set at 1875'
Run 6-5/8" casing at 1875 and resumed drilling.						Total depth	1878	
<p>Preliminary report as required by Rules & Regulations by the Department of Mines. (Rule 9), as soon as the drilling of any well has been completed through the Salt Sand,</p>								

4/20/34

Well was not shot at feet; well was shot at feet.

Fresh water at 585 feet; salt fresh water at 1515 & 1868 feet.

Well was producing hole. (Not completed)
dry

April 19th, 1934.
Date

Approved Hope Construction & Refining Company
Owner

By *H. L. Musgrave*

NOTE: All bottom formations must be noted as indicated above and all key-rocks and oil and gas sands must be recorded under their proper geological names in the district as well as any local names commonly used in the district for such strata.



STATE OF WEST VIRGINIA
DEPARTMENT OF MINES
OIL AND GAS DIVISION

639

Dodd - 50

WELL RECORD

Permit No. D. P. 150

Oil or Gas Well X (KIND)

see also 737A

Company Joe Rubin, S. Beren, H. Strauss
Address 2008 E. 7th St. Parkersburg, W. Va.
Farm Harvey Smith Acres 450
Location (waters) _____
Well No. #7 Elev. _____
District West Union County Doddridge
The surface of tract is owned in fee by _____
Address _____
Mineral rights are owned by _____
Address _____
Drilling commenced _____
Drilling completed April 25, 1934
Date Shot _____ From _____ To _____
With _____
Open Flow _____ /10ths Water in _____ Inch
_____ /10ths Merc. in _____ Inch
Volume _____ Cu. Ft.
Rock Pressure _____ lbs. _____ hrs.
Oil _____ bbls., 1st 24 hrs.
Fresh water _____ feet _____ feet
Salt water _____ feet _____ feet

Casing and Va. Tubing	Used in Drilling	Left in Well	Packers
Size			
16			Kind of Packer <u>NO</u>
13			
10	624	624	Size of _____
8 1/4	1183	1183	Depth set _____
6 1/2	1878	1878	Perf. top _____
5 3/16			Perf. bottom _____
3			Perf. top _____
2			Perf. bottom _____
Liners Used			

CASING CEMENTED _____ SIZE _____ No. Ft. _____ Date _____

COAL WAS ENCOUNTERED AT _____ FEET _____ INCHES
_____ FEET _____ INCHES _____ FEET _____ INCHES
_____ FEET _____ INCHES _____ FEET _____ INCHES

Formation	Color	Hard or Soft	Top	Bottom	Oil, Gas or Water	Depth Found	Remarks
Native Coal			410	413			
Sand			525	615			
Water			585				
Pgh Coal			680	686			
Little Dunkard			1170	1187			
Big Dunkard			1230	1287			
Oil			1270	1274			
Gas Sand			1360	1425			
1st Salt			1500	1625			
Water			1515				
Oil			1512				
2nd Salt			1690	1720			
Maxon			1834	1880			
Water			1865				
Sand			1918	1967			
Little Lime			1967	1980			
Big Lime			1980				
Oil			1982	1986			
Total Depth				2002			

(Over) SEP 14 1949

HARVEY SMITH NO. 7 WELL.

West Union District, Doddridge County, W. Va.

Dodd ^{reg} 50 + 737A

By Joe Rubin, S. Beren & H. Strauss, 2008 E. 7th St., Parkersburg, W. Va.

Abandoned under permit Dod-737.-A? (Drilling Permit No.....?)

On 450 acres.

Elevation, ' L.

Drilling completed April 25, 1934.

10" casing, 624'; 8 $\frac{1}{4}$ ", 1183'; 6 $\frac{5}{8}$ ", 1878'; all left in.

No packer.

Oil well. Record to Dept. of Mines not dated or stamped.

Record to RCT from Mrs. Griffith September 14, 1949. Old File No. 639.

	Top.	Bottom.
Native coal	410	- 413
Sand (water, 585')	525	- 615
Pittsburgh Coal	680	- 686
Little Dunkard Sand	1170	- 1187
Big Dunkard Sand (oil, 1270-1274')	1230	- 1287
Gas Sand	1360	- 1425
1st Salt Sand (water, 1515'; oil, 1512')	1500	- 1625
2nd Salt Sand	1690	- 1720
Maxton Sand (water, 1865')	1834	- 1880
Sand	1918	- 1967
Little Lime	1967	- 1980
Big Lime (oil, 1982-1986')	1980	-
Total depth		2002