

LATITUDE 39° 20'

LONGITUDE 80° 47' 30"



7'5 OGIS topo location

7.5' loc	<u>1.4 S</u>	15' loc	<u>1.40 S</u>
	<u>2.13 W</u>	(calc.)	<u>4.36 W</u>

Company J. J. GRIMES

Farm W. H. PIGOTT 1

Quad WEST UNION + 15' SE


County DODD

District CENTRAL

WELL LOCATION MAP

File No. 017-52

plugged 10/13/1945

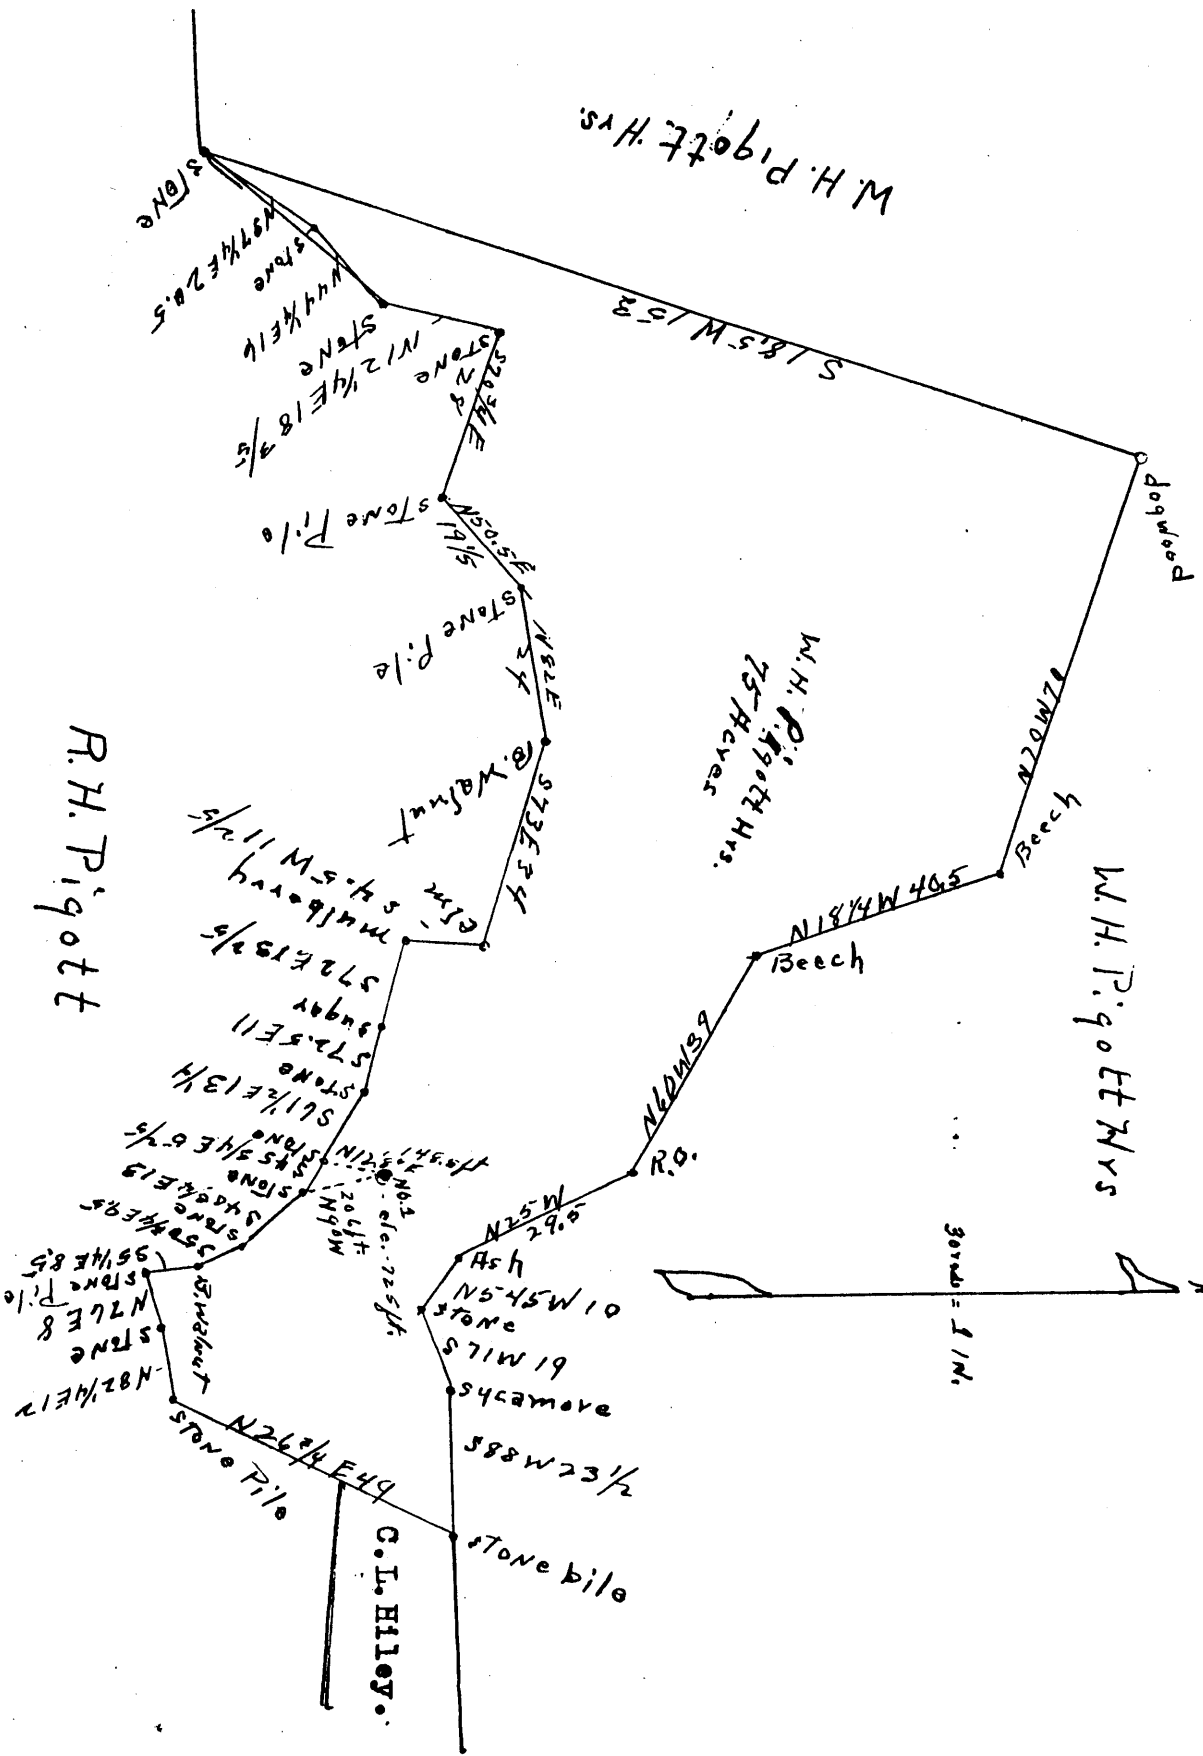

417134

I, the undersigned, hereby certify that this map is correct and shows all the information to the best of my knowledge and belief, required by the oil and gas section of the Mining Laws of West Virginia.

H. L. Hammond, Surveyor.

Dod-52

APR 19 1934



STATE OF WEST VIRGINIA
DEPARTMENT OF MINES
OIL AND GAS DIVISION

401

WELL RECORD

Permit No. DOD-52

Oil or Gas Well (KIND)

Company J. J. Graham, et al
 Address West Union, West Virginia
 Farm W. H. Figott Acres 75
 Location (waters) Arnolds Creek
 Well No. 1 Elev. 725.'
 District Central County Doddridge
 The surface of tract is owned in fee by _____
 Address _____
 Mineral rights are owned by W. H. Figott Hrs
 Address Central Station, W. Va.
 Drilling commenced _____
 Drilling completed August 30, 1935
 Date Shot From 1708 To 1725'
 With _____
 Open Flow /10ths Water in _____ Inch
 /10ths Merc. in _____ Inch
 Volume _____ Cu. Ft.
 Rock Pressure _____ lbs. _____ hrs.
 Oil _____ bbls., 1st 24 hrs.
 Fresh water 45 feet 190 feet
 Salt water _____ feet _____ feet

Casing and Tubing	Used in Drilling	Left in Well	Packers
Size			Kind of Packer
16			
13		16	
10		411	Size of
8 1/4		888	
6 1/2		1653	Depth set
5 3/16			
3			Perf. top
2			Perf. bottom
Liners Used			Perf. top
			Perf. bottom

CASING CEMENTED _____ SIZE _____ No. Ft. _____ Date _____
 COAL WAS ENCOUNTERED AT 407 FEET 24 INCHES
 _____ FEET _____ INCHES FEET _____ INCHES
 _____ FEET _____ INCHES FEET _____ INCHES

Formation	Color	Hard or Soft	Top	Bottom	Oil, Gas or Water	Depth Found	Remarks
Conductor				16			
Water				45			
Water				190			
Pittsburgh Coal			407	408			
Little Dunkard			780	786			
Big Dunkard			322	095			
Gas Sand			1078	1120			
First Salt Sand			1150	1200			
Second Salt Sand			1215	1275			
Third Salt Sand			1370	1460			
Maxon Sand			1510	1530			
Little Lime			1594	1608			
Blue Monday			1609	1632			
Big Lime			1632	1703			
Big Injun			1703	1801			
Gas			1708	1725			
Total Depth				1801			