


Latitude 39° 25'

Longitude 80° 45'

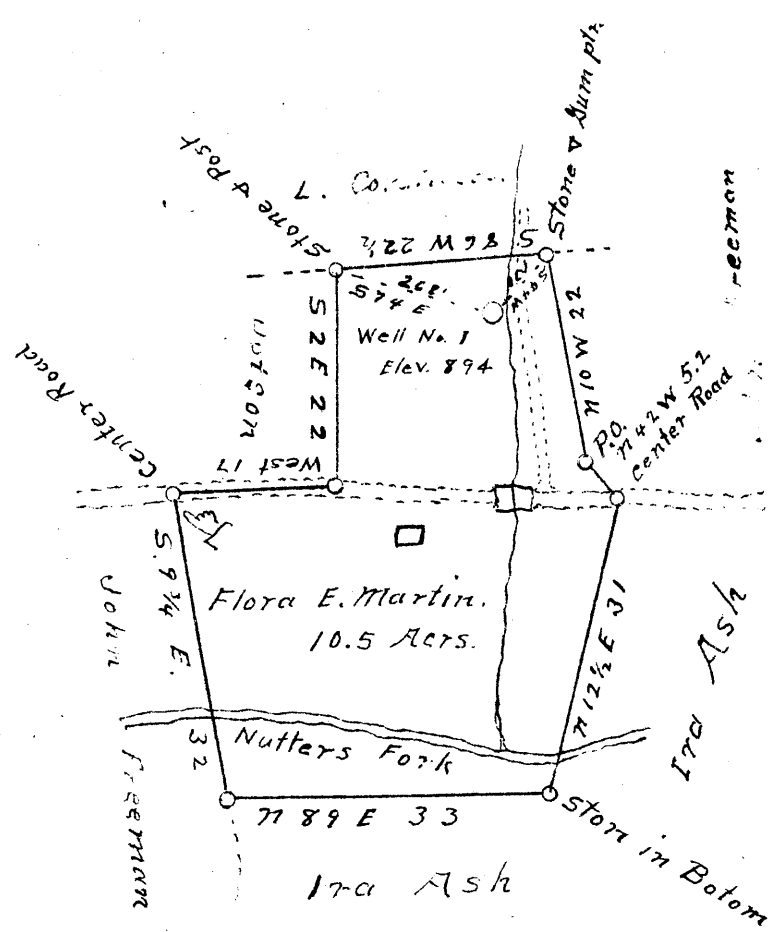

W-1.6
S-5.7

New Location
 Drill Deeper
 Abandonment

Company Braden & Creighton
 Address Marietta, Ohio.
 Farm Flora E. Martin
 Tract One Acres 10.5 Lease No. _____
 Well (Farm) No. _____ Serial No. _____
 Elevation (Spirit Level) 894
 Quadrangle West Union 26
 County Doddridge District West Union
 Engineer J. M. Martin
 Engineer's Registration No. 84
 No. _____ Drawing No. _____
March 5 1941 Scale 40 Poles = 1"

STATE OF WEST VIRGINIA
 DEPARTMENT OF MINES
 OIL AND GAS DIVISION
 CHARLESTON

WELL LOCATION MAP
 FILE NO. DOD-114

+ Denotes location of well on United States Topographic Maps, scale 1 to 62,500, latitude and longitude lines being represented by border lines as shown.
 - Denotes one inch spaces on border line of original tracing.

WEST VIRGINIA DEPARTMENT OF MINES
OIL & GAS DIVISION
W E L L R E C O R D

Permit No. Dod-114
West Union Quad.

Oil & Gas Well

Company Braden & Creighton
Address Marietta, Ohio
Farm Flora E. Freeman Martin ACRES 35
Location Nutters Fork
Well No. 1 ELEV. -
District West Union - Dodridge County
Surface & Mineral Flora Martin, et al, West Union, W.Va.
Commenced May -
Completed June -
Shot June - depth 1972-2581
Open Flow 6/10ths W in 2 inch
Volume 115,968 c.f.
Oil 1/2 bbl.
Water -

CASING & TUBING
10 627
8-1/4 1080
6-5/8 1751 1751
Coal at 512 & 1040

Shale	bl	s	0	15
Shale	rd	s	15	25
Sand			25	40
Shale	bl	s	40	80
Lime	gr	s	80	100
Slate			100	180
Shale	rd	s	180	225
Slate	bl	s	225	260
Coal			260	265
Slate	bl	s	265	300
Shale	rd	s	300	330
Lime		h	330	370
Red Rock		h	370	375
Lime		h	375	385
Slate	bl	s	385	430
Sand		h	430	445
Shale	rd	s	445	455
Slate	bl	s	455	485
Lime		h	485	512
Coal			512	516
Lime		h	516	550
Slate	bl	s	550	580
Lime	wh	h	580	585
Sand		h	585	604
Shells&Slate		s	604	640
Shale	rd	s	640	704
Slate	bl	s	704	710
Sand		h	710	725
Slate	bl	s	725	745
Shells		s	745	825
Shells		s	825	850
Shale	rd	s	850	900
Slate	bl	s	900	930
Slate	bk	s	930	955
Slate	bl	s	955	1020
Slate	bk	s	1020	1040
Coal			1040	1045
Shells & Slate			1045	1052
Shale	pink	s	1052	1060
Slate	bl	s	1060	1230
Slate	bk	s	1230	1245
Sand		h	1242	1280
Slate	bl	s	1280	1360
Sand		h	1360	1400
Slate	bl	s	1400	1500
Sand		h	1500	1615
Slate	bl	s	1615	1751
Lime		h	1751	1919
Injun Sand		h	1919	1972
Shells			1972	2560
Stray Sand		h	2560	2565

Cave Slate	2574	2579	
Gordon Sand	2579	2581	
Slate - blue	2581	2616	
Show of Oil	1905	1919	No Gas
Oil & Gas	1964	1972	
Gas	2579	2581	
No Water			
Shot 150 lbs. Gelatin	1964	1972	
Shot 50 lbs. "	2579	2581	

1751
1040
1017