


M

Latitude 39 20

Longitude 80 40

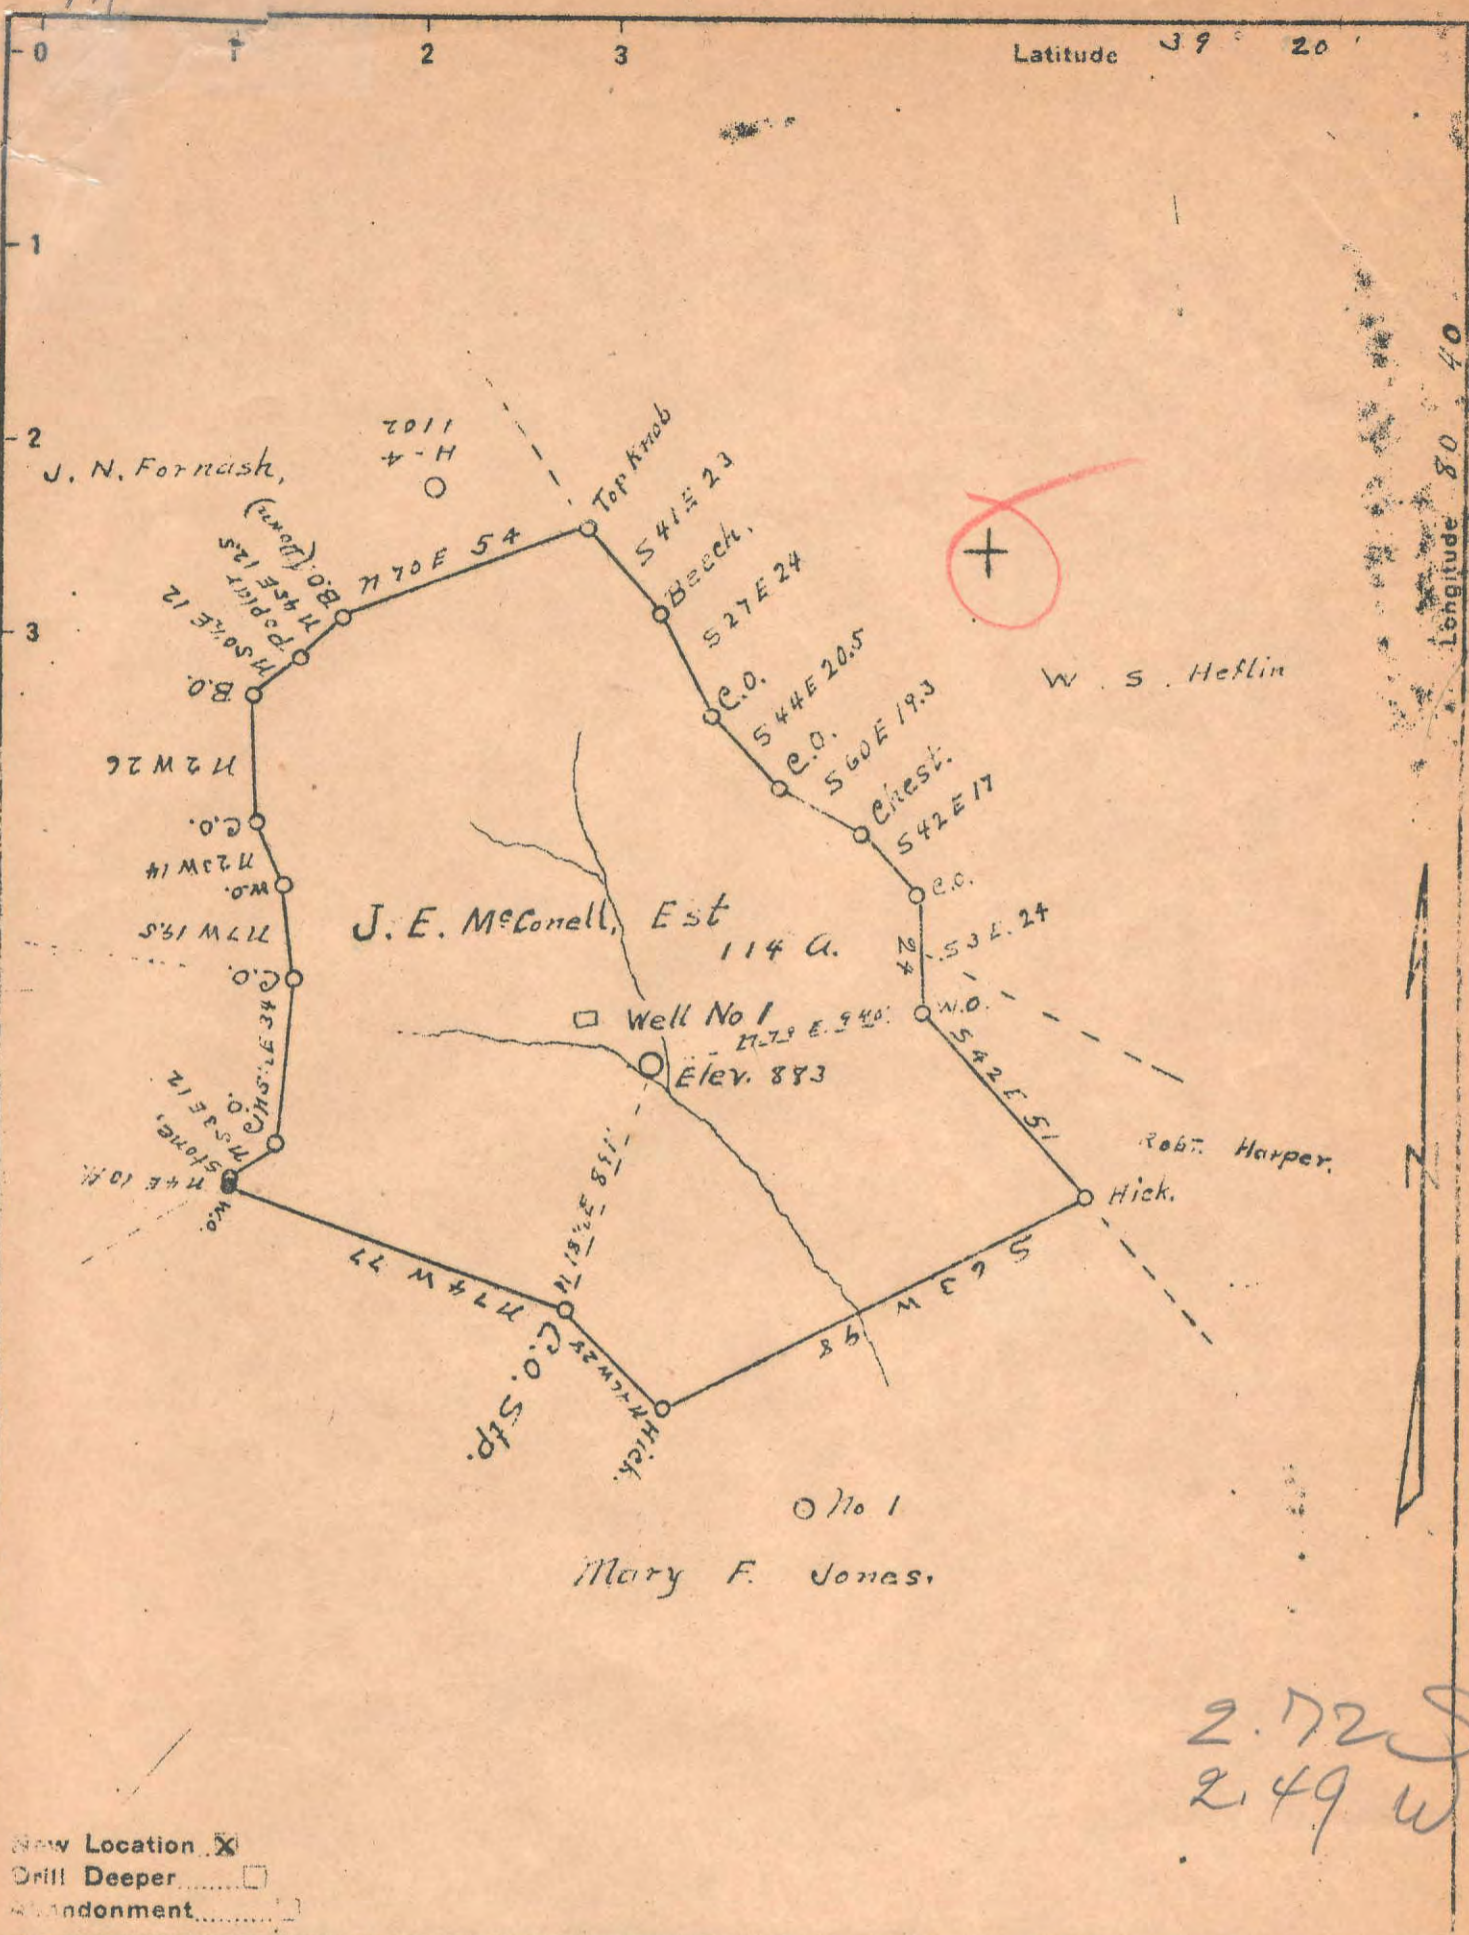

2.72 S
2.49 W

- New Location
- Drill Deeper
- Abandonment

Company Ed Tate & W. D. Grible
 Address West Union, W. Va.
 Farm J. E. McConnell, Est.
 Tract One Acres 114 Lease No. _____
 Well (Farm) No. 1 Serial No. _____
 Elevation (Spirit Level) 883
 Quadrangle Centerpoint. SW
 County Doddridge District West Union
 Engineer J. M. Martin,
 Engineer's Registration No. 84
 File No. _____ Drawing No. _____
 Date May 22, 1924 Scale 40 P. 1"

STATE OF WEST VIRGINIA
 DEPARTMENT OF MINES
 OIL AND GAS DIVISION
 CHARLESTON

WELL LOCATION MAP
 FILE NO. DOD-129

- + Denotes location of well on United States Topographic Maps, scale 1 to 62,500, latitude and longitude lines being represented by border lines as shown.
- Denotes one inch spaces on border line of original tracing.

6-699

✓

WEST VIRGINIA DEPARTMENT OF MINES
OIL & GAS DIVISION
W E L L R E C O R D

Permit No. Dod 129
Centerpoint Quad.

Company

Address

Farm

Location

Well No

District

Surface

Mineral

Commenced

Completed

Date shot

Open flow

Rock Pressure

Ed Tate & W.D. Gribble

West Union, W.Va.

J.E. McConnell Estate Acres 114

England's Run

One

Elev. 883'

West Union

Doddridge County

J.E. McConnell, Hrs., Smithburg, W.Va.

J.E. McConnell, Hrs., Smithburg, W.Va.

June 24, 1942

Jan. 25, 1943

Dec. 16, 1942 Depth 1640 to 1660

with 200 lbs. 100% gelatin

66/10ths W in 1 1/4"

375 lbs. 24 hrs.

Gas Well
CASING & TUBING

10 263'9 Pulled

8 1/2 836'5 Pulled

6 5/8 1673'8

Anchor Packer

Size 6 5/8

Depth 1703'

Perf. bot 145'

No coal

Sand	Wh	H	0	120	
Slate		H	120	298	
Lime		H	298	315	
Slate		H	315	415	
Red Rock		S	415	585	
Slate	Wh		585	606	
Lime	Wh	H	606	626	
Slate		S	626	648	
Red Rock		S	648	677	
Lime	Wh	H	677	699	
Slate	Wh	H	699	730	
L. Dunkard	Wh	H	730	740	
Slate		H	740	760	
Slate	Bk	S	760	830	
Lime		H	830	832	
Slate	Bk	S	832	845	
Gas Sand		H	845	880	
Slate		S	880	888	
Lime		H	888	900	
1st Salt Sand	Wh	H	900	935	
Slate	Bk	S	935	942	
Sand	Wh	S	1010	1020	
Sand		H	1020	1055	
Slate	Bk	S	1055	1090	
2nd Salt Sand		H	1090	1173	
Slate	Bk	S	1173	1192	Gas 1200-1207 30/10 W in 1"
3rd Salt Sand		H	1192	1490	Gas 1530-1533 16/10 in 1"
Slate	Dk	S	1490	1521	
Maxon	Dk	H	1521	1551	
Slate			1551	1600	
L. Lime	Dk	H	1600	1612	
Slate		S	1612	1622	
Lime	Wh		1622	1627	
Red Rock			1627	1638	
Blue Monday			1638	1660	Gas 1640-1643 50/10 W in 1 1/2"
Big Lime			1660	1739	Gas 1650 22/10 W in 2"
Big Injun			1739	1819	Gas 1793 1795 27/10 W in 1 1/4"
TOTAL DEPTH			1848		TOTAL GAS 66/10 W in 1 1/4"