
39 Latitude

South PENN O. Co.

- 2

- 3

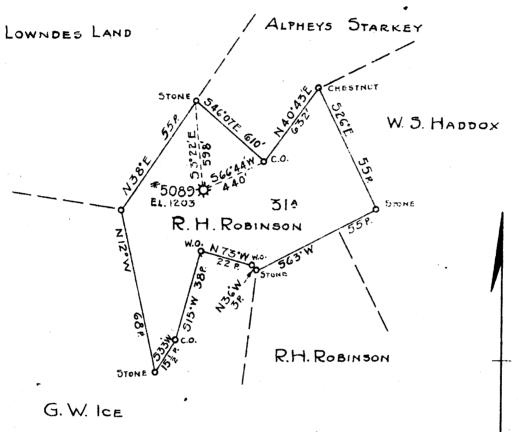

New	Location	
Drill	Deeper x	
	donment	

Map Sh. 45 Sq. 5.3 E1 F.B. 591 P. 35

Company Hope Natural Gas Co.					
Address Clarksburg W.Va.					
Farm R.H. Robinson					
Tract Acres 31 Lease No. 32697					
Well (Farm) NoSerial No. 5089					
Elevation (Spirit Level) 1203					
Quadrangle Centerpoint					
County Doddridge District McClellan					
Engineer WM Bawers					
Engineer's Registration No. 900					
File No Drawing No					
Date 7-6-44 Scale 1"= 40 Po.					
"'IMPERIAL" TRACING CLOTI: K & E CO., N V.					

STATE OF WEST VIRGINIA DEPARTMENT OF MINES OIL AND GAS DIVISION CHARLESTON

WELL LOCATION MAP

FILE NO. 101 - 148

+ Denotes location of well on United States

- Topographic Maps, scale 1 to 62,500, latitude and longitude lines being represented by border lines as shown.
- Denotes one inch spaces on border the of original tracing.

CNG maps

WEST VIRGINIA DEPARTMENT OF MINES OIL AND GAS DIVISION WELLERECORD

Permit No. Dod 148 Gas Well Centerpoint Quad. CASING & TUBING Hope Natural Gas Company 445 West Main St., Clarksburg, W.Va. Company 10 406 Pulled Address 8½ 1327 1327 6 5/8 2196 2196 Farm R.H. Robinson Acres 31 Location Well No. 5089 Elev. 1203 5 3/16 2930 2930 District McClellan Doddridge County Surface Casing not cemented Mineral Coal at 320 36" Commenced May 27,1944 Sept. 15, 1944 800' 8-11-44 Depth 2965 to 2974 with 20 qts. 8001 4811 Completed Date shot Open flow 8/10ths M in 1" FM Volume 78 M No water recorded

DRILLED DEEPER

Started drilling		2292		
Bottom Injun		2319		
Berea	2489	2540		
Gordon Stray	2897	2925		
Gordon Sand	2966	2975	Gas	2969-2974
Fourth	2988	2994		
Fifth Sand	3009	3011	Gas	3009
TOTAL DEPTH		3065		

R. H. ROBINSON NO. 5089 WELL.

McClellan District, Doddridge County, W. Va.

By Hope Natural Gas Co., 445 W. Main St., Clarksburg, W. Va.

Drilled under permit Dod-148; Centerpoint Quadrangle.

On 31 acres.

Elevation, 1203' L.

Drilling commenced May 27, 1944; completed Sept. 15, 1944. (Deepening).

Shot Aug. 11, 1944, at 2965-2974', with 20 qts.

Open flow, 8/10ths Merc. in 1° F. M.

Volume, 78,000 cu. ft.

No water recorded.

10" casing, 406' (pulled); 84", 1327'; 68", 2196'; 53", 2930'.

Casing not cemented.

Coal was encountered at 320-323 and 800-804'.

Gas well. Record from Smith Feb. 13, 1945.

	Top.	Bot tom.
DRILLED DEEPER:		•
Started drilling		229 2
Bottom Big Injun Sand		2319
Berea Sand	2480	- 2540
Gordon Stray Sand	2897	- 2925
Gordon Sand (gas, 2969-2974')	2966	- 2975
Fourth Sand	2988	- 2994
Fifth Sand (gas, 3009')	30001	3011
Total depth	-	3065