


Latitude 39 20

Longitude 80 40

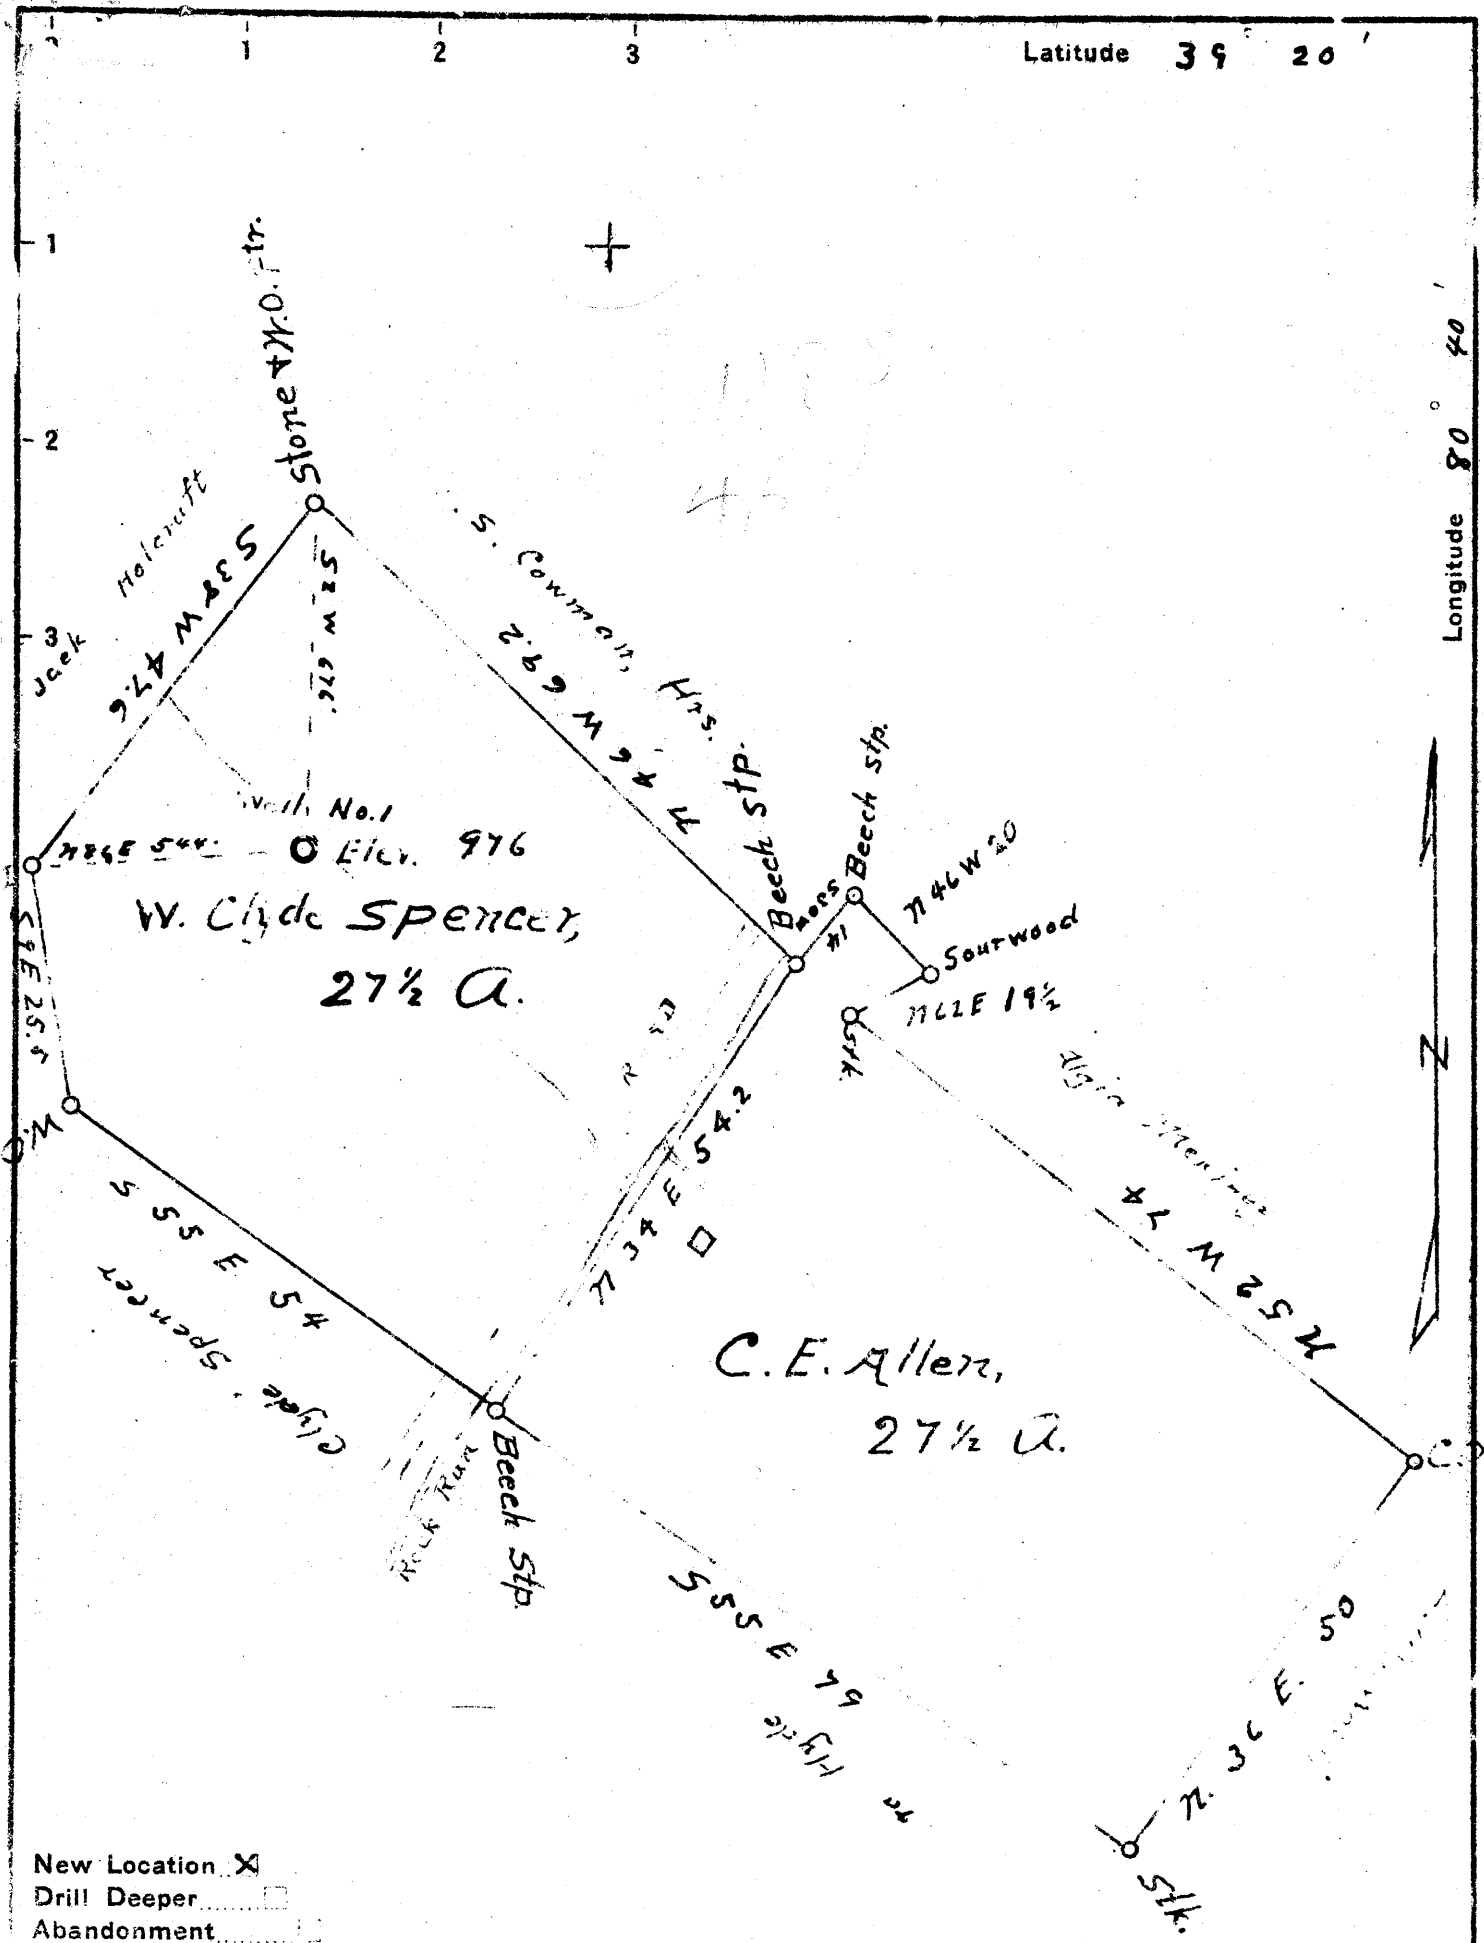

New Location X
 Drill Deeper
 Abandonment

Company W. D. Gribble
 Address West Union, W. Va.
 Farm W. Clyde Spencer & C. E. Allen.
 Tract Two Acres 55 Lease No. _____
 Well (Farm) No. 1 Serial No. _____
 Elevation (Spirit Level) 976
 Quadrangle Centerpoint, SW
 County Doddridge District West Union
 Engineer J. M. Martin,
 Engineer's Registration No. 84
 File No. _____ Drawing No. _____
 Date March 16, 1885 Scale 20 Poles = 1 Inch

STATE OF WEST VIRGINIA
 DEPARTMENT OF MINES
 OIL AND GAS DIVISION
 CHARLESTON

WELL LOCATION MAP

FILE NO. DOD-154

+ Denotes location of well on United States Topographic Maps, scale 1 to 62,500, latitude and longitude lines being represented by border lines as shown.

- Denotes one inch spaces on border line of original tracing

WEST VIRGINIA DEPARTMENT OF MINES
OIL & GAS DIVISION
W E L L R E C O R D

Permit No. Dod 154
Centerpoint Quad.

Company

Address

Farm

Location

Well No.

District

Surface

Mineral

Commenced

Completed

Date shot

Open flow

Volume

Rock Pressure

Fresh Water

Salt Water

W.D. Gribble
West Union, W.Va.
Spencer & Allen, Acres 55
Rock Run
1 Elev. 976
West Union Doddridge County
W.C. Spencer & Cecil Allen
West Union, W.Va.

Same

May 2, 1945

July 11, 1945

July 24 Depth 2578 to 2585

July 25 " 1898 to 1912

with 300# 100% gelatin

" 150# 90% "

6/10ths W in 1"

18,000 C.F.

200 lbs. 24 hrs.

30'

1265'

Gas Well
CASING & TUBING

10 472 None
8 1/2 973 "
6 5/8 1803 1803

Soil	Dk	S	0	10	Slate & S	Dk	H	2010	2115
Sand	Br	S	10	40	Sand	Dk	H	2115	2248
Shale	Dk	S	40	100	Slate & S	Dk	H	2348	2320
Lime	Lt	H	100	160	Sand	Lt	H	2320	2356 <i>Gantz</i>
R. Rock		S	160	190	Slate & S	Dk	H	2356	2560
Sand	Lt	S	190	240	Sand, Gor. Str.	Lt	S	2560	2567
Red Rock		H	240	360	Slate	Bk	S	2567	2576
Sand	Dk	S	360	392	Sand, Gordon	Lt	H	2576	2582
Soapstone	Bl	S	392	417	Slate & S	Dk	H	2582	2830
Lime	Wh	H	417	425	Lime	Wh	H	2830	2850
Slate & S	Dk	H	425	440	Slate & S	Dk	H	2850	2860
Red Rock		S	440	460	Lime	Lt	H	2860	2880
Lime	Lt	H	460	465	Slate	Bk	S	2880	2882
Slate	Dk	S	465	485					
Lime	Lt	H	485	495					
Slate	Dk	S	495	515					
Lime	Wh	H	515	642					
Red Rock		S	642	750					
Slate & S	Dk	H	750	840					
Red Rock		S	840	885					
Sand	Lt	H	885	890					
Slate & S	Dk	S	890	972					
Sand	Lt	H	972	1019					
Slate	Bk	S	1019	1118					
Sand	Dk	H	1118	1155					
Slate	Dk	S	1155	1238					
Sand	Lt	H	1238	1274					
Slate	Bk	S	1274	1315					
Sand	Lt	H	1315	1380					
Slate	Bk	S	1380	1390					
Sand	Wh	H	1390	1445					
Slate & S	Dk	H	1445	1504					
Sand	Lt	H	1504	1620					
Lime	Lt	H	1620	1670					
Sand	Wh	H	1670	1703					
Lime	Wh	H	1703	1733					
Sand	Dk	H	1733	1747					
Slate	Bk	S	1747	1777					
Lime	Lt	H	1777	1789					
Slate	Bk	S	1789	1793					
Big lime	Wh	H	1793	1862					
Big Injun	Lt	H	1862	1942	Gas 1897-1909				
Slate	Dk	S	1942	1945					
Sand	Wh	H	1945	1955					
Slate	Bk	S	1955	1965					
Sand	Lt	H	1965	1989					
Slate	Bk	S	1989	1991					
Sand	Dk	H	1991	2010					