


71

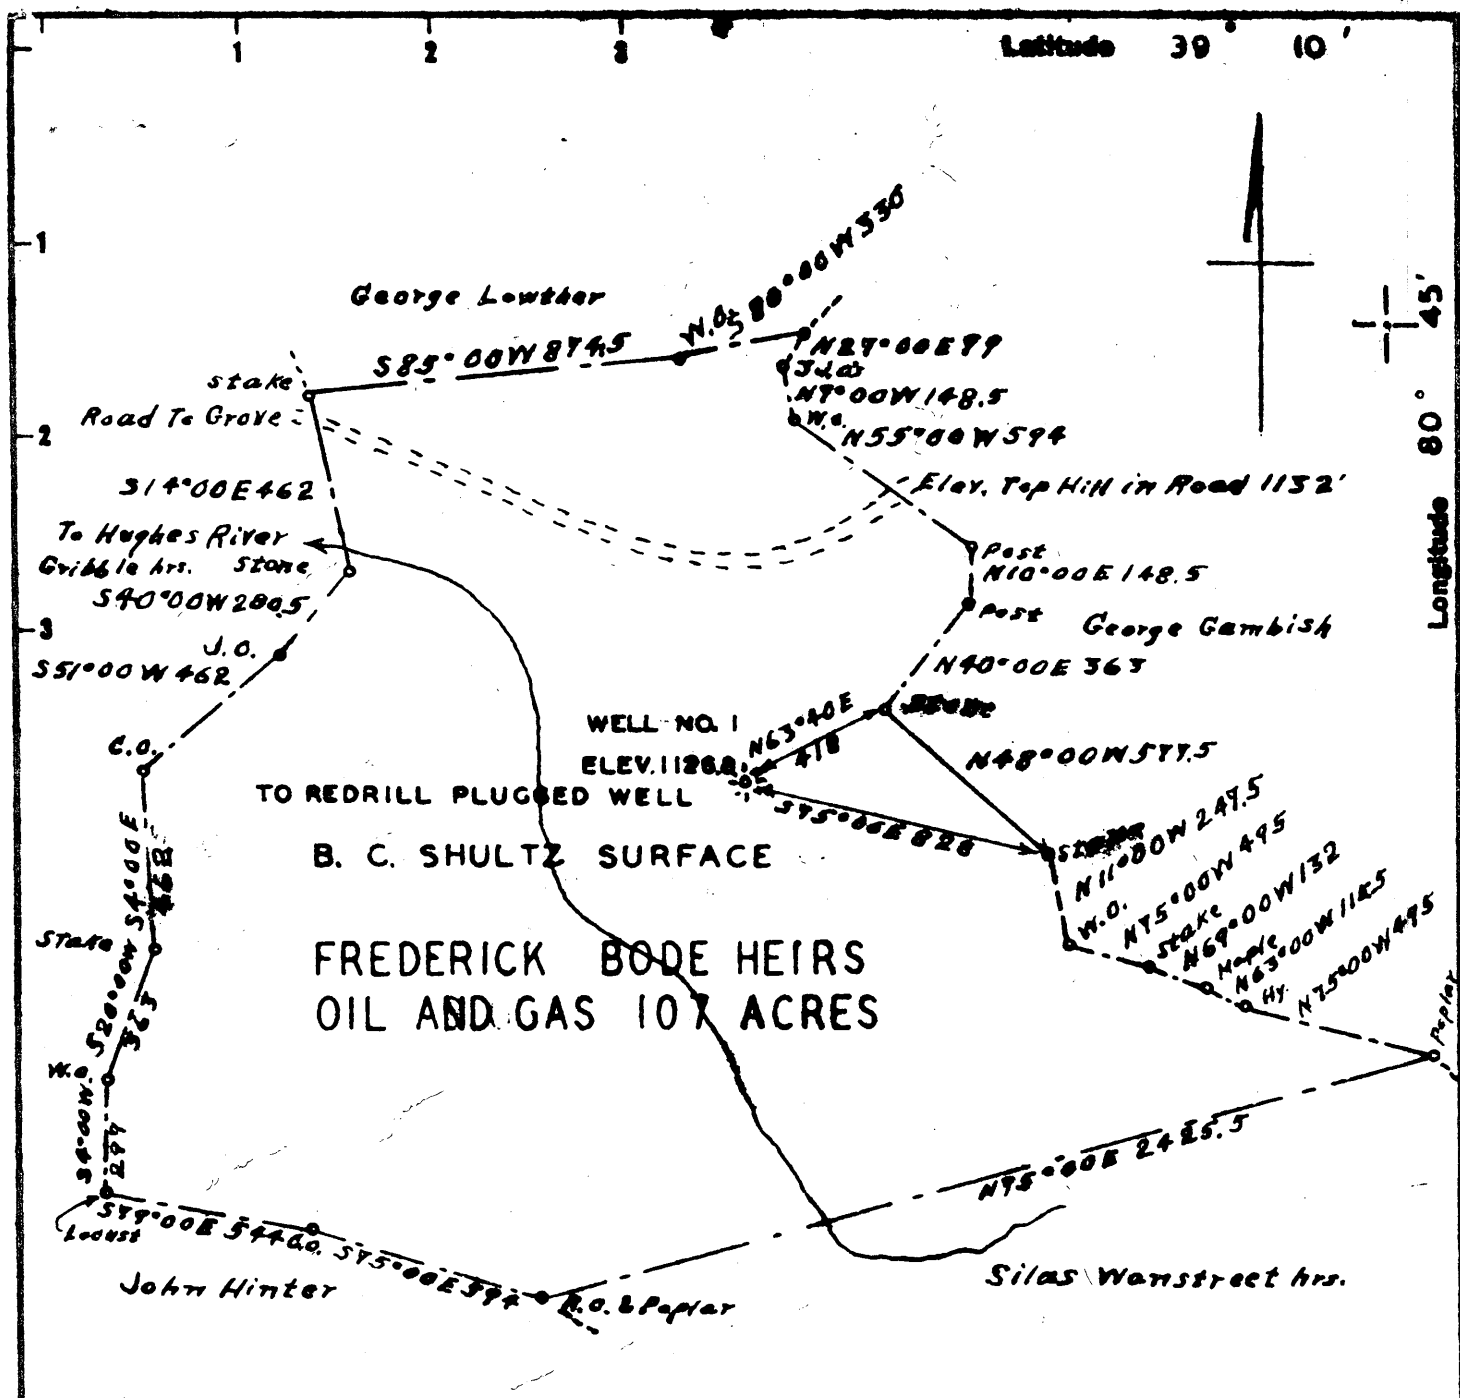

Note - Elev. From Road at Top of Hill Marked on Topo. Map 1132'.
 Error of Closure less than 1/200

I, the undersigned, hereby certify that this map is correct to the best of my knowledge and belief and shows all of the information supplied by paragraph 6 of the rules and regulations of the oil and gas section of the mining laws of West Virginia.

W. H. H. [Signature]
 E. P. L. No. 1027

REDRILL PLUGGED WELL
 New Location
 Drill Deeper
 Abandonment

Company M. AND M. DRILLING CO.
 Address BOX 11 ALUM BRIDGE, W. VA.
 Farm FREDERICK BODE HEIRS
 Tract _____ Acres _____ Lease No. _____
 Well (Farm) No. ONE Serial No. _____
 Elevation (Spirit Level) 1126.8'
 Quadrangle HOLBROOK EC
 County DODDRIDGE District COVE
 Engineer [Signature]
 Engineer's Registration No. 1277
 File No. _____ Drawing No. _____
 Date 5/23/63 Scale 1" = 500'

STATE OF WEST VIRGINIA
 DEPARTMENT OF MINES
 OIL AND GAS DIVISION
 CHARLESTON

WELL LOCATION MAP
 FILE NO. DOD-171-Redrill

+ Denotes location of well on United States Topographic Maps, scale 1 to 62,500, latitude and longitude lines being represented by border lines as shown.

- Denotes one inch spaces on border line of original tracing.

WEST VIRGINIA DEPARTMENT OF MINES
OIL & GAS DIVISION
W E L L R E C O R D

Permit No. Dod 181
Holbrook Quad.
Company
Address
Farm
Location
Well No.
District
Surface

Mineral
Commenced
Completed
Fresh Water

Prospect Motors Inc.
185 E. Market St., Akron, Ohio
Bode Acres 107
Middle Fork
1 Elev. 1105
Cove Doddridge County
Prospect Motors, Inc.
185 E. Market St., Akron, Ohio
Bode Heirs
Oct. 20, 1947
Nov. 28, 1947
125'

Dry Hole
CASING & TUBING

13 Cond. 12
10 323
8 1235
6 5/8 2098

Coal at 160' 12"

Slate	0	60
Sand	60	90
Slate	90	260
Red Rock	260	315
Slate & Shells	315	517
Sand	517	534
Red Rock	534	590
Sand	590	615
Slate & Shells	615	654
White Slate	654	676
Red Rock	676	690
Lime	690	720
Slate & Shells	720	860
Red Rock	860	875
Slate	875	887
Red Rock	887	963
White Slate	963	979
Red Rock	979	1010
Slate & Shells	1010	1020
Pink Rock	1020	1035
Slate & Shells	1035	1095
Pink Rock	1095	1155
Slate	1155	1168
Lime	1168	1174
Pink Rock	1174	1205
White Slate	1205	1215
Pink Rock	1215	1223
Sand	1223	1245
Black Slate	1245	1300
Sand	1300	1322
White Slate	1322	1375
Sand	1375	1432
White Slate	1432	1510
Sand	1510	1547
Black Slate	1547	1580
Sand	1580	1630
Slate & Shells	1630	1700
Sand	1700	1740
Slate	1740	1750
Sand	1750	1830
Slate	1830	1880
Sand	1880	1955
Black Slate	1955	1990
Red Slate	1990	2025
Slate & Shells	2025	2045
Pencil Cave	2045	2052
Broken Lime	2052	2094
Big Lime	2094	2150
Injun Sand	2150	2240
Show of gas 2164		
Slate & Shells	2240	2340
Sand	2340	2494
Slate & Shells	2494	2752
Sand	2752	2772
Slate	2772	2790
Total Depth	2790	

2094
1105

989

2052
140

2192
1105

2297