


2,425  
1,14W

Longitude 80 40

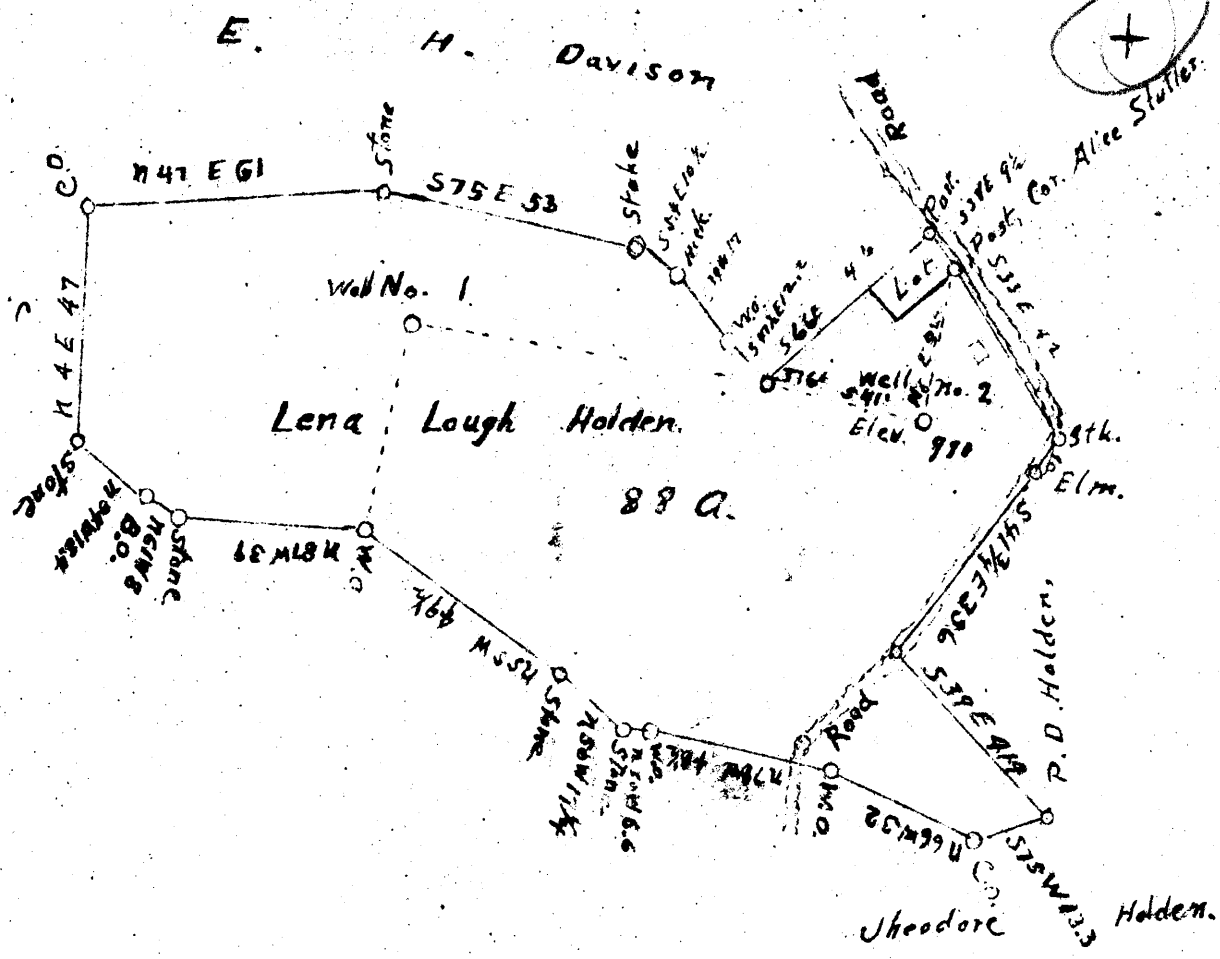

New Location   
 Drill Deeper  
 Abandonment

Company Edmond Tate,  
 Address Smithburg, West Va.  
 Farm Lena Lough Holden,  
 Tract 1 Acres 88 Lease No. \_\_\_\_\_  
 Well (Farm) No. 2 Serial No. \_\_\_\_\_  
 Elevation (Spirit Level) 980  
 Quadrangle Centerpoint SW  
 County  Doddridge District Grant  
 Engineer J. M. Martin,  
 Engineer's Registration No. 84  
 File No. \_\_\_\_\_ Drawing No. \_\_\_\_\_  
 Date Nov 18 1942 Scale 40

STATE OF WEST VIRGINIA  
 DEPARTMENT OF MINES  
 OIL AND GAS DIVISION  
 CHARLESTON

WELL LOCATION MAP  
 FILE NO. DOD-183-#2

+ Denotes location of well on United States Topographic Maps, scale 1 to 62,500, latitude and longitude lines being represented by border lines as shown.

- Denotes one inch spaces on border line of original tracing.

WEST VIRGINIA DEPARTMENT OF MINES  
OIL & GAS DIVISION  
W E L L R E C O R D

Permit No. Dod 183  
Centerpoint Quad.  
Company  
Address  
Farm  
Location  
Well No.  
District  
Surface  
Mineral  
Commenced  
Completed  
Not shot  
Fresh Water  
Salt Water

Edmond Tate  
Smithburg, W.Va.  
Lena Lough Holden A 86  
Morgans Run  
2 Elev. 980  
Grant Doddridge County  
Lena Lough Holden  
Same  
Dec., 10, 1947  
Feb. 27, 1948  
  
95  
1335

Dry Hole  
CASING & TUBING

10 266  
8 1/2 894  
5 3/16 1575

No coal

Top soil		0	15	Big Injun Wh	H	1788	1895
Red Rock	S	15	50	Injun Squaw Gr	H	1895	1907
Blue Mud	S	50	70	Total Depth			1907
Lime Gr	H	70	90	1583 showing of gas but not enough for			
Sand Gr	H	90	125	test			
Slate Dk	S	125	133	Total depth			1907
Slate Broken Dk	S	133	138				
Lime Wh	H	138	175				
Slate Wh	S	175	180				
Lime Wh	H	180	240				
Red Rock	S	240	250				
Lime Wh	H	250	330				
Slate Blk	S	330	385				
Lime Wh	H	385	420				
Slate Blk	S	420	425				
Lime Wh	H	425	445				
Sand Wh	S	445	485				
Lime Wh	H	485	522				
Red Rock	S	522	560				
Sand Gr	S	560	585				
Slate & Shells Gr	S	585	635				
Red Rock	S	635	675				
Lime Gritty	H	675	685				
Slate (Shells) Dk	S	685	700				
Lime Gr	H	700	720				
Slate (Black)	S	720	725				
Lime Gr	H	725	745				
Red Rock	S	745	755				
Lime Wh	H	755	795				
Slate Wh	S	795	805				
Red Rock	S	805	820				
Lime Gr	H	820	885				
Slate Blk	S	885	907				
Lime Gritty Gr	H	907	958				
Slate Wh	H	958	1035				
Lime Gritty Gr	H	1035	1085				
Sand Wh	S	1085	1125				
Slate Blk	S	1125	1140				
Slate Wh	S	1140	1161				
Sand Blk	H	1151	1215				
Slate Wh	S	1215	1280				
Sand Wh	H	1280	1340				
Lime Gr	H	1340	1370				
Sand Gr	H	1370	1385				
Lime Blk	H	1385	1422				
Sand Wh	H	1422	1490				
Lime Dk	H	1490	1525				
Slate Shells Gr	H	1525	1572				
Maxon Sand Wh	S	1572	1615				
Slate Dk	H	1615	1618				
Sand Wh	H	1618	1658				
Slate Blk	S	1658	1661				
Lime Blk	H	1661	1710				
Sand Wh	S	1710	1730				
Big Lime Gr	H	1730	1788				

1710  
1745  
1788  
1895  
1907