

Latitude 39 20

Longitude 80 45'


Claude Smith

Ted Gaskins Sur.
Wm. Ashburn O.G.M.
132 3/4 A.

Aley Williams

John Adams

Abra Freeman

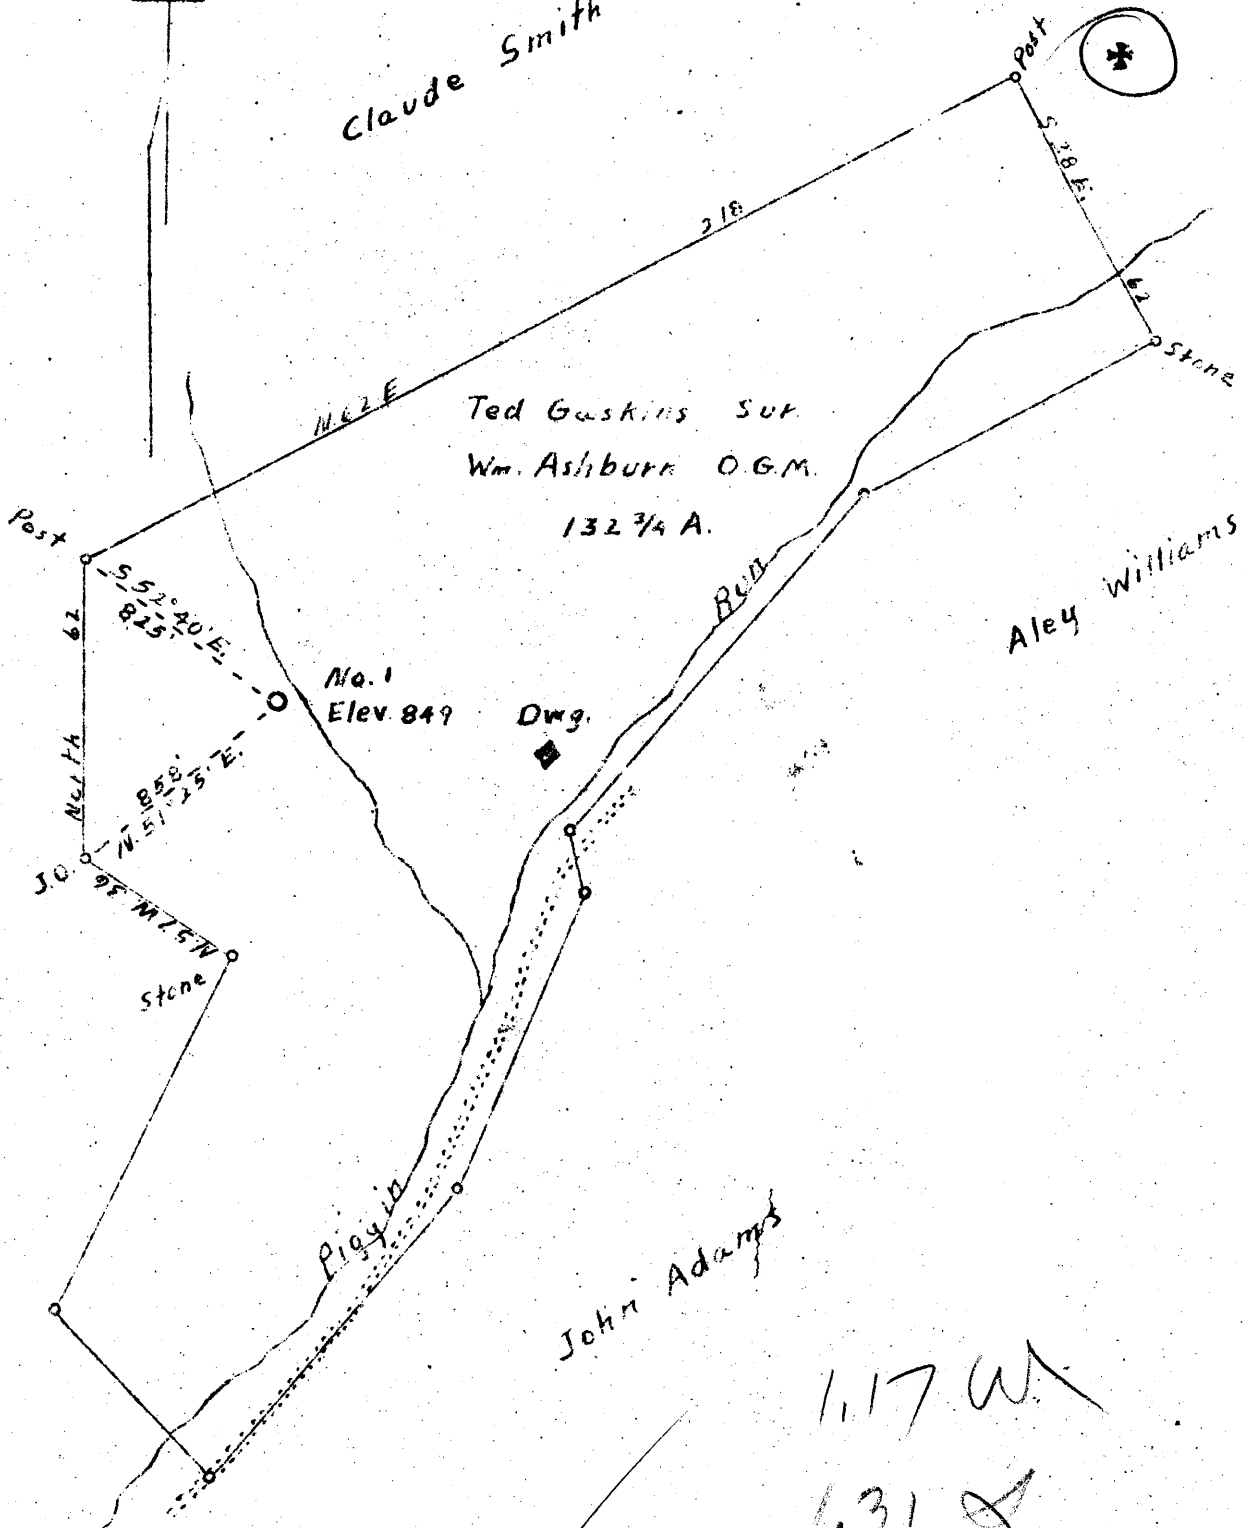

New Location X
Drill Deeper
Abandonment

MAR - 1 1949

Survey & Plot R.K. Westfall

Company J. C. Smith
 Address West Union, W. Va.
 Farm Ted Gaskins
 Tract _____ Acres 132 3/4 Lease No. _____
 Well (Farm) No. 1 Serial No. _____
 Elevation Spirit Level 849
 Quadrangle West Union
 County Doddridge District West Union
 Engineer R. K. Westfall
 Engineer's Registration No. 643
 File No. _____ Drawing No. _____
 Date 1/20/49 Scale 1" = 40 Poles

STATE OF WEST VIRGINIA
DEPARTMENT OF MINES
OIL AND GAS DIVISION
CHARLESTON

WELL LOCATION MAP
FILE NO. DOD-191

+ Denotes location of well on United States Topographic Maps, scale 1 to 62,500 latitude and longitude lines being represented by border lines as shown

- Denotes one inch spaces on border line of original tracing.

5-5 99

TED GASKINS No. 1 -

J. C. SMITH -

DOD-191

WEST VIRGINIA DEPARTMENT OF MINES
OIL & GAS DIVISION
W E L L R E C O R D

Permit No. Dod 191		Gas Well
West Union Quad.		CASING & TUBING
Company	J.C. Smith et al , West Union, W.Va.	
Farm	Ted Gaskins vs Wm. Ashburn Acres 132	
Location	Piggin Run	
Well No.	1 Elev. 849	10 324 None
District	West Union Doddridge County	8 1/2 983 "
Surface	Ted Gaskins, West Union, W.Va.	6 5/8 1777 1777
Mineral	Wm. Ashburn Hrs, West Union, W.Va.	
Commenced	Jan. 22, 1949	
Completed	March 21, 1949	
Not shot		
Open flow	64/10ths W in 1"	

Gravel	0	14
Red Rock	14	135
Lime Shells	125	150
Red Rock	150	200
Sand	200	214
Red Rock	214	225
Coal Blossom	225	226
Lime Shells	226	320
Red Rock	320	340
Sand	340	380
Lime	380	432
Red Rock	432	462
Lime	462	470
Coal Blossom	470	471
Lime	471	685
Red Rock	685	730
Slate	730	745
Red Rock	745	755
Broken Lime	755	800
Blue Mud	800	815
Red Rock	815	876
Broken Lime	876	894
Red Rock	894	911
Sand	911	930
Lime Broken	930	994
Sand	994	1047
Slate Shells	1047	1079
Lime Gritty	1079	1115
Slate Shells	1115	1140
Sand	1140	1171
Slate Shells	1171	1214
Lime Gritty	1214	1238
Sand	1238	1322
Slate	1322	1325
Sand	1325	1369
Slate Shell	1369	1448
Sand	1448	1531
Slate	1581	1586
Sand	1586	1657
Red Rock	1657	1695
Sand (Shells) (Maxon)	1695	1700
Pink Rock	1710	1714
Slate	1714	1724
Black Lime , Little Lime	-1724	1739
Slate Pencil Cave	1739	1745
Sand Blue Monday	1745	1758
Lime Big Lime	-1758	1832
Sand	1832	1928
Black Lime	1928	1935
Squaw Sand	1935	1953
Slate Shells	1953	1968

*West Union
SE
117 W
1315*

*1758
153
1913
849
1064*

Gas 1877