


Latitude 39° 25'

Longitude 80° 30'

Scale 1" = 800 Feet

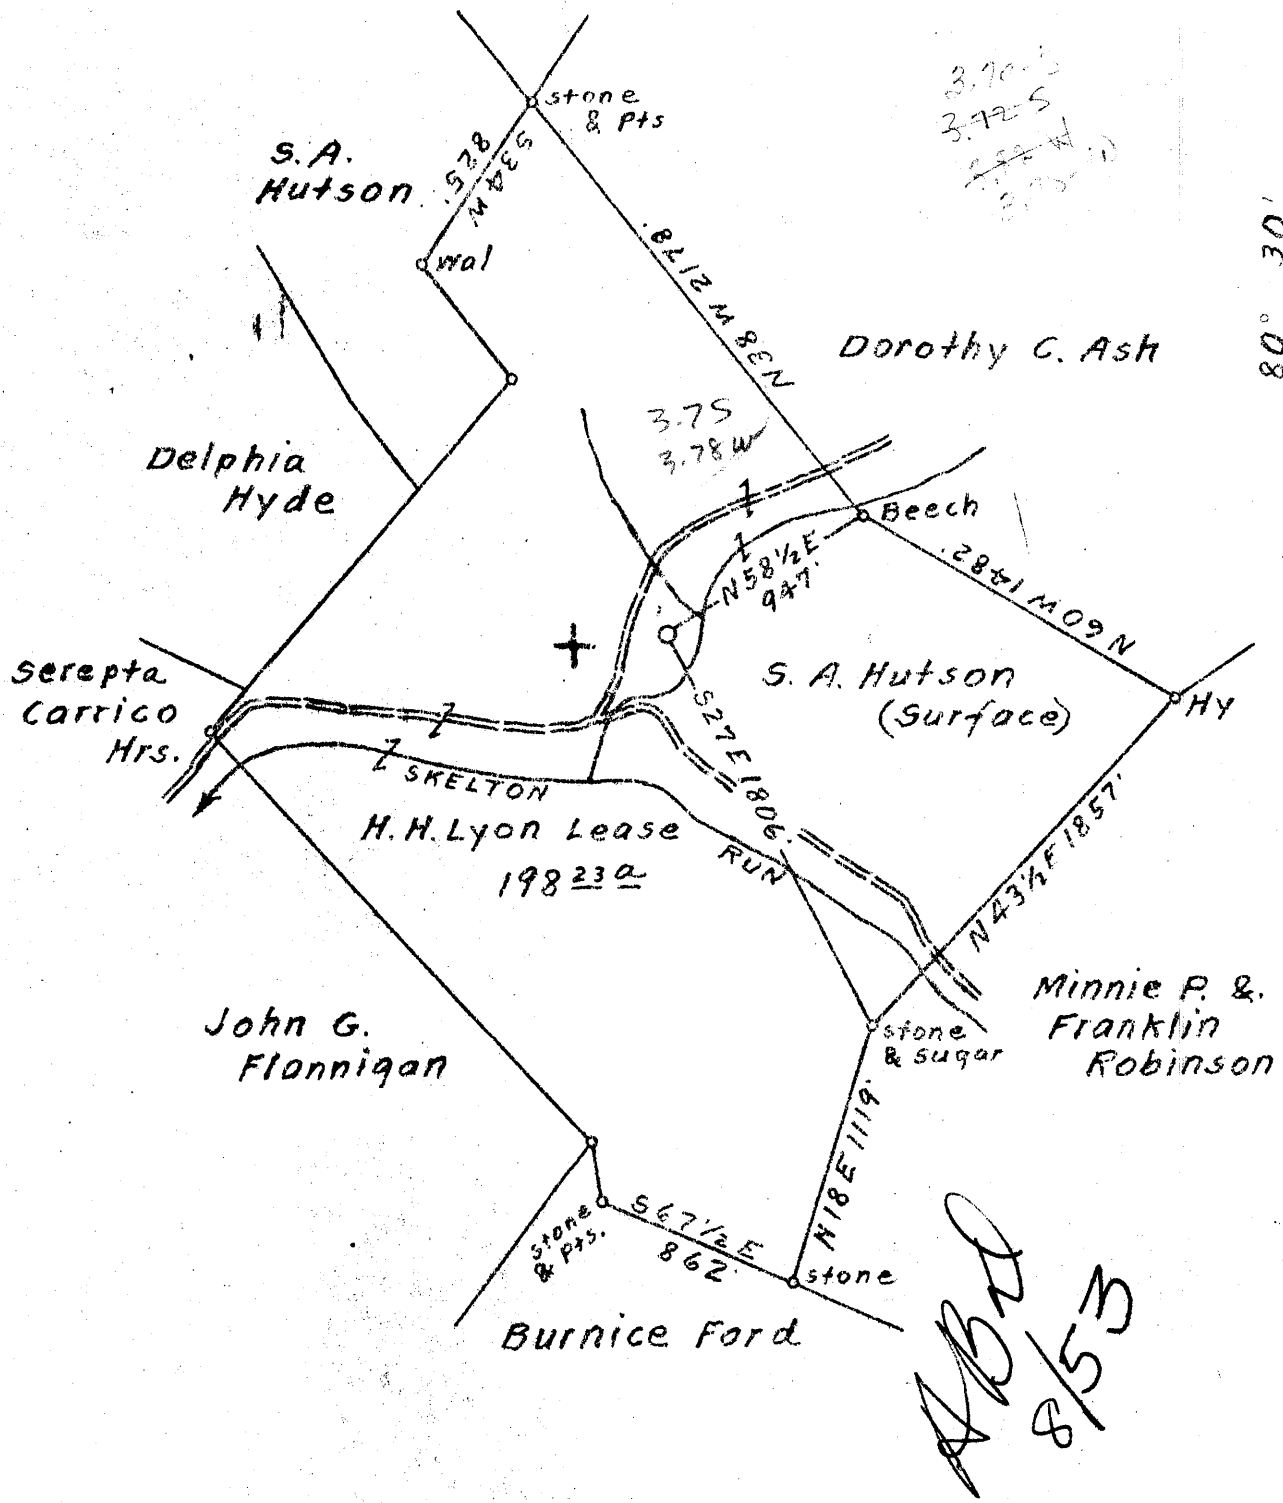

Surface owned by S. A. Hutson.
 Address: Mr. S. A. Hutson, R.F.D. No. 2, Salem, W. Va.
 Coal owned by Willis G. Tetrick Jr. et al.
 Address: Mr. Willis G. Tetrick Jr. P.O. Box 267, Clarksburg, W. Va.

New Location
 Drill Deeper
 Abandonment

On 800' Map N38 Sqs. 56-7 E3.

Company	<u>William Moses</u>
Address	<u>Salem, W. Va.</u>
Farm	<u>H. H. Lyon</u>
Tract	Acres <u>198²³</u> Lease No. _____
Well (Farm) No.	<u>1.</u> Serial No. _____
Elevation (Spirit Level)	<u>Ground-868.90</u>
Quadrangle	<u>Centerpoint</u> EC
County	<u>Doddridge</u> District <u>McClellan</u>
Engineer	<u>Elsworth Haines</u>
Engineer's Registration No.	<u>2221.</u>
File No.	_____ Drawing No. _____
Date	<u>Jan. 23rd, 1952.</u> Scale 1" = 800 Feet

STATE OF WEST VIRGINIA
 DEPARTMENT OF MINES
 OIL AND GAS DIVISION
 CHARLESTON

WELL LOCATION MAP
 FILE NO. DOD-201

+ Denotes location of well on United States Topographic Maps, scale 1 to 62,500, latitude and longitude lines being represented by border lines as shown.
 - Denotes one inch spaces on border line of original tracing.



STATE OF WEST VIRGINIA
DEPARTMENT OF MINES
OIL AND GAS DIVISION

Centerpoint

WELL RECORD

Permit No. DOD-201


Oil or Gas Well Gas
(KIND)

Company William Moses
Address Salem, W. Va.
Farm H. H. Lyons Acres 198+
Location (waters) _____
Well No. One Elev. 868.9'
District McClelland County Doddridge
The surface of tract is owned in fee by _____
Address _____
Mineral rights are owned by _____
Address _____
Drilling commenced February 20 1952
Drilling completed March 24, 1952
Date Shot 3/25/52 From 2673 To 2684
With 60 Quarts 1995-2007--20Qts.
Open Flow 90/10ths Water in 1" Inch
_____/10ths Merc. in _____ Inch
Volume 65,000 Cu. Ft.
Rock Pressure 25# lbs. 24 hrs.
Oil _____ bbls., 1st 24 hrs.
Fresh water 65feet & 304 feet _____ feet
Salt water 1510 feet _____ feet

Casing and Tubing	Used in Drilling	Left in Well	Packers
Size			
16			Kind of Packer
13	<u>21</u>	<u>21</u>	
10	<u>200</u>	<u>200</u>	Size of
8 1/4	<u>1166</u>	<u>Pulled</u>	
6 3/4	<u>1890</u>	<u>1890</u>	Depth set
5 3/16			
3			Perf. top
2			Perf. bottom
Liners Used			Perf. top
			Perf. bottom

CASING CEMENTED _____ SIZE _____ No. Ft. _____ Date _____
COAL WAS ENCOUNTERED AT 606 FEET 120 INCHES
____ FEET _____ INCHES FEET _____ INCHES
____ FEET _____ INCHES FEET _____ INCHES

Formation	Color	Hard or Soft	Top	Bottom	Oil, Gas or Water	Depth Found	Remarks
		Gravel	0	21			
		Sandstone	21	50			
		Slate	50	92	42		
		Red Rock	92	98	6		
		Slate	98	201	103		
		Lime	201	275	74		
		Sand	275	315	40		
		Slate	315	345	30		
		Lime	345	373	28		
		slate	373	522	153		
		Lime	522	537	15		
		slate	537	606	69		
		P. Coal	606	616			
		slate	616	638			
		Sand	638	663			
		Lime	663	694			
		slate	694	760			
		red rock	760	836			
		slate	836	980			
		sand	980	989			
		slate	989	1012			
		lime	1012	1028			
		sand	1028	1040			
		slate	1040	1065			
		sand	1065	1075			
		slate	1075	1140			
		lime	1140	1162			
		B. Dunkard	1162	1189			
		slate	1189	1202			
		Gassand	1202	1268			
		slate	1268	1435			
		Sand	1435	1445			
		Lime	1445	1470			
		Salt Sand	1470	1533			
		Slate	1533	1683			
		Maxon Sand	1683	1731			
		Lime	1731	1790			
		Red Rock	1790	1816			
		Slate	1816	1830			

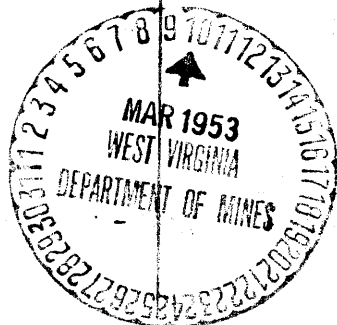

Formation	Color	Hard or Soft	Top	Bottom	Oil, Gas or Water	Depth Found	Remarks
		L. Lime	1830	1842			
		Pencil cave	1842	1860			
		B. Lime	1860	1921			
		Big Injun	1921	2024	Gas 1925-1930	Gas	1995-2007
		Slate	2024	2042			
		Lime	2042	2270			
		Shale	2270	2350			
		Lime	2350	2510			
		slate	2510	2566			
		Sand	2566	2580			
		Fifty Foot	2580	2602			
		Slate	2602	2637			
		Broken Sand	2637	2655			
		Gordon Stray	2655	2688	Gas show at 2684		
		Slate	2688	2710			
		Gordon	2710	2720			
		Slate	2720	2762			
		Total Depth		2762			

Date _____, 19____

APPROVED _____, Owner

By _____ (Title)