


Latitude 39° 30'

#1 DHC REP

Longitude 80° 30'

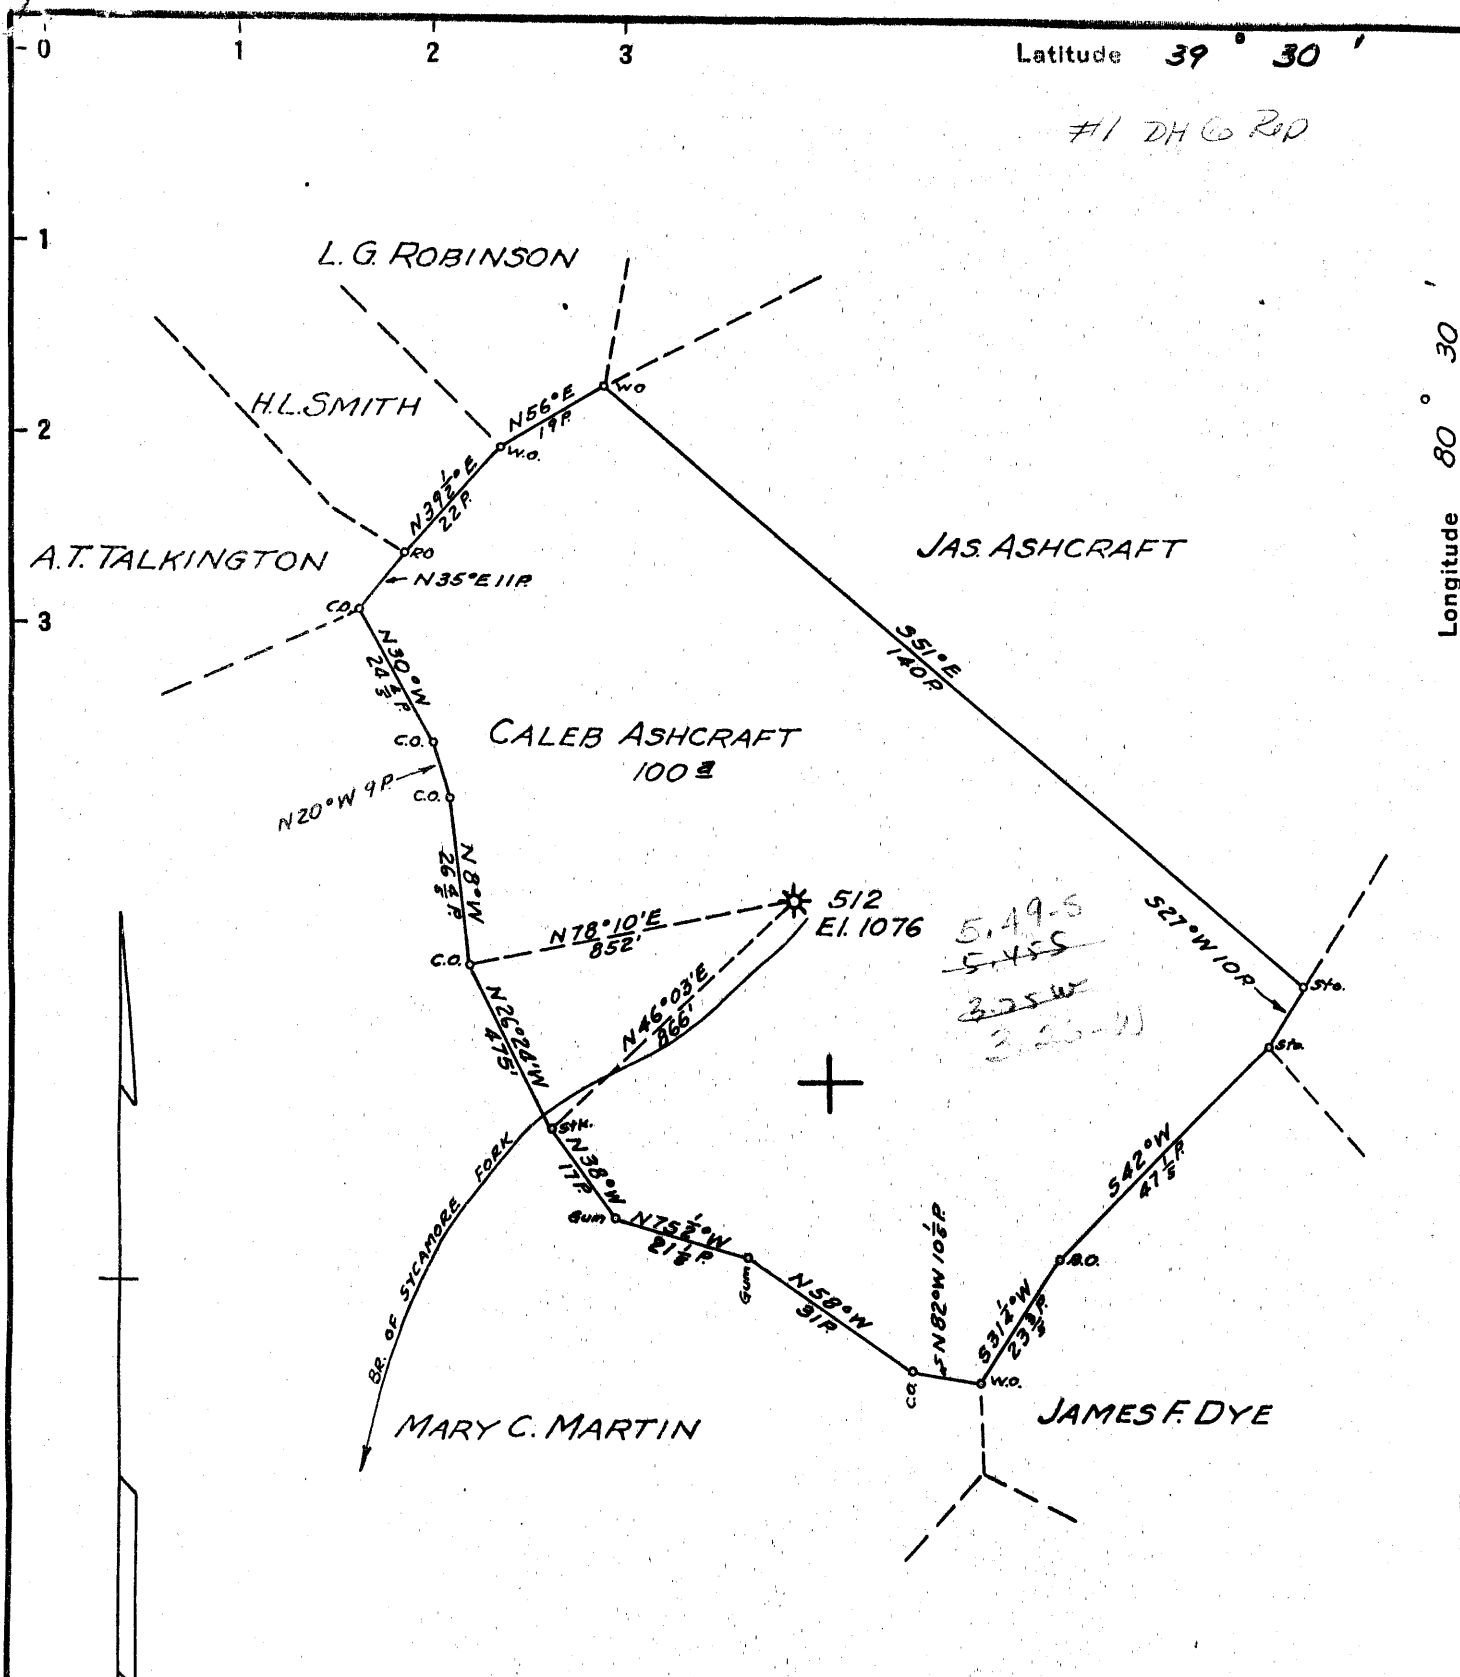

- New Location...
- Drill Deeper.....
- Abandonment.....

Map Sheet 45 Squares S2E4.F.B. 543P34 & 36

Company HOPE NATURAL GAS CO.

Address CLARKSBURG, W. VA.

Farm CALEB ASHCRAFT

Tract _____ Acres 100 Lease No. 1903

Well (Farm) No. 1 Serial No. 512

Elevation (Spirit Level) 1076

Quadrangle CENTERPOINT NE

County DODDRIDGE District McCLELLAN

Engineer Wm Rowers

Engineer's Registration No. 900

File No. _____ Drawing No. _____

Date JULY 1, 1954 Scale 1" = 30 P

STATE OF WEST VIRGINIA
DEPARTMENT OF MINES
OIL AND GAS DIVISION
CHARLESTON

WELL LOCATION MAP

FILE NO. DOD-206-D

+ Denotes location of well on United States Topographic Maps, scale 1 to 62,500, latitude and longitude lines being represented by border lines as shown.

- Denotes one inch spaces on border line of original tracing.





STATE OF WEST VIRGINIA
DEPARTMENT OF MINES
OIL AND GAS DIVISION

Quadrangle Centerpoint

WELL RECORD

Permit No. Dod-206-D

Oil or Gas Well Gas
(KIND)

Company Hope Natural Gas Company
Address 445 West Main St., Clarksburg, W. Va.
Farm Caleb Ashcraft Acres 100
Location (waters) _____
Well No. 512 Elev. 1076
District McClellan County Doddridge
The surface of tract is owned in fee by _____
Address _____
Mineral rights are owned by _____
Address _____
Drilling commenced June 28, 1954
Drilling completed July 20, 1954
Date Shot Not Shot From _____ To _____
With _____
Open Flow _____ /10ths Water in _____ Inch
_____ /10ths Merc. in _____ Inch
Volume 87 M Cu. Ft.
Rock Pressure No test lbs. _____ hrs.
Oil None bbls., 1st 24 hrs.
Fresh water None feet _____ feet
Salt water None feet _____ feet

Casing and Tubing	Used in Drilling	Left in Well	Packers
Size			
16			Kind of Packer
13			
10	248	248	Size of
8 1/2	1145	1145	
6 5/8	2085	2085	Depth set
5 3/16	2840	2840	
3	2848	2848	Perf. top
2			Perf. bottom
Liners Used			Perf. top
			Perf. bottom

CASING CEMENTED _____ SIZE _____ No. Ft. _____ Date _____
No Cementing
COAL WAS ENCOUNTERED AT 703 FEET 120 INCHES
_____ FEET _____ INCHES _____ FEET _____ INCHES
_____ FEET _____ INCHES _____ FEET _____ INCHES

Formation	Color	Hard or Soft	Top	Bottom	Oil, Gas or Water	Depth Found	Remarks
Pittsburg Coal			703	713			
Big Dunkard			1225	1265	Water	1235	
Gas Sand			1308	1323			
Salt Sand			1440	1700	Water	1455	
Maxon Sand			1785	1805			
Little Lime			1870	1880			
Pencil Cave			1880	1895			
Big Lime			1895	1975			
Big Injun			1975	2085	Gas	2030	Show
Fifty Foot			2550	2590			
Thirty Foot			2654	2689			
Stray Sand			2753	2795	Gas	2755 & 2780	

Drilling Deeper Record

Commenced at 2795'

Slate & Shells	2795	2826
Gordon	2826	2864
Slate & Shells	2864	3022
Bayard	3022	3038
Total Depth		3042'

1895
1076
819

