


Latitude 39° 15'

0.855
1.99W

Longitude 80° 40'

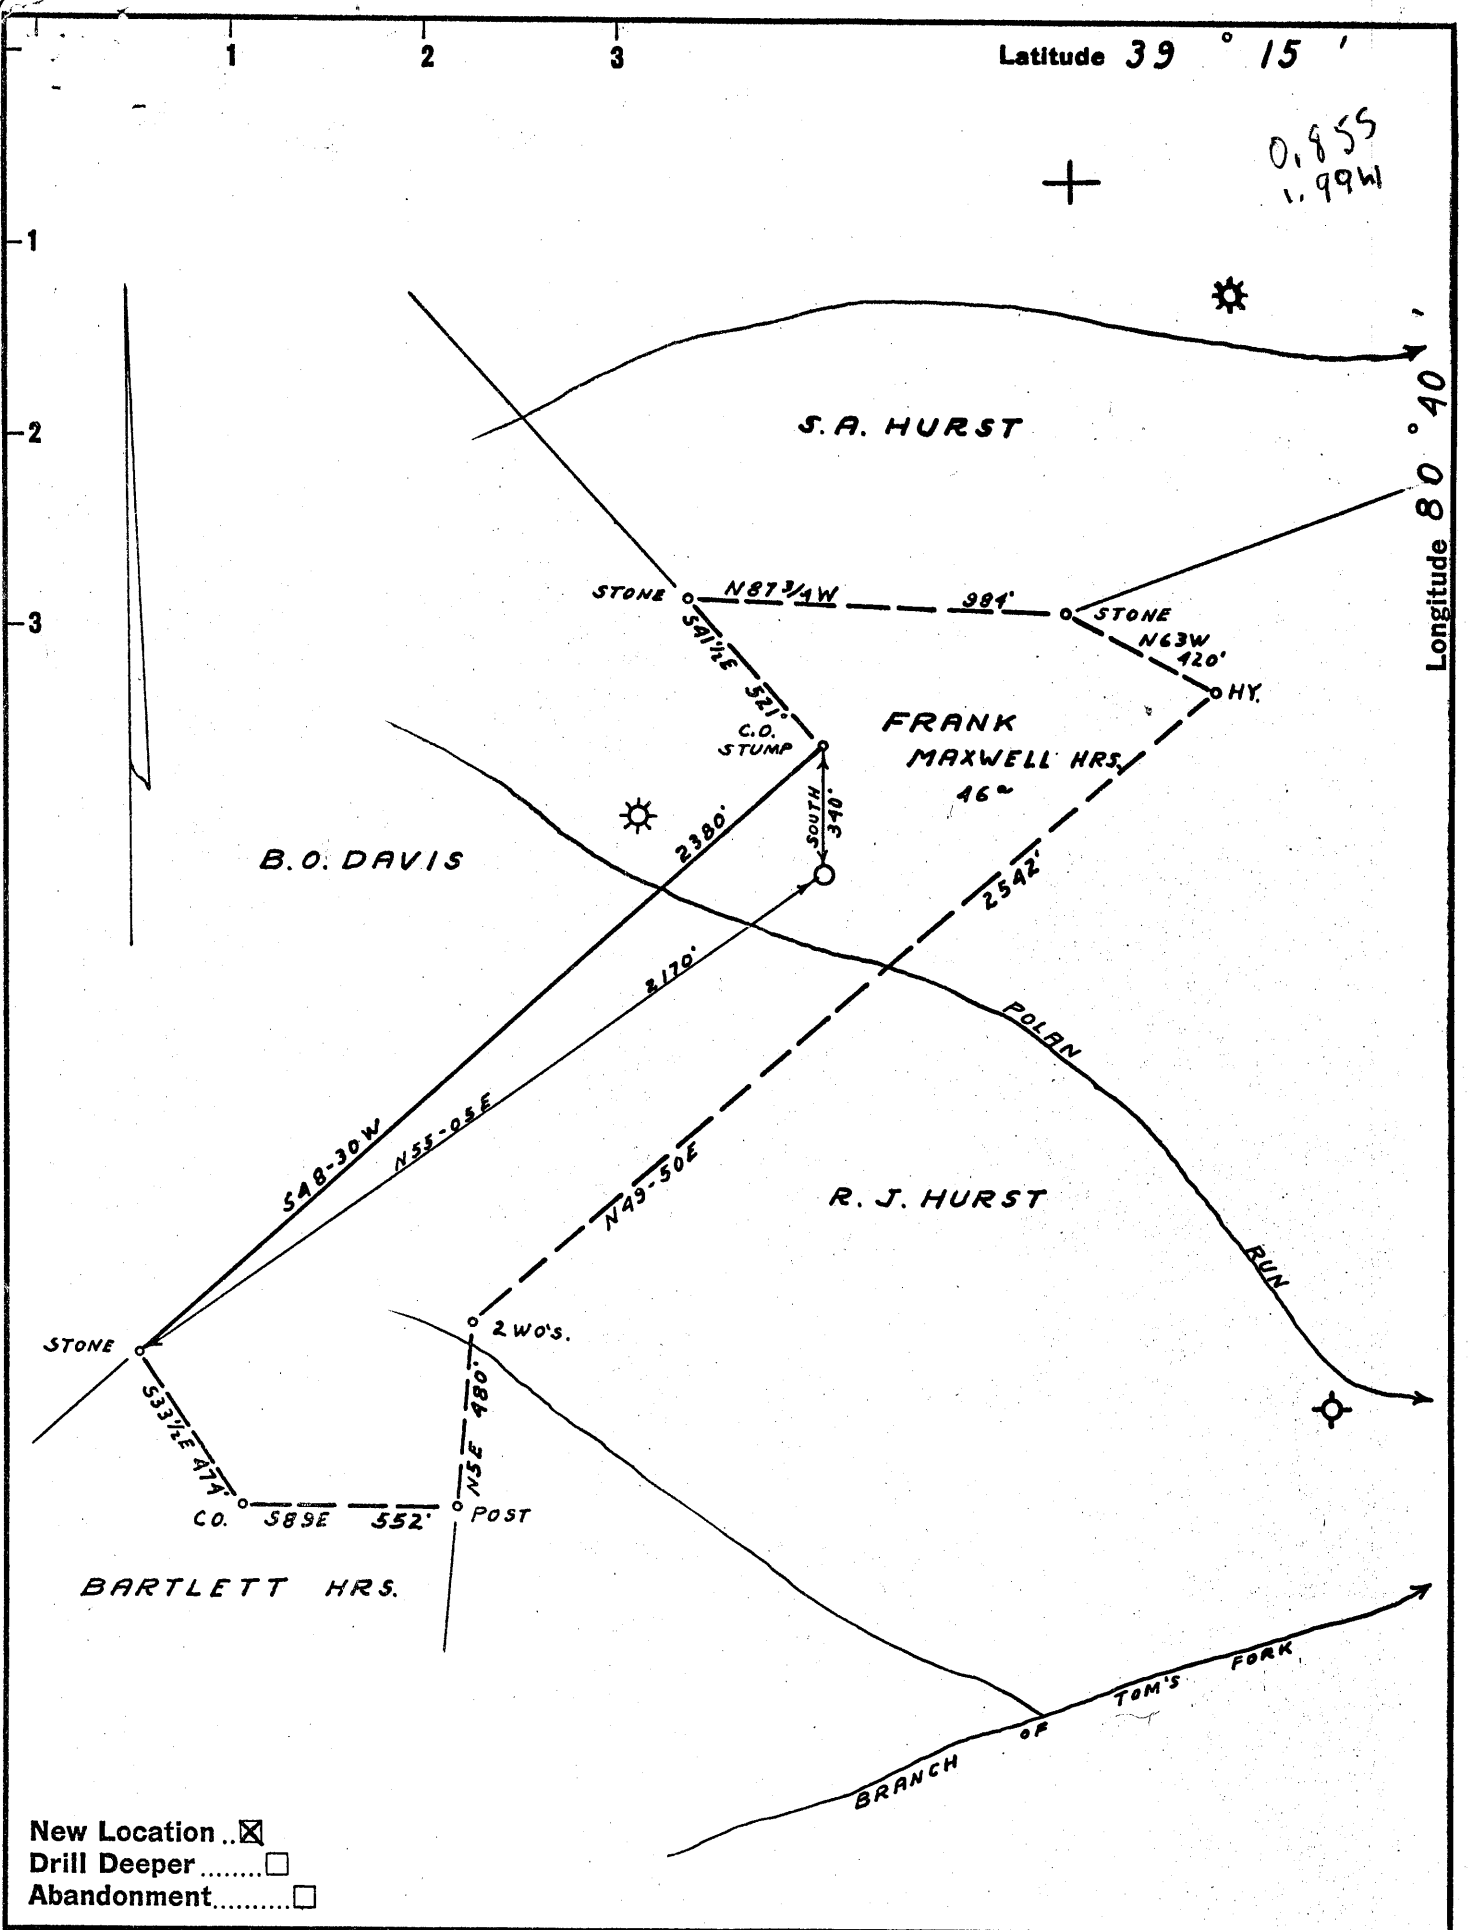

Company DODDRIDGE GAS
 Address CLARKSBURG W.VA.
 Farm FRANK MAXWELL HRS.
 Tract 5 Acres 46 Lease No. _____
 Well (Farm) No. 1 Serial No. _____
 Elevation (Spirit Level) 1024' VA
 Quadrangle VADIS NW 12
 County DODDRIDGE District NEW MILTON
 Engineer James D. Jeffries
 Engineer's Registration No. 1084
 File No. 191-18 Drawing No. _____
 Date 5-6-57 Scale 1" = 500'

STATE OF WEST VIRGINIA
 DEPARTMENT OF MINES
 OIL AND GAS DIVISION
 CHARLESTON

WELL LOCATION MAP
 FILE NO. DOD-227

+ Denotes location of well on United States Topographic Maps, scale 1 to 62,500, latitude and longitude lines being represented by border lines as shown.

- Denotes one inch spaces on border line of original tracing.

RDM^c



STATE OF WEST VIRGINIA
DEPARTMENT OF MINES
OIL AND GAS DIVISION 1

Quadrangle Radis

Permit No. DOD-227

WELL RECORD

Oil or Gas Well Gas
(KIND)

Company DODDRIDGE GAS Company
Address P. O. Drawer 351, Clarksburg, W. Va.
Farm Frank Maxwell Heirs Acres 45
Location (waters) Tom's Fork
Well No. One Elev. 1024
District New Milton County Doddridge
The surface of tract is owned in fee by Harriet M. Jarvis, et al Address Clarksburg, W. Va.
Mineral rights are owned by Harriet M. Jarvis, et al Address Clarksburg, W. Va.

Casing and Tubing	Used in Drilling	Left in Well	Packers
Size			Kind of Packer
16			<u>Upside Down</u>
13			Size of
10	<u>205</u>	<u>205</u>	<u>2" x 6 7/8"</u>
8 1/4	<u>994</u>	<u>994</u>	Depth set
16 5/8	<u>1914</u>	<u>1914</u>	<u>1960'</u>
5 3/16			Perf. top
3			Perf. bottom
2	<u>1992</u>	<u>1992</u>	Perf. top
Liners Used			Perf. bottom

Drilling commenced 5/29/57
Drilling completed 7/12/57
Date Shot _____ From _____ To _____
With Sanfracted
Open Flow _____ /10ths Water in _____ Inch
28 /10ths Merc. in 1 1/4" 240' Inch
Volume 330,000 Cu. Ft.
Rock Pressure 670# lbs. 72 hrs.
Oil _____ bbls., 1st 24 hrs.
Fresh water _____ feet
Salt water _____ feet

CASING CEMENTED 7" SIZE 100' No. Ft. _____ Date 6/25/57
COAL WAS ENCOUNTERED AT _____ FEET _____ INCHES
_____ FEET _____ INCHES FEET _____ INCHES
_____ FEET _____ INCHES FEET _____ INCHES

Formation	Color	Hard or Soft	Top	Bottom	Oil, Gas or Water	Depth Found	Remarks
Soil			00	10			
Clay			10	40			
Slate			40	70			
Red Rock			70	102			
Slate			102	125			
Lime			125	130			
Slate			130	220			
Red Rock			220	238			
Slate			238	280			
Red Rock			280	290			
Slate			290	295			
Red Rock			295	365			
Lime			365	385			
Slate			385	425			
Red Rock			425	489			
Slate	<u>Black</u>		489	491			
Slate			491	515			
Lime			515	530			
Slate			530	635			
Red Rock			635	715			
Slate			715	735			
Red Rock			735	745			
Sand			745	770			
Red Rock			770	785			
Lime			785	830			
Slate			830	882			
Lime			882	920			
Slate			920	968			
Lime			968	985			
Slate			985	1035			
Sand			1035	1055			
Slate			1055	1065			
Sand			1065	1120			
Slate			1120	1160			

Formation	Color	Hard or Soft	T. 2	Bottom	Oil, Gas or Water	Depth Found	Remarks
Sand			1160	1195			
Slate			1195	1210			
Sand			1210	1245			
Slate			1245	1295			
Sand			1295	1370			
Slate			1370	1378			
Sand			1378	1407			
Slate			1407	1441			
Sand			1441	1510			
Slate			1510	1620			
Maxom Sand			1620	1658			
Slate & Shells			1658	1720			
Lime			1720	1745			
Sand			1745	1758			
Red Rock			1758	1775			
Lime	Pink		1775	1790			
Slate			1790	1797			
Lime			1797	1806			
Slate			1806	1808			
Little Lime			1808	1835			
Blue Monday Sand			1835	1879			
Big Lime			1879	1924			
Big Injun Sand			1924	2014			
Total Depth			2014				

Pay 1978 to 2002
Gas tested in 1 1/4" 28/10 Mercury