

New Location..   
 Drill Deeper.....   
 Abandonment.....

Company	PAUL HEASTER ET AL
Address	WEST UNION, W. VA.
Farm	J.E. SWISHER
Tract	Acres 116 Lease No. _____
Well (Farm) No.	1 Serial No. _____
Elevation (Spirit Level)	1145'
Quadrangle	VADIS - NC
County	DODDRIDGE District NEW MILTON
Engineer	JOHN W. HAMILTON
Engineer's Registration No.	2274
File No.	_____ Drawing No. _____
Date	OCT. 8, 1957 Scale 1" = 30 POLES

STATE OF WEST VIRGINIA  
 DEPARTMENT OF MINES  
 OIL AND GAS DIVISION  
 CHARLESTON

**WELL LOCATION MAP**  
 FILE NO. DOD-237

+ Denotes location of well on United States Topographic Maps, scale 1 to 62,500, latitude and longitude lines being represented by border lines as shown.

- Denotes one inch spaces on border line of original tracing.



STATE OF WEST VIRGINIA  
DEPARTMENT OF MINES  
OIL AND GAS DIVISION /

*Quad - Vadis*

WELL RECORD

*Dry*

Permit No. DOD-237

Oil or Gas Well Oil & Gas  
(KIND)


Company PAUL HEASTER ET AL  
Address West Union, W. Va.  
Farm J. E. Swisher Acres 130  
Location (waters) Snake Run  
Well No. 1 Elev. 1145'  
District New Milton County Doddridge  
The surface of tract is owned in fee by Cecil Douglas  
Clarksburgh, W. Va. Address  
Mineral rights are owned by J. E. Swisher  
New Milton, W. Va. Address  
Drilling commenced 9 November 1957  
Drilling completed 15 February 1958  
Date Shot Not shot From \_\_\_\_\_ To \_\_\_\_\_  
With \_\_\_\_\_  
Open Flow n/a /10ths Water in \_\_\_\_\_ Inch  
\_\_\_\_\_ /10ths Merc. in \_\_\_\_\_ Inch  
Volume None Cu. Ft.  
Rock Pressure None lbs. \_\_\_\_\_ hrs.  
Oil Smell bbls., 1st 24 hrs.  
Fresh water 60' feet \_\_\_\_\_ feet  
Salt water 1170 feet \_\_\_\_\_ feet

Casing and Tubing	Used in Drilling	Left in Well	Packers
Size			
16			Kind of Packer <u>None</u>
13			
10	<u>300'</u>	<u>None</u>	Size of _____
8 3/4	<u>1165'</u>	<u>None</u>	
6 3/4	<u>2025'</u>	<u>None</u>	Depth set _____
5 3/16			
3			Perf. top _____
2			Perf. bottom _____
Liners Used			Perf. top _____
			Perf. bottom _____

CASING CEMENTED n/a SIZE \_\_\_\_\_ No. Ft. \_\_\_\_\_ Date \_\_\_\_\_

NO COAL WAS ENCOUNTERED  
COAL WAS ENCOUNTERED AT \_\_\_\_\_ FEET \_\_\_\_\_ INCHES  
\_\_\_\_\_ FEET \_\_\_\_\_ INCHES \_\_\_\_\_ FEET \_\_\_\_\_ INCHES  
\_\_\_\_\_ FEET \_\_\_\_\_ INCHES \_\_\_\_\_ FEET \_\_\_\_\_ INCHES

Formation	Color	Hard or Soft	Top	Bottom	Oil, Gas or Water	Depth Found	Remarks
Soil			0	15			
Slate			15	40			
Sand			40	60	Water	62	Water could not be exhausted by bailing
Slate			60	75			
Red Rock			75	85			
Slate			85	90			
Sand			90	125			
Slate			125	150			
Red Rock			150	160			
Lime			160	165			
Red Rock			165	185			
Slate			185	205			
Red Rock			205	215			
Lime			215	225			
Red Rock			225	255			
Slate			255	260			
Sand			260	295			
Slate			295	300			
Lime			300	315			
Sand			315	320			
Slate			320	340			
Sand			340	355			
Slate			355	385			
Red Rock			385	435			
Slate			435	450			
Red Rock			450	470			
Slate			470	490			
Red Lime			490	500			
Lime			500	525			
Slate			525	535			
Lime			535	705			
Sand			705	740			
Slate			740	765			
Red Rock			765	780			
Lime			780	785			
Red Rock			785	895			
Slate			895	1000			
Red Rock			1000	1015			

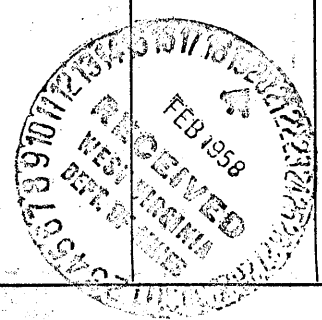

Formation	Color	Hard or Soft	Top /	Bottom	Oil, Gas or Water	Depth Found	Remarks
Slate			1015	1165			
Sand			1165	1200	Water	1170	Water could not be exhausted by bailing
Lime			1200	1465			
Sand			1465	1475			
Lime			1475	1505			
Sand			1505	1635			
Slate			1635	1730			
Lime			1730	1750			
Sand			1750	1765			
Slate			1765	1810			
Lime			1810	1840			
Slate			1840	1870			
Lime			1870	1900			
Sand			1900	1930			
Slate			1930	1935			
Lime			1935	1940			
Red Rock			1940	1945			
Slate			1945	1975			
Lime			1975	2087			
Sand			2087	2141			
Lime			2141	2151			
Slate			2151	2161			
Sand			2161	2171			
Slate			2171	2275			
Sand			2275	2360			
Slate			2360	2395			
Lime			2395	2415			
Slate			2415	2708			
Sand			2708	2714			
Slate			2714				
			TOTAL DEPTH DRILLED	2757			

Date Feb. 19, 1958

APPROVED W. H. Messer Owner

By Partner (Title)