

Company	DODDRIDGE GAS N ^o 4	
Address	CLARKSBURG W.VA.	
Farm	G.P. BARTLETT HRS.	
Tract	Acres 80	Lease No.
Well (Farm) No.	ONE	Serial No. 1
Elevation (Spirit Level)	1144' V.A.	
Quadrangle	VADIS NW1 ⁴ NW	
County	DODDRIDGE	District NEW MILTON
Engineer	JAMES D. JEFFRIES	
Engineer's Registration No.	1084	
File No.	192-38	Drawing No.
Date	4-29-58	Scale 1" = 500'

STATE OF WEST VIRGINIA
DEPARTMENT OF MINES
OIL AND GAS DIVISION
CHARLESTON

WELL LOCATION MAP
FILE NO. DOD-250

+ Denotes location of well on United States Topographic Maps; scale 1 to 62,500, latitude and longitude lines being represented by border lines as shown.

- Denotes one inch spaces on border line of original tracing.

RDM^c



STATE OF WEST VIRGINIA
DEPARTMENT OF MINES
OIL AND GAS DIVISION 2

Quadrangle Vadis
Permit No. DOD-250

WELL RECORD

Oil or Gas Well Dry
(KIND)

Company Doddridge Gas No. 4
Address P. O. Drawer 351, Clarksburg, W. Va.
Farm G. P. Bartlett Acres 80
Location (waters) Toms Run
Well No. One Elev. 1144' VA
District New Milton County Doddridge
The surface of tract is owned in fee by Fern Bartlett et al. (1770 Kent St., Columbus 5, Ohio.)
Mineral rights are owned by Same
Address _____
Drilling commenced June 23, 1958
Drilling completed Sept. 20, 1958
Date Shot _____ From _____ To _____
With _____
Open Flow _____ /10ths Water in _____ Inch
_____ /10ths Merc. in _____ Inch
Volume _____ Cu. Ft.
Rock Pressure _____ lbs. _____ hrs.
Oil _____ bbls., 1st 24 hrs.
WELL ACIDIZED _____
WELL FRACTURED _____

Casing and Tubing	Used in Drilling	Left in Well	Packers
Size			
16			Kind of Packer _____
13			
10			Size of _____
8 1/4	383'		
6 5/8	1187' 7"		Depth set _____
5 3/16			
3			Perf. top _____
2			Perf. bottom _____
Liners Used			Perf. top _____
			Perf. bottom _____


CASING CEMENTED _____ SIZE _____ No. Ft. _____ Date _____
COAL WAS ENCOUNTERED AT _____ FEET _____ INCHES
_____ FEET _____ INCHES FEET _____ INCHES
_____ FEET _____ INCHES FEET _____ INCHES

RESULT AFTER TREATMENT

ROCK PRESSURE AFTER TREATMENT

Fresh Water _____ Feet Salt Water _____ Feet

Formation	Color	Hard or Soft	Top	Bottom	Oil, Gas or Water	Depth	Remarks
Red Rock			0	52			
Lime			52	110			
Red Rock			110	120			Fresh Water 102'
Lime			120	174			
Sand			174	195			
Red Rock			195	245			
Sand			245	313			Fresh Water 550'
Red Rock			313	325			
Lime			325	332			
Sand			332	362			Show of Black Oil 1194'
Red Rock			362	383			
Lime			383	423			
Red Rock			423	465			
Lime	Pink		465	495			
Red Rock			495	532			
Sand			532	545			
Lime			545	590			
Red Rock			590	604			
Lime			604	642			
Coal (B)			642	644			
Lime			644	678			
Slate & Shells			678	781			
Red Rock			781	890			
Lime			890	905			
Slate & Shells			905	925			
Lime			925	991			
Rock	Pink		991	1025			
Lime			1025	1040			

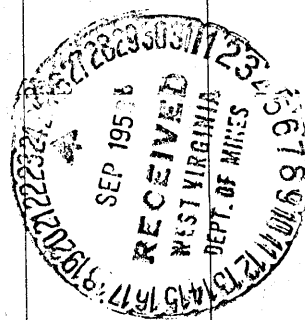

Formation	Color	Hard or Soft	Top	Bottom	Oil, Gas or Water	Depth Found	Remarks
Sand			1040	1092			
Slate			1092	1150			
Lime	Dark		1150	1178			
Sand			1178	1247			
Lime		Shells	1247	1285			
Sand			1285	1358			
Slate & Shells			1358	1400			
Lime			1400	1415			
Slate			1415	1425			
Sand		Shells	1425	1470			
Sand			1470	1558			
Slate & Shells			1558	1594			
Sand			1594	1660			
Lime			1660	1685			
Sand			1685	1710			
Slate & Shells			1710	1740			
Sand			1740	1797			
Slate & Shells			1797	1865			
Lime			1865	1880			
Sand			1880	1909			
Lime			1909	1920			
Red Rock			1920	1925			
Lime	Pink		1925	1965			
Slate			1965	1973			
L. Lime			1973	2004			
Slate			2004	2007			
Sand			2007	2012			
Slate			2012	2016			
Blue Monday			2016	2033			
Big Lime			2033	2085			
Big Injun			2085	2165			
Lime	Dark		2165				
Total Depth			2202				

Date September 23, 19 58

APPROVED DODDRIDGE GAS NO. 4, Owner

By My. Kubon (Title)