

New Location..
 Drill Deeper.....
 Abandonment.....

Company R. J. HUNTER
 Address 108 NEELY AVE. WEST UNION, W. VA.
 Farm N.H. LEGGETT
 Tract 234 AC. Acres 81 PL. Lease No. _____
 Well (Farm) No. 3 Serial No. _____
 Elevation (Spirit Level) 1017'
 Quadrangle HOLBROOK NC
 County DODDRIDGE District SOUTHWEST
 Engineer JOHN W. HAMILTON
 Engineer's Registration No. 2274
 File No. _____ Drawing No. _____
 Date APRIL 7, 1959 Scale 1"=40 POLES

STATE OF WEST VIRGINIA
 DEPARTMENT OF MINES
 OIL AND GAS DIVISION
 CHARLESTON

WELL LOCATION MAP
 FILE NO. DOD-276

+ Denotes location of well on United States Topographic Maps, scale 1 to 62,500, latitude and longitude lines being represented by border lines as shown.

- Denotes one inch spaces on border line of original tracing.

6-6-122

F50



STATE OF WEST VIRGINIA
DEPARTMENT OF MINES
OIL AND GAS DIVISION 3

Quadrangle Hellbrook
Permit No. DOD-276

WELL RECORD

Oil or Gas Well Gas
(KIND)

Company R.J. Hunter
Address West Union, W. Va.
Farm N.H. Leggett (Hedrick) 235
Location (waters) Branch of Hughes Arter
Well No. 3 Elev. 1017'
District Southwest County Doddridge
The surface of tract is owned in fee by Hedrick Leggett
Address West Union, W. Va.
Mineral rights are owned by N.H. Leggett & etal;
Address _____
Drilling commenced 4-14-59
Drilling completed 5-26-59
Date Shot _____ From _____ To _____
With _____
Open Flow /10ths Water in 35,000 Cu. Ft. Inch _____
_____ /10ths Merc. in _____ Inch _____
Volume 35,000 Cu. Ft.
Rock Pressure Not Taken lbs. 10 hrs.
Oil _____ bbls., 1st 24 hrs.
WELL ACIDIZED _____

Casing and Tubing	Used in Drilling	Left in Well	Packers
Size			Kind of Packer
16	16'	0	
13			
10			Size of
8 1/4	475'	0	
6 3/4	1119'	1119'	Depth set
5 3/16	1987'	1987'	
3			Perf. top
2			Perf. bottom
Liners Used			Perf. top
			Perf. bottom

CASING CEMENTED _____ SIZE 5 3/16 No. Ft. 20' Date _____
COAL WAS ENCOUNTERED AT _____ FEET _____ INCHES
_____ FEET _____ INCHES _____ FEET _____ INCHES
_____ FEET _____ INCHES _____ FEET _____ INCHES


WELL FRACTURED Fractured with 300 bbls. water

RESULT AFTER TREATMENT 300,000 cu. ft.

ROCK PRESSURE AFTER TREATMENT 300 lbs. - 14 hours

Fresh Water None Feet _____ Salt Water None Feet _____

Formation	Color	Hard or Soft	Top	Bottom	Oil, Gas or Water	Depth	Remarks
Clay			0	10			
Slate, Sand & Red Rock			10	677			
Slate & R. Rock		Hard	677	902			
Line			902	930			
Slate & shells			930	990			
Slate & R. Rock	S. Black		990	1150			
Sand			1150	1170			
Slate & Line				1170	1300		
Shells				1300	1375		
Sand	White			1375	1390		
Slate	Black			1390	1420		
Sand				1420	1430		
Slate			1430	1470			
Sand			1470	1480			
Slate			1480	1540			
Sand	Black		1540	1555			
Slate			1555	1600			
Sand	"		1600	1609			
Slate			1609	1690			
Sand	"		1690	1760			
Slate			1760	1805			
Sand			1805	1830			
Slate	Gritty		1830	1870			
Line	Black		1870	1900			
Slate			1900	1914			
Sand	"		1914	1923			
Slate			1923	1940			
Little Line							

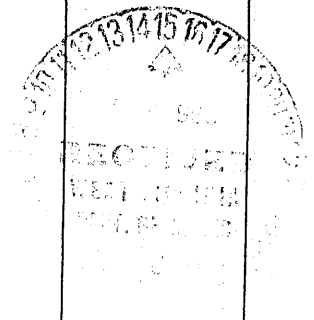

(over)

2
F 59

Formation	Color	Hard or Soft	Top 3	Bottom	Oil, Gas or Water	Depth Found	Remarks
Sand			1940	1948			
Slate			1948	1954			
Big Lime			1954	2026			
Sand			2026	2067	Gas	2038-2040 2054-2068	
Lime			2067	2081			
Sand			2081	2094			
Slate			2094	2096			

Date 2-11, 1960

APPROVED [Signature], Owner

By [Signature] (Title)