

- Redrill.....
- New Location.
- Drill Deeper.....
- Abandonment.....

Company STONE STREET LANDS CO.

Address BOX 350 SPENCER, W.VA.

Farm KENNITH B. PIERCE

Tract \_\_\_\_\_ Acres LOT N° 46 Lease No. \_\_\_\_\_

Well (Farm) No. 1 Serial No. \_\_\_\_\_

Elevation (Spirit Level) 781'

Quadrangle WEST UNION SE 4<sup>2</sup> SE

County DODDRIDGE District WEST UNION

Engineer J. D. JEFFRIES

Engineer's Registration No. 1084'

File No. 198/116 Drawing No. \_\_\_\_\_

Date 3-26-60 Scale 1" = 30'

STATE OF WEST VIRGINIA  
DEPARTMENT OF MINES  
OIL AND GAS DIVISION  
CHARLESTON

**WELL LOCATION MAP**

FILE NO. D-12-328

+ Denotes location of well on United States Topographic Maps, scale 1 to 62,500, latitude and longitude lines being represented by border lines as shown.

— Denotes one inch spaces on border line of original tracing.

RDM:5

too crowded to plot

66 99



STATE OF WEST VIRGINIA  
DEPARTMENT OF MINES  
OIL AND GAS DIVISION 5

Quadrangle West Union

Permit No. DOD-328

WELL RECORD

Oil or Gas Well Both

Company <u>Stonestreet Lands Company</u>	Casing and Tubing	Used in Drilling	Left in Well	Packers
Address <u>Box 350, Spencer, W.Va.</u>	Size			
Farm <u>Kenneth B. Pierce</u> Acres <u>Lot</u>	16			Kind of Packer
Location (waters) <u>Middle Island</u>	13			Size of
Well No. <u>1</u> Elev. <u>781.00</u>	8 1/4	<u>30</u>	<u>30</u>	Depth set
District <u>West Union</u> County <u>Doddridge</u>	6 5/8	<u>324</u>		Perf. top
The surface of tract is owned in fee by <u>Kenneth B. Pierce</u>	5 3/16	<u>903</u>	<u>1693</u>	Perf. bottom
Address <u>Southington, Ohio</u>	3			Perf. top
Mineral rights are owned by <u>same</u>	2	<u>1736</u>	<u>1736</u>	Perf. bottom
Address _____	Liners Used			
Drilling commenced <u>4/7/60</u>				
Drilling completed <u>4/30/60</u>				
Date Shot <u>no</u> From _____ To _____				
With _____				
Open Flow <u>50</u> /10ths Water in <u>2</u> Inch				
_____ /10ths Merc. in _____ Inch				
Volume <u>298M</u> Cu. Ft.				
Rock Pressure <u>250</u> lbs. <u>10</u> hrs.				
Oil <u>40</u> bbls., 1st 24 hrs.				
WELL ACIDIZED <u>no</u>				
WELL FRACTURED <u>no</u>				


CASING CEMENTED 5 SIZE 175 No. Ft. 4/25/60 Date  
11 sacks Portland Cement - Halliburton  
COAL WAS ENCOUNTERED AT Not in Coal Area FEET INCHES  
FEET INCHES FEET INCHES  
FEET INCHES FEET INCHES

RESULT AFTER TREATMENT \_\_\_\_\_

ROCK PRESSURE AFTER TREATMENT \_\_\_\_\_

Fresh Water hole full Feet 28 & 150 Salt Water none Feet \_\_\_\_\_

Formation	Color	Hard or Soft	Top	Bottom	Oil, Gas or Water	Depth	Remarks
Soil			0	20			
Pink Rock			20	70			
Slate			70	130			
Lime			130	140			
Slate			140	150			
Sand			150	170			
Red Rock			170	205			
Slate			205	250			
Sand			250	260			
Slate			260	295			
Red Rock			295	322			
Slate			322	328			
Lime			328	371			
Slate			371	458			
Lime			458	468			
Red Rock			468	478			
Slate			478	495			
Red Rock			495	535			
Lime			535	555			
Red Rock			590 555	590			
Slate			590	660			
Red Rock			660	740			
Sand			740	760			
Shale			760	783			
Lime			783	825			
Slate			825	850			
Sand			850	900			
Lime			900	955			
S and			955	980			

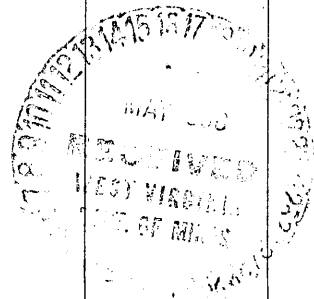

Formation	Color	Hard or Soft	Top <sup>5</sup>	Bottom	Oil, Gas or Water	Depth Found	Remarks
Slate			980	990			
Lime			996	1007			
Sand			1007	1055			
Slate & Shells			1055	1098			
Sand			1098	1125			
Black Slate			1125	1135			
Slate			1135	1150			
Lime			1150	1170			
/Sand			1170	1248			
Slate			1248	1252			
Sand			1252	1300			
Slate & Shells			1300	1340			
Sand			1340	1375			
Slate			1375	1380			
Sand			1380	1465			
Slate			1465	1475			
Lime			1475	1510			
Slate & shells			1510	1527			
Sand			1527	1565			
Lime			1565	1610			
Slate & shells			1610	1640			
Lime			1640	1722			
Big Injun Sand			1722		Gas - 1724	Oil - 1727	
				Total Depth	- 1736		