

New Location ..   
 Drill Deeper .....   
 Abandonment .....

*No coal in this vicinity  
 Surface: - Zelma Connelly and Pauline Myer, 312  
 Front Street, West Union, W. Va.*

*To crowded to Plot.*

Company CONNELLY & MYER  
 Address 312 Front St, West Union, West Va.  
 Farm Connolly and Myer  
 Tract \_\_\_\_\_ Acres 1/3 Lease No. \_\_\_\_\_  
 Well (Farm) No. One Serial No. \_\_\_\_\_  
 Elevation (Spirit Level) 810  
 Quadrangle West Union ~~SE~~ SE  
 County Doddridge District West Union  
 Engineer [Signature]  
 Engineer's Registration No. 1227  
 File No. \_\_\_\_\_ Drawing No. \_\_\_\_\_  
 Date April, 1960 Scale 1" = 60'

STATE OF WEST VIRGINIA  
 DEPARTMENT OF MINES  
 OIL AND GAS DIVISION  
 CHARLESTON

**WELL LOCATION MAP**  
 FILE NO. DOD-348

+ Denotes location of well on United States Topographic Maps, scale 1 to 62,500, latitude and longitude lines being represented by border lines as shown.

- Denotes one inch spaces on border line of original tracing.



STATE OF WEST VIRGINIA  
DEPARTMENT OF MINES  
OIL AND GAS DIVISION

Quadrangle West Union

Permit No. DOD-348

WELL RECORD

Oil or Gas Well Both  
(KIND)

Company Anderson Drilling Company  
Address Marietta, Ohio  
Farm Lots # 13 - 14 Acres 1/3  
Location (waters) Middle Island Creek  
Well No. # 1 Elev. 810  
District West Union County Doddridge  
The surface of tract is owned in fee by Tina O. Lowther  
Address West Union, W.Va.  
Mineral rights are owned by Tina O. Lowther  
Address West Union, W.Va.  
Drilling commenced April 25, 1960  
Drilling completed July 14, 1960  
Date Shot From To  
With  
Open Flow 40/10ths Water in 2 Inch  
/10ths Merc. in \_\_\_\_\_ Inch  
Volume \_\_\_\_\_ Cu. Ft.  
Rock Pressure 125 lbs. 24 hrs.  
Oil 3 bbls., 1st 24 hrs.  
WELL ACIDIZED \_\_\_\_\_  
WELL FRACTURED NO

Casing and Tubing	Used in Drilling	Left in Well	Packers
Size			Kind of Packer
16			
13			
10	23' 9"	23' 9"	Size of
8 1/4	267 ft.		
6 5/8	850 ft.		Depth set
5 3/16	1750 ft.	1750 ft.	
3			Perf. top
2		1920 ft.	Perf. bottom
Liners Used			Perf. top
			Perf. bottom


CASING CEMENTED 5 1/2 SIZE 1740 No. Ft. 5/24/60 Date  
15 sacks cement - 5 sacks Howcogel - Halliburton  
Service  
COAL WAS ENCOUNTERED AT \_\_\_\_\_ FEET \_\_\_\_\_ INCHES  
\_\_\_\_\_ FEET \_\_\_\_\_ INCHES FEET \_\_\_\_\_ INCHES  
\_\_\_\_\_ FEET \_\_\_\_\_ INCHES FEET \_\_\_\_\_ INCHES

RESULT AFTER TREATMENT

ROCK PRESSURE AFTER TREATMENT

Fresh Water \_\_\_\_\_ Feet Salt Water \_\_\_\_\_ Feet

Formation	Color	Hard or Soft	Top	Bottom	Oil, Gas or Water	Depth	Remarks
Soil			0	6			
White Clay			6	14			
Yellow Clay			14	34			
Lime			34	48			
Red Slate and Shale			48	60			
			60	127			
Red Rock			127	140			
Slate			140	160			
Red Lime			160	190			
			190	205			
Sand			205	225	Water	216 ft.	(hole full)
Red Rock			225	287			
Slate and Shells			287	345			
Red Rock			345	350			
Lime and Shells			350	485			
Pink Rock			485	508			
Slate and Shells			508	531			
Red Rock			531	600			

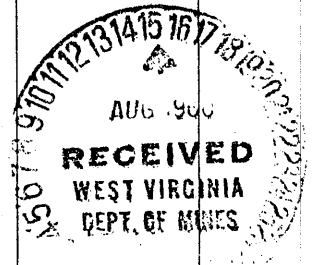

Formation	Color	Hard or Soft	Top 5'	Bottom	Oil, Gas or Water	Depth Found	Remarks
Slate and Shells			600	616			
Red Rock			616	655			
Hard Lime			655	664			
Blue Shale			664	690			
Slate and Shells			690	734			
Red Rock			734	776			
Lime and Slate			776	825			
Red Rock			825	835			
Slate and Shells			835	930			
Sand			930	966			
Slate and Lime			966	1012			
Sand			1012	1045			
Slate and Shells			1045	1070			
Gas Sand			1070	1120			
Slate and Shells			1120	1156			
Sand			1156	1185			
Black Slate			1185	1195			
Lime and Slate			1195	1227			
Salt Sand			1227	1295			
Lime and Slate			1295	1319			
Sand			1319	1355			
Black Slate			1355	1400			
Grit Lime			1400	1408			
Sand			1408	1511			
Slate			1511	1530			
Lime			1530	1555			
Maxon Sand			1555	1629	Oil	1606 ft.	
Slate and Shells			1629	1650			
Red			1650	1653			
Lime (Dark)			- 1653	1671			
Soft Slate			1671	1689			
Dark Lime			1689	1709			
Big Lime			- 1709	1785			
Keener Sand			1785	1843			15 sacks of cement and 3 sacks of aquagel behind pipe - 1750 ft.
Broken Sand			1843	1858 1/2			
Injun Sand			1858 1/2	1899			
Injun Sand			1899	1920			Casing leaked gas - put 120 sacks of cement behind pipe.
Broken Sand			1920				

Halliburton Oil Well  
Cementing Company

AFFIDAVIT OF PLUGGING AND FILLING WELL

AFFIDAVIT SHOULD BE MADE IN TRIPLICATE, one copy mailed to the Division, one copy to be retained by the Well Operator and the third copy (and extra copies if required) should be mailed to each coal operator at their respective addresses.

<u>NONE</u> Coal Operator or Owner	<u>Anderson Drilling Company</u> Name of Well Operator
Address	<u>Marietta, Ohio</u> Complete Address
Coal Operator or Owner	<u>October 2,</u> 19 <u>86</u> WELL AND LOCATION
Address	<u>West Union</u> District
<u>R. L. Conrad</u> Lease or Property Owner	<u>Doddridge</u> County
<u>West Union, WV</u> Address	WELL NO. <u>1</u>
	<u>R. L. Conrad</u> Farm

STATE INSPECTOR SUPERVISING PLUGGING Mike Underwood


AFFIDAVIT

STATE OF WEST VIRGINIA,  
County of Gilmer

ss:

Rodney K. Pettit and Timothy M. Meadows

being first duly sworn according to law depose and say that they are experienced in the work of plugging and filling oil and gas wells and were employed by Bet-Ro, Inc., well operator, and participated in the work of plugging and filling the above well, that said work was commenced on the 30th. day of September, 19 86, and that the well was plugged and filled in the following manner:

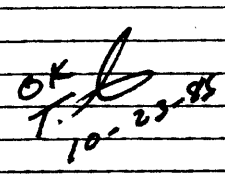Sand or Zone Record Formation	Filling Material	Plugs Used Size & Kind	Casing	
			CSG PULLED	CSG LEFT IN
1916 to 1800	Fluid			23'10"
1800 to 1600	Cement			1750' 5 1/2"
1600 to 1025	6% Gel			
1025 to 925	Cement			
925 to 325	6% Gel			
325 to 0	Cement			
				
Coal Seams	Description of Monument			
(Name)	Marker installed with Permit			
(Name)	#47-017-0348 welded on it.			
(Name)				
(Name)				

and that the work of plugging and filling said well was completed on the 1st. day of October, 19 86.

And further deponents saith not.

Rodney Pettit  
Timothy Meadows

Sworn to and subscribed before me this 2nd. day of October, 19 86.

Dandra Dube  
Notary Public

My commission expires:

My Commission Expires April 4, 1989

Permit No. 47-017-0348-P

OCT 27 1986