

New Location    
 Drill Deeper    
 Abandonment

No coal in this vicinity  
 Surface: - Floyd Sibert, Box 205  
 West Union, W. Va.

Company McCutcheon & Perkins  
 Address of Paul McCutcheon, West Union, W. Va.  
 Farm Maxwell Heirs  
 Tract \_\_\_\_\_ Acres 420 Lease No. \_\_\_\_\_  
 Well (Farm) No. One Serial No. \_\_\_\_\_  
 Elevation (Spirit Level) \_\_\_\_\_ 894  
 Quadrangle West Union SE  
 County Doddridge District West Union  
 Engineer W. H. Hart  
 Engineer's Registration No. 1227  
 File No. \_\_\_\_\_ Drawing No. \_\_\_\_\_  
 Date April, 1960 Scale 1" = 400' = 660'

STATE OF WEST VIRGINIA  
 DEPARTMENT OF MINES  
 OIL AND GAS DIVISION  
 CHARLESTON

WELL LOCATION MAP

FILE NO. DOD - 355

+ Denotes location of well on United States Topographic Maps, scale 1 to 62,500, latitude and longitude lines being represented by border lines as shown.

- Denotes one inch spaces on border line of original tracing.



STATE OF WEST VIRGINIA  
DEPARTMENT OF MINES  
OIL AND GAS DIVISION 6

Quadrangle West Union

Permit No. D.O. 355

WELL RECORD

Oil or Gas Well Dry  
(KIND)

Company Perkins & McCutchen  
Address West Union, W. Va  
Farm Maxwell Heirs Acres 420  
Location (waters) Middle School Creek  
Well No. #1 Elev. 594  
District West Union County Doddridge  
The surface of tract is owned in fee by Floyd Seibert  
West Union Address W. Va  
Mineral rights are owned by Maxwell Heirs  
Address \_\_\_\_\_

Drilling commenced 6/4/60  
Drilling completed 6/7/60

Date Shot \_\_\_\_\_ From \_\_\_\_\_ To \_\_\_\_\_  
With \_\_\_\_\_

Open Flow \_\_\_\_\_ /10ths Water in \_\_\_\_\_ Inch  
\_\_\_\_\_ /10ths Merc. in \_\_\_\_\_ Inch

Volume \_\_\_\_\_ Cu. Ft.

Rock Pressure \_\_\_\_\_ lbs. \_\_\_\_\_ hrs.

Oil \_\_\_\_\_ bbls., 1st 24 hrs.

WELL ACIDIZED \_\_\_\_\_

WELL FRACTURED 6/11/60 Water Frac. by Halliburton

RESULT AFTER TREATMENT ✓

ROCK PRESSURE AFTER TREATMENT ✓

Fresh Water \_\_\_\_\_ Feet \_\_\_\_\_ Salt Water \_\_\_\_\_ Feet \_\_\_\_\_

Casing and Tubing	Used in Drilling	Left in Well	Packers
Size			Kind of Packer
16			
13			
10	337'		Size of
8 3/4	1210'		
6 3/4			Depth set
5 3/16	1968'		
3			Perf. top
2			Perf. bottom
Liners Used			Perf. top
			Perf. bottom


CASING CEMENTED \_\_\_\_\_ SIZE \_\_\_\_\_ No. Ft. \_\_\_\_\_ Date \_\_\_\_\_

COAL WAS ENCOUNTERED AT \_\_\_\_\_ FEET \_\_\_\_\_ INCHES

\_\_\_\_\_ FEET \_\_\_\_\_ INCHES FEET \_\_\_\_\_ INCHES

\_\_\_\_\_ FEET \_\_\_\_\_ INCHES FEET \_\_\_\_\_ INCHES

Formation	Color	Hard or Soft	Top	Bottom	Oil, Gas or Water	Depth	Remarks
TOP Soil			0	5			
Red Rock			5	15			
Yellow Sand			15	40			
Slate			40	50			
Red Rock			50	100			
Slate			100	108			
Red Rock			108	155			
Slate			155	180			
SAND			180	190			
Slate			190	230			
SAND			230	260			
Red Rock			260	270			
SAND			270	285			
Red Rock			285	308			
SAND			300	305			
Red Rock			305	330			
Slate			330	350			
Red Rock			350	380			
LIME			380	390			

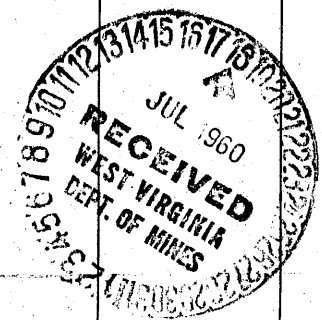

RAW 10" 337

Formation	Color	Hard or Soft	Top 6	Bottom	Oil, Gas or Water	Depth Found	Remarks
Red Rock			346	400			
Slate			400	410			
lime		Hard	410	425			
Slate			425	430			
sand			430	435			
Slate			435	450			
Red Rock			450	456			
lime		HARD	456	480			
Red Rock			480	483			
lime		GRITTY	483	490			
Slate			490	495			
lime	PINK		495	520			
Red Rock			520	555			
Slate			555	570			
SAND			570	602			
Slate			602	640			
Red Rock			640	645			
lime		HARD	645	655			
Slate Shells			655	695			
SAND			695	698			
lime Pitt		HARD	698	715			
Slate			715	749			
SAND			749	758			
Slate Shell			758	815			
PINK Rock			815	832			
lime		HARD	832	842			
Slate			842	935			
lime		HARD	935	941			
Red Rock			941	958			
lime		GRITTY HARD	958	990			
SAND			990	1010			
Slate			1010	1017			
PINK Rock			1017	1040			
Slate			1040	1055			
Red Rock			1055	1068			
lime		BROKEN	1068	1075			
Slate Shells			1075	1106			
SAND			1106	1116			
Slate Shell			1116	1136			
SAND		SOFT	1136	1190			
Slate	Black		1190	1210			Red 8" 1210
SAND			1210	1226			
lime		GRITTY	1226	1255			
Slate			1255	1290			
SAND			1290	1310			
Slate Shells			1310	1336			
SAND		SOFT	1336	1400			
Slate		Black	1400	1410			
SAND			1410	1460			
SAND			1460	1505			
Slate	Black	SOFT	1505	1570			
SAND			1570	1590			
Slate	Black		1590	1660			
SAND	Black		1660	1700			
Slate	Black		1700	1720	show of Br		
SAND			1720	1791			1968 Red 5 1/2"
Slate	Black		1791	1870			
Red Rock			1870	1912			
Panel cove			1912	1925	Date		19
lime			1925	1940			
SAND		HARD	1940	2086	APPROVED		Owner
lime	Black		2086	2094	By		(Title)
SAND		HARD	2094	2143			
Slate			2143	2154			TOTAL depth of Red Sand IF ANY
							Plotted back to 2123