

New Location
 Drill Deeper
 Abandonment

No coal in this section.
 Surface is owned by Floyd Sibert,
 Box 208, West Union, W. Va.
 5-14-75

JACK E. and BERTHA
 Company ~~WEST UNION CO. CO. CO.~~
 C/O MR. JACK WEBBER
 Address ~~Box 208, West Union, West Va.~~
 Farm Claude Smith, et al.
 Tract Acres 108 Lease No. _____
 Well (Farm) No. Two Serial No. _____
 Elevation (Spirit Level) 908
 Quadrangle West Union SE
 County Doddridge District West Union
 Engineer [Signature]
 Engineer's Registration No. 1227
 File No. _____ Drawing No. _____
 Date April, 1960 Scale 1" = 20 poles

STATE OF WEST VIRGINIA
 DEPARTMENT OF MINES
 OIL AND GAS DIVISION
 CHARLESTON


WELL LOCATION MAP

FILE NO. DOD-362-P
 CORRECTED OPERATOR'S NAME ALREADY PLOTTED

+ Denotes location of well on United States Topographic Maps, scale 1 to 62,500, latitude and longitude lines being represented by border lines as shown.

- Denotes one inch spaces on border line of original tracing.

47-017 MAY 29 1975

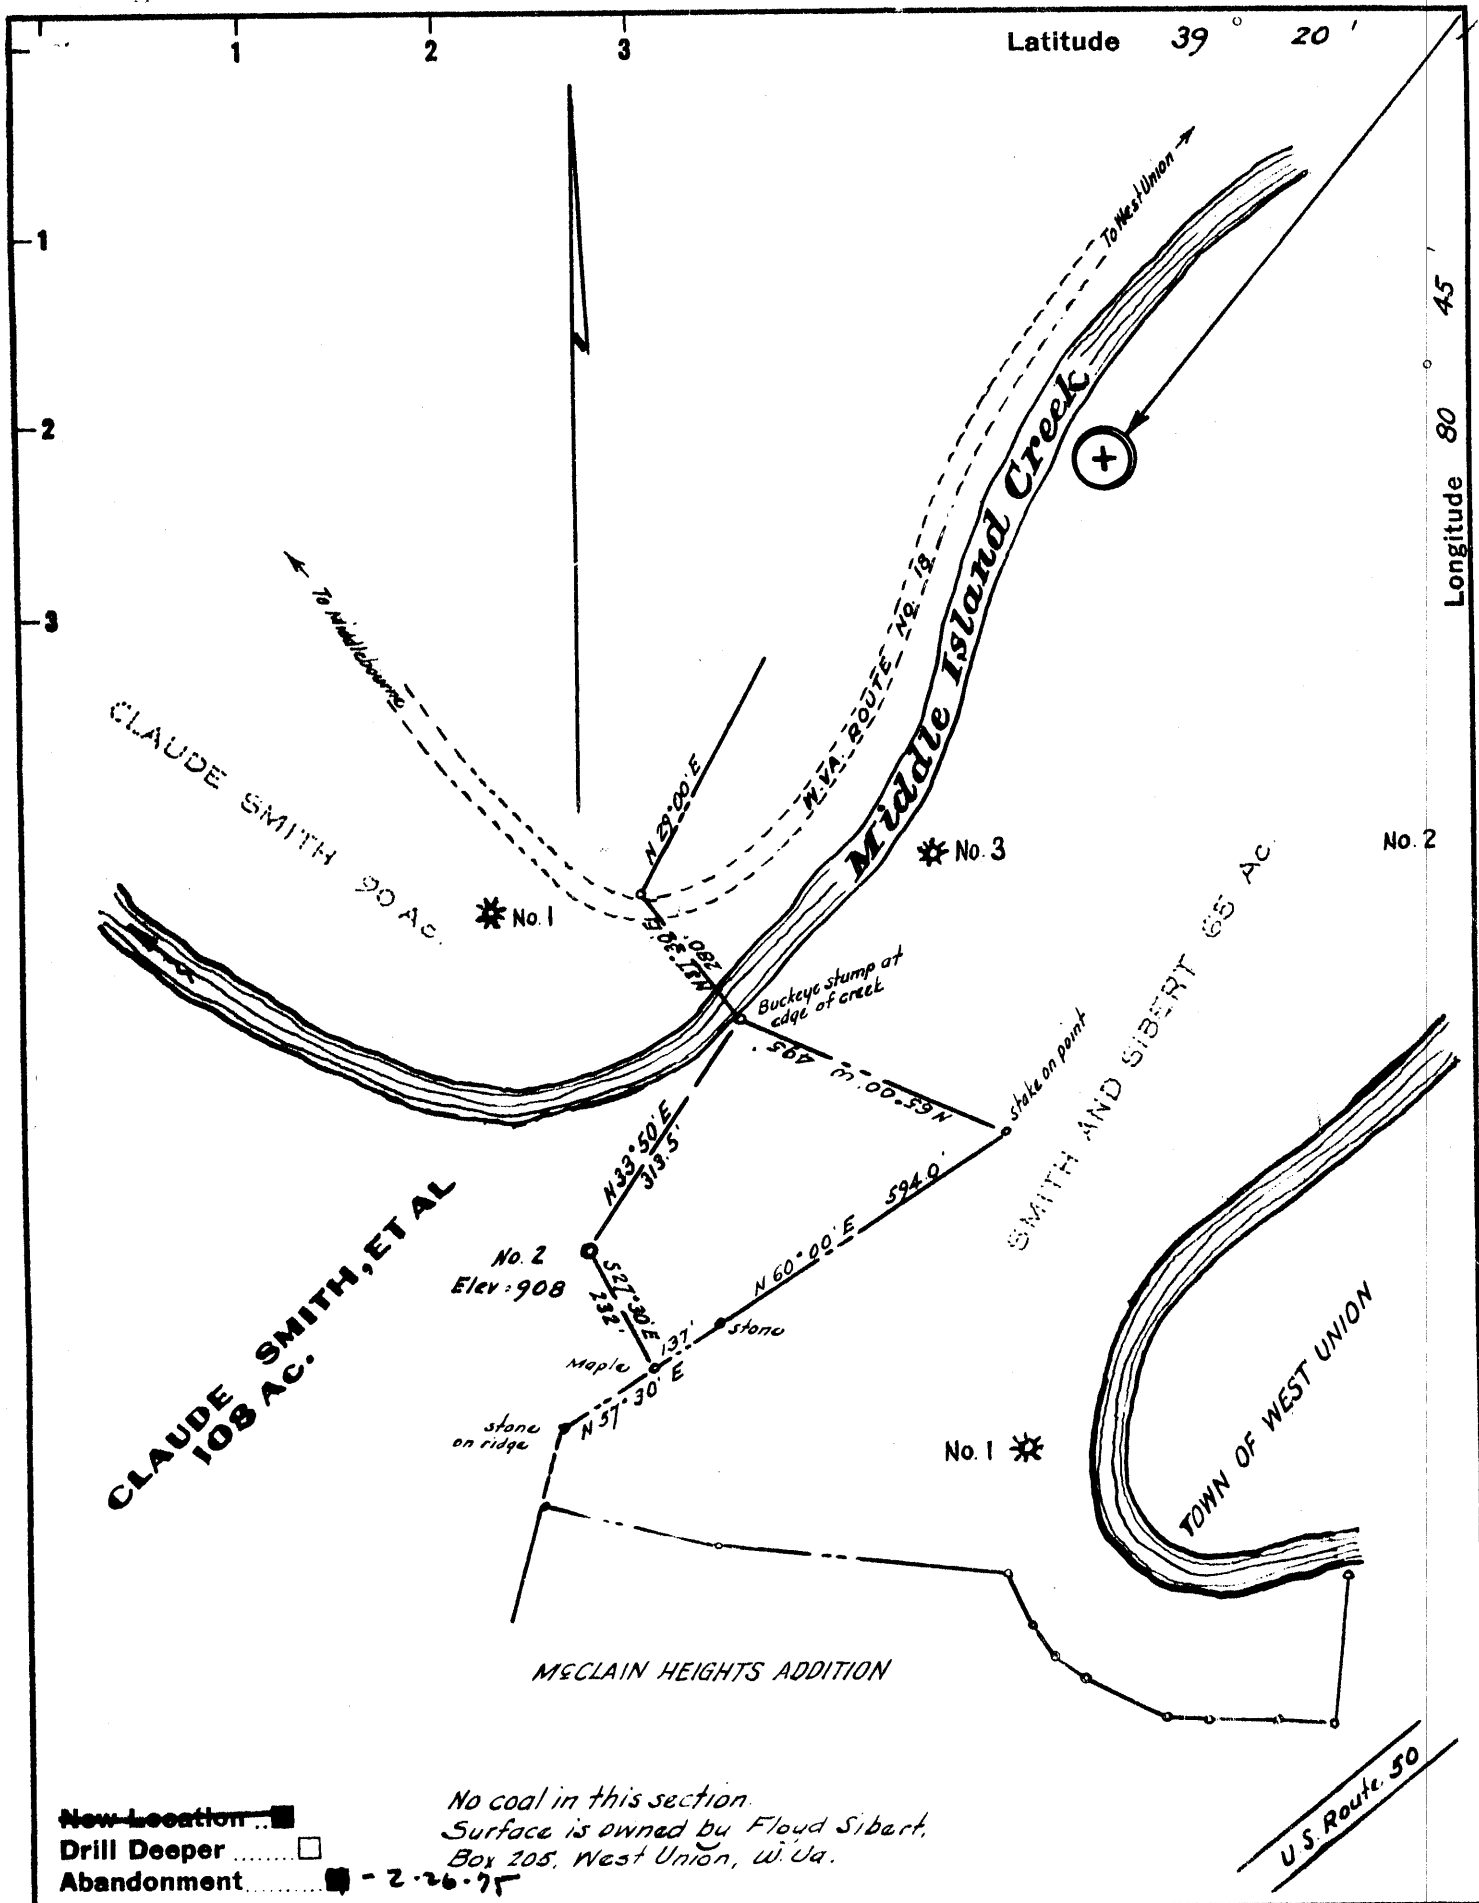

New Location
 Drill Deeper
 Abandonment - 2-26-75

No coal in this section.
 Surface is owned by Floyd Sibert,
 Box 205, West Union, W. Va.

UNITED DRILLING AND EXPLORATION COMPANY
 Company ~~SMITH AND SIBERT~~
 C/O MR. JACK WEBBER
 Address ~~Box 205, West Union, West Va.~~
 Farm Claude Smith, et al.
 Tract _____ Acres 108 Lease No. _____
 Well (Farm) No. Two Serial No. _____
 Elevation (Spirit Level) 908
 Quadrangle West Union SE
 County Doddridge District West Union
 Engineer *W. H. ...*
 Engineer's Registration No. 1227
 File No. _____ Drawing No. _____
 Date April, 1960 Scale 1" = 20 poles

STATE OF WEST VIRGINIA
 DEPARTMENT OF MINES
 OIL AND GAS DIVISION
 CHARLESTON


WELL LOCATION MAP
 FILE NO. DOR-362-P

+ Denotes location of well on United States Topographic Maps, scale 1 to 62,500, latitude and longitude lines being represented by border lines as shown.

- Denotes one inch spaces on border line of original tracing.

47-017

M. Too crowded to plot

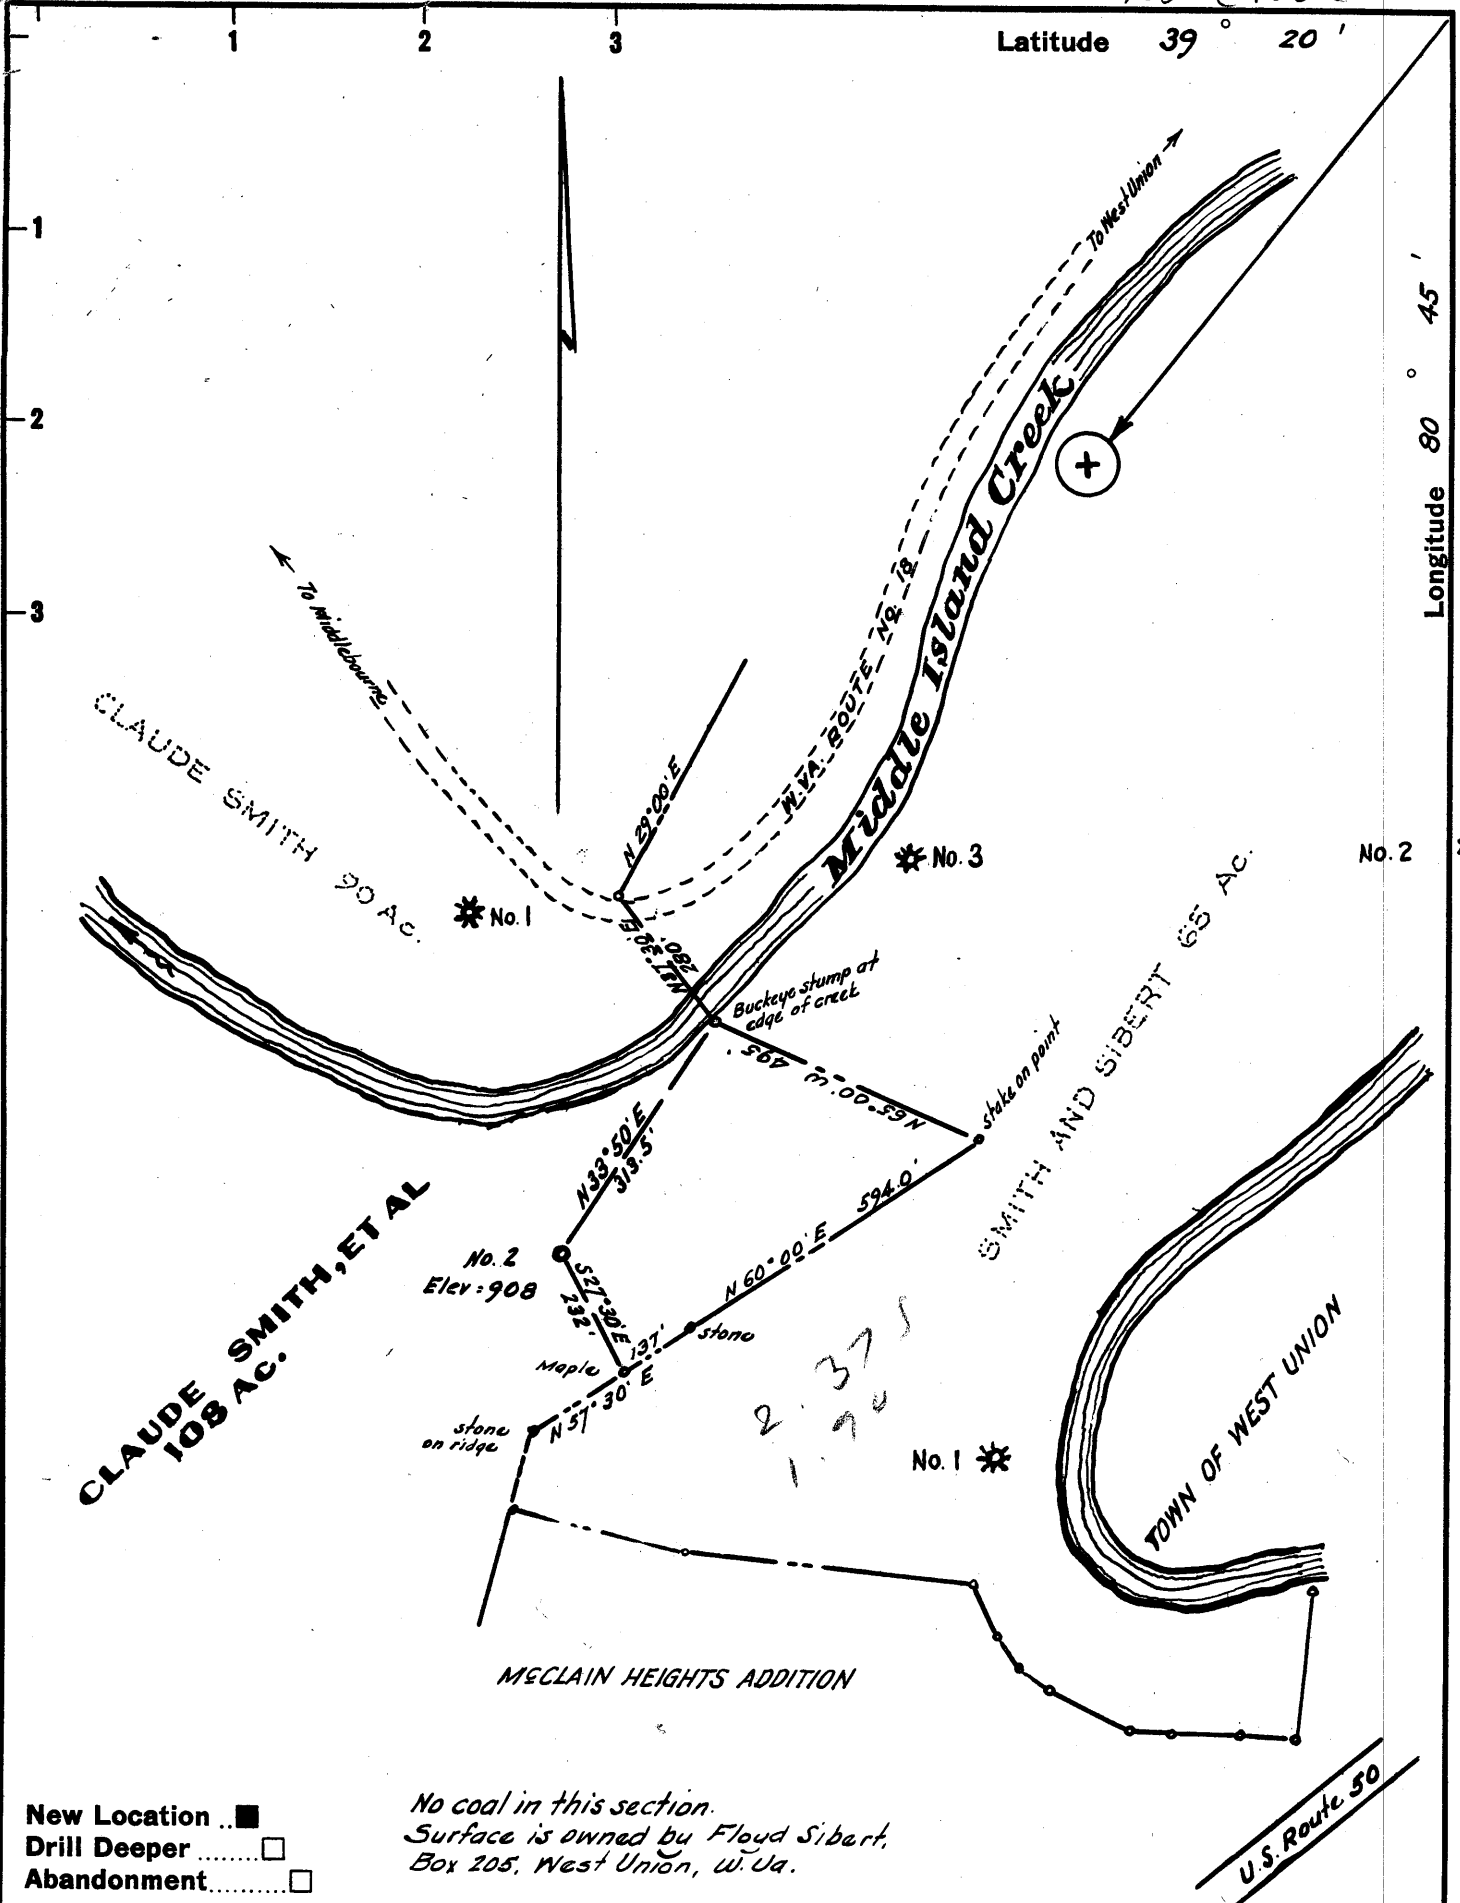

Company SMITH AND SIBERT

Address Box 205, West Union, West Va.

Farm Claude Smith, et al.

Tract _____ Acres 108 Lease No. _____

Well (Farm) No. Two Serial No. _____

Elevation (Spirit Level) 908

Quadrangle West Union SE

County Doddridge District West Union

Engineer W. H. [Signature]

Engineer's Registration No. 1227

File No. _____ Drawing No. _____

Date April, 1960 Scale 1" = 20 poles

STATE OF WEST VIRGINIA
DEPARTMENT OF MINES
OIL AND GAS DIVISION
CHARLESTON

WELL LOCATION MAP

FILE NO. DOD-362

+ Denotes location of well on United States Topographic Maps, scale 1 to 62,500, latitude and longitude lines being represented by border lines as shown.

- Denotes one inch spaces on border line of original tracing.



STATE OF WEST VIRGINIA
DEPARTMENT OF MINES
OIL AND GAS DIVISION 10

Quadrangle West Union

Permit No. DOD-262

WELL RECORD

Oil or Gas Well Gas
(KIND)

Company Sibert & Smith c/o J.M. L. Smith
Address P.O. Box 205 West Union, W. Va
Farm Claud F. Smith Acres 108
Location (waters) Middle Island Creek
Well No. 2 Elev. 908'
District West Union County Doddridge
The surface of tract is owned in fee by Floyd W. Sibert
Address _____
Mineral rights are owned by Claud F. Smith
Address West Union, W. Va.

Drilling commenced April 20-1960
Drilling completed May 20-1960
Date Shot _____ From _____ To _____
With _____

Open Flow 100ths Water in 6.5/8 Inch casing
100ths Merc. in _____ Inch
Volume one million 513 Cu. Ft.
Rock Pressure 350 lbs. twelve hrs.
Oil _____ bbls., 1st 24 hrs.

WELL ACIDIZED _____

WELL FRACTURED _____

Casing and Tubing	Used in Drilling	Left in Well	Packers
Size			Kind of Packer
16	I6	I6	
13	13		
10	10 250		Size of
8 1/4	8 1/4 700		
6 3/4	6 3/4 I258	I258	Depth set
5 3/16			
3			Perf. top
2			Perf. bottom
Liners Used			Perf. top
			Perf. bottom


CASING CEMENTED _____ SIZE _____ No. Ft. _____ Date _____
6 5/8 - mule - gelled - to be drilled
COAL WAS ENCOUNTERED AT later to say bottom FEET _____ INCHES
_____ FEET _____ INCHES FEET _____ INCHES
_____ FEET _____ INCHES FEET _____ INCHES

RESULT AFTER TREATMENT

ROCK PRESSURE AFTER TREATMENT

Fresh Water 120' - 1 1/2 hrs. per hr. Feet Salt Water None Feet

Formation	Color	Hard or Soft	Top	Bottom	Oil, Gas or Water	Depth	Remarks
Red Sand			0	20			
Slate			20	40			
Red rock			40	90			
Slate			90	170			
Slate			170	240			
Slate			240	350			
Red rock			350	400			
Slate			400	425			
Slate & shells			425	460			
Red rock			460	480			
Line & shells			480	520			
Red rock			520	540			
Slate & shells			540	565			
Sand			565	605			
Slate & shells			605	690			
Lime			690	700			
Slate & shells			700	805			
Red rock			805	840			
Slate & shells			840	875			
Red lime			875	900			
Red rock			900	940			
Sand			940	980			
Slate			980	I025			
Red rock			I025	I055			
Slate & shells			I055	I210			
Sand			I210	I250			
Slate			I250	I325			
Slate & shells			I325	I460			
Slate & Shells			I460	I500			

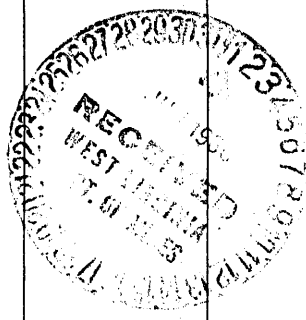

Formation	Color	Hard or Soft	Top /ft	Bottom	Oil, Gas or Water	Depth Found	Remarks
Blue sand			1500	1545			
Black slate			1545	1590			
Sand			1590	1630			
Slate			1650	1725			
Sand			1725	1775			
Slate			1775	1785			
Sand			1785	1805			
Slate			1805	1810			
Sand			1810	1825			
Sand			1825	1836	Gas		
Total Depth			1836				

Date May 23, 1960

APPROVED Robert Paul Smith, Owner

By J. M. Smith
(Title)