

- New Location
- Drill Deeper
- Abandonment

NOTE: Clarence & Ila Powell own in Fee

Company MOUND GAS CO.
 Address 410 CLARENCE POWELL WEST UNION, W. VA.
 Farm CLARENCE & ILA POWELL
 Tract _____ Acres 292.55 Lease No. _____
 Well (Farm) No. 1 Serial No. _____
 Elevation (Spirit Level) 829'
 Quadrangle CENTERPOINT SW
 County DODDRIDGE District GRANT
 Engineer JOHN W. HAMILTON
 Engineer's Registration No. 2274
 File No. _____ Drawing No. _____
 Date JUNE 5, 1960 Scale 1" = 40 POLES

STATE OF WEST VIRGINIA
 DEPARTMENT OF MINES
 OIL AND GAS DIVISION
 CHARLESTON

WELL LOCATION MAP
 FILE NO. Dop-398
plugged 11/04/1960

+ Denotes location of well on United States Topographic Maps, scale 1 to 62,500, latitude and longitude lines being represented by border lines as shown.

- Denotes one inch spaces on border line of original tracing.



STATE OF WEST VIRGINIA
DEPARTMENT OF MINES
OIL AND GAS DIVISION 4

Quadrangle Centerpoint

Permit No. DOD-398

WELL RECORD

Oil or Gas Well DRY (KIND)

Company Mound Gas Co. Clarence Powell Agent

Address West Union, W. Va.

Farm Clarence & LLa Powell

Location (waters) Water fresh, NF. 70ft Acres

Well No. 1 Elev. 829

District Grant County Dodderidge

The surface of tract is owned in fee by Clarence and LLa Powell Address West U. W. Va.

Mineral rights are owned by same Address

Drilling commenced Sept 22, 1960

Drilling completed Oct 18, 1960

Date Shot _____ From _____ To _____

With _____

Open Flow _____ /10ths Water in _____ Inch

_____ /10ths Merc. in _____ Inch

Volume _____ Cu. Ft.

Rock Pressure _____ lbs. _____ hrs.

Oil _____ bbls., 1st 24 hrs.

WELL ACIDIZED _____

WELL FRACTURED _____

Casing and Tubing	Used in Drilling	Left in Well	Packers
Size			Kind of Packer
16			
13	50ft		
10	57ft		Size of
8 1/2	544ft		
6 3/4	1070ft		Depth set
5 3/16			
3			Perf. top
2			Perf. bottom
Liners Used			Perf. top
			Perf. bottom

CASING CEMENTED _____ SIZE _____ No. Ft. _____ Date _____

COAL WAS ENCOUNTERED AT _____ FEET _____ INCHES

_____ FEET _____ INCHES _____ FEET _____ INCHES


_____ FEET _____ INCHES _____ FEET _____ INCHES

RESULT AFTER TREATMENT _____

ROCK PRESSURE AFTER TREATMENT _____

Fresh Water 70' Feet Salt Water None Feet

Formation	Color	Hard or Soft	Top	Bottom	Oil, Gas or Water	Depth	Remarks
Soil			0	3			
mud			3	22			
gravel			22	30			
mud			30	50			
Sand			50	53			
limy sand			53	90			
shale	blu		90	109			
Lime			109	117			
shale	blu		117	133			
shale	blu		133	143			
shale	bla		143	237			
lime			237	247			
shale	blu		247	276			
Lime			276	290			
shale			290	300			
Red rock			300	355			
Sand			355	375			
Red rock			375	400			
shale	blu		400	418			
Lime			418	432			
Red rock			432	454			
shale			454	547			
sand			547	562			
shale	blu		562	571			
Lime			571	602			
shale			602	678			
shale	bla		678	715			
lime			715	728			
lime	grey		728	743			
sandy lime			743	760			
shale			760	767			

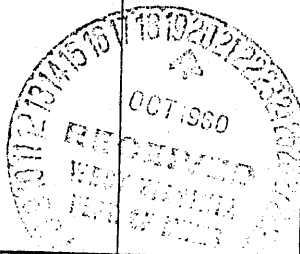

Formation	Color	Hard or Soft	Top 4	Bottom	Oil, Gas or Water	Depth Found	Remarks
lime			767	775			
shale			775	881			
sand			881	910			
slate			910	922			
sand			922	934			
slate			934	950			
shale			950	964			
slate			964	973			
sand			973	997			
sand			997	1215			
slate	bla		1215	1286			
sand			1286	1321			
slate			1321	1340			
lime			1340	1361			
slate	bla		1361	1397			
sand			1397	1460			
Red			1460	1465			
lime			1470	1476			
shale	blu		1476	1522			
Elde Money & Maxon			1522	1554			
B lime			1554	1618			Smell of Gas at 1553ft.
Injun Sand			1618	1661			
Lime			1661	1692			
Shale & Shells			1692	1828			
Total depth.....			1828				