


Latitude 39° 20'

Longitude 80° 45'

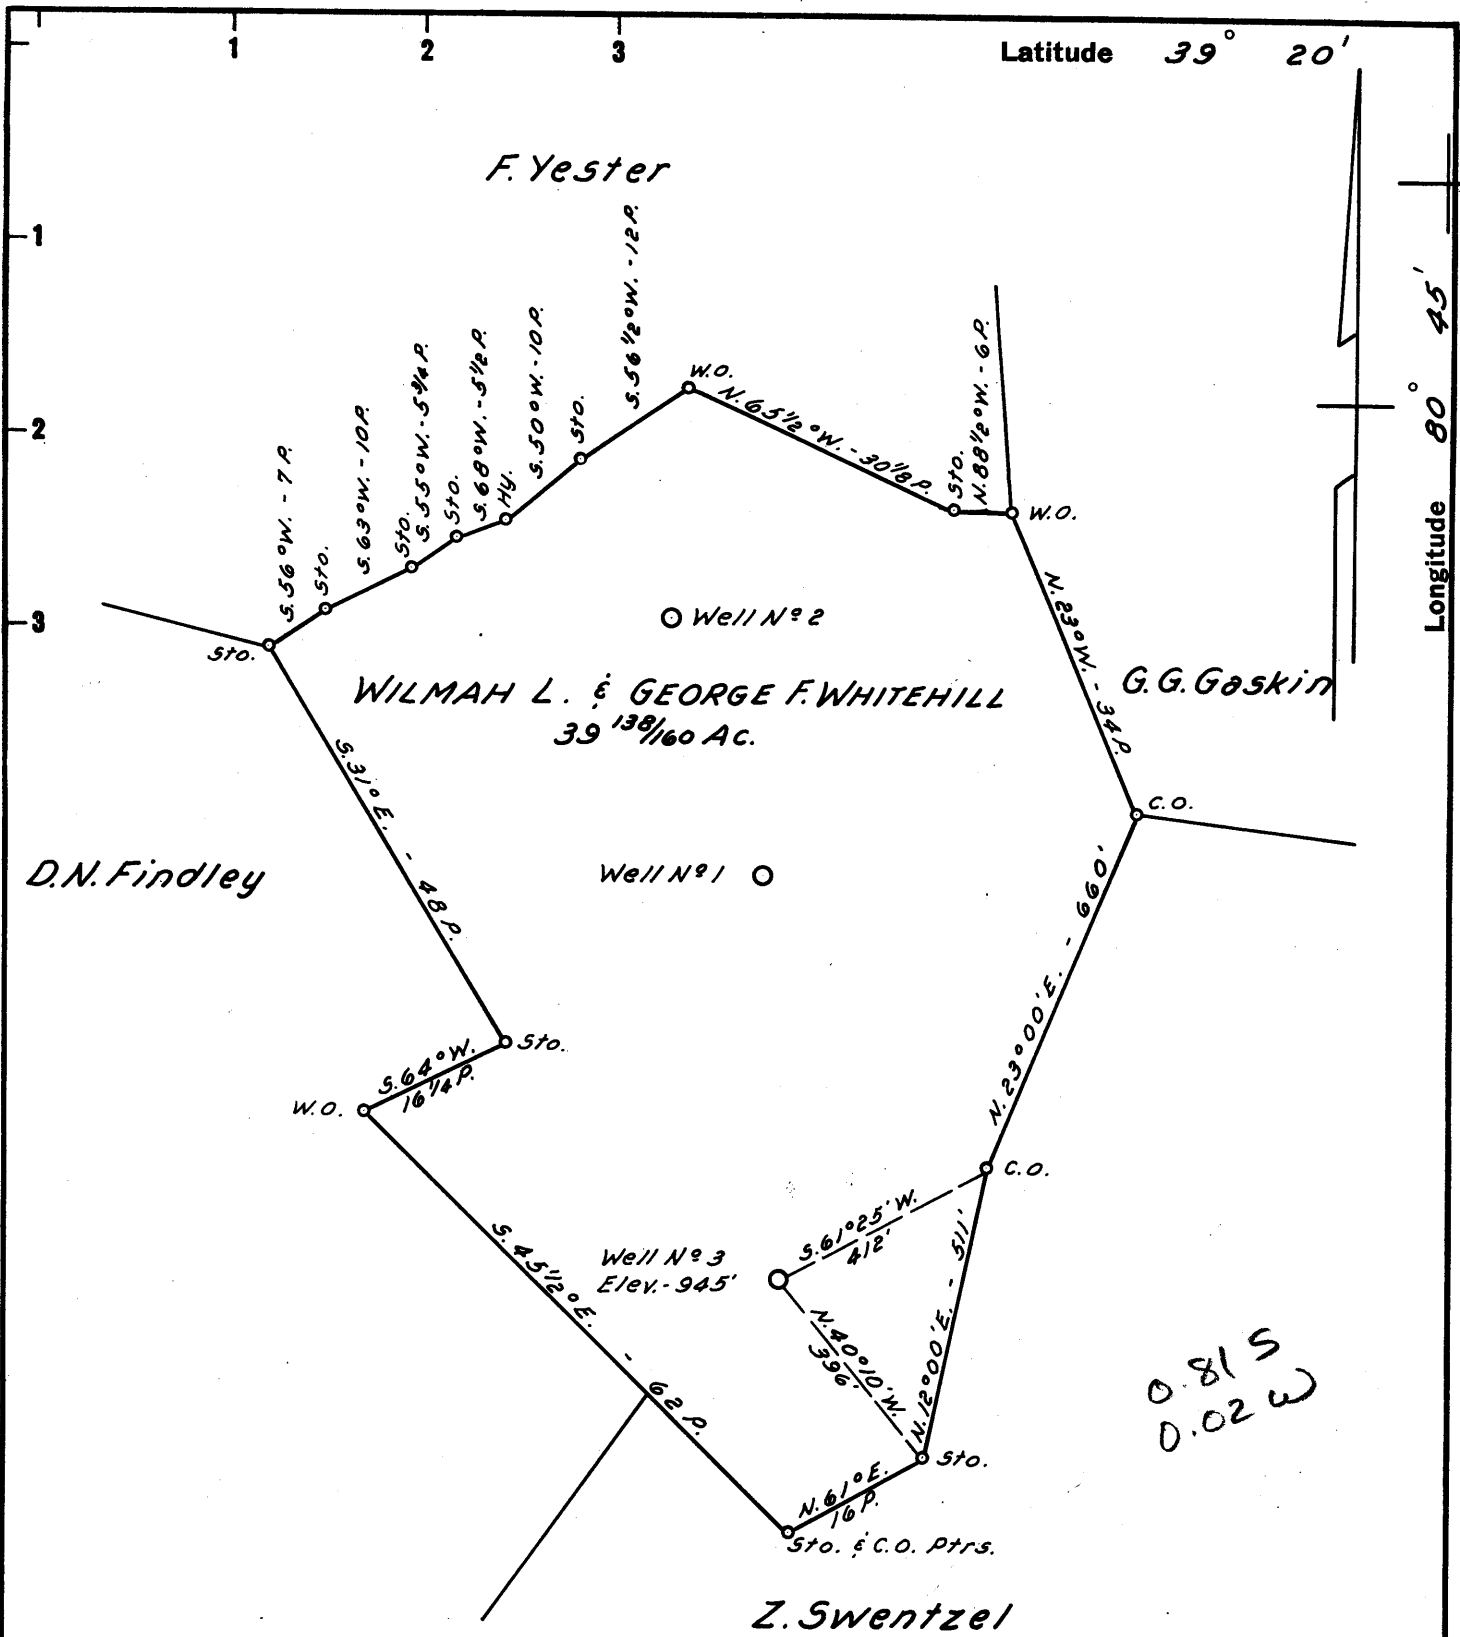

- New Location
- Drill Deeper
- Abandonment

NOTE:  
Wilma L. & Geo. F. Whitehill own in Fee.

Company DALE COTTRILL & LEON BEAVER  
 Address 103 KIBLER ST. WILLIAMSTOWN, W. VA.  
 Farm WILMAH L. & GEO. F. WHITEHILL  
 Tract \_\_\_\_\_ Acres 39<sup>138</sup>/<sub>160</sub> Lease No. \_\_\_\_\_  
 Well (Farm) No. 3 Serial No. \_\_\_\_\_  
 Elevation (Spirit Level) 945'  
 Quadrangle WEST UNION SE  
 County DODDRIDGE District WEST UNION  
 Engineer JOHN W. HAMILTON  
 Engineer's Registration No. 2274  
 File No. \_\_\_\_\_ Drawing No. \_\_\_\_\_  
 Date JULY 13, 1960 Scale 1" = 20 POLES

STATE OF WEST VIRGINIA  
 DEPARTMENT OF MINES  
 OIL AND GAS DIVISION  
 CHARLESTON

**WELL LOCATION MAP**  
 FILE NO. DOD-424

+ Denotes location of well on United States Topographic Maps, scale 1 to 62,500, latitude and longitude lines being represented by border lines as shown.

- Denotes one inch spaces on border line of original tracing.

*Too CROWDED TO Plot*