


Latitude 39° 20'

Longitude 80° 45'

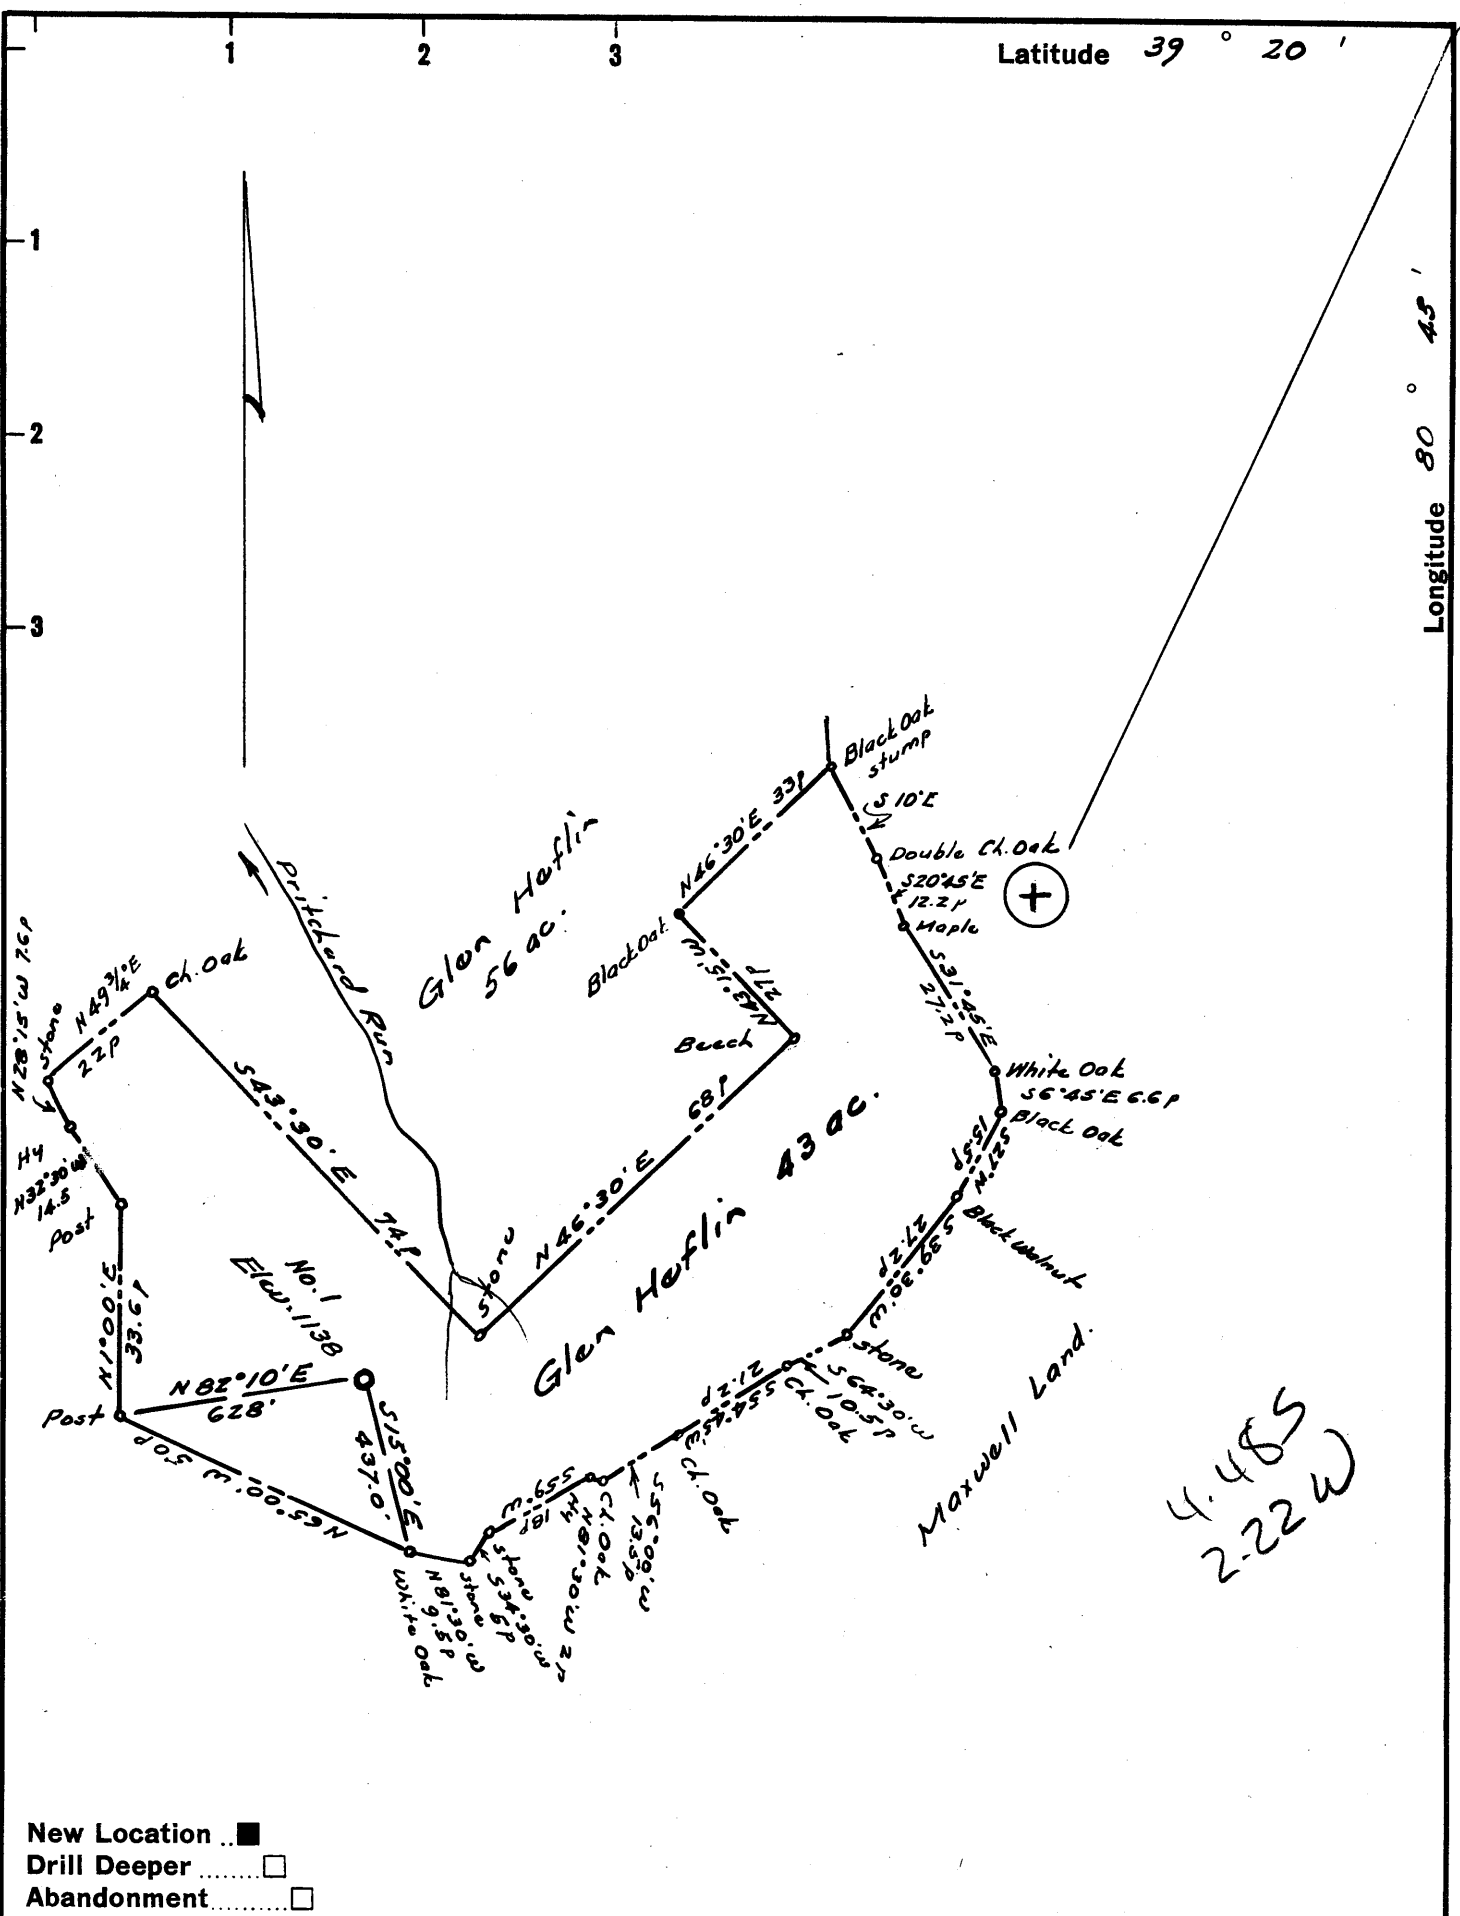

New Location
 Drill Deeper
 Abandonment

Company R. C. BACHELOR
 Address Box 116, West Union, W. Va.
 Farm Glen Haflin
 Tract _____ Acres 43.0 Lease No. _____
 Well (Farm) No. One Serial No. _____
 Elevation (Spirit Level) 1138
 Quadrangle West Union SE
 County Doddridge District West Union
 Engineer W. H. B. [Signature]
 Engineer's Registration No. 1227
 File No. _____ Drawing No. _____
 Date July 1960 Scale 1" = 30 p

STATE OF WEST VIRGINIA
 DEPARTMENT OF MINES
 OIL AND GAS DIVISION
 CHARLESTON

WELL LOCATION MAP

FILE NO. DOO - 426

+ Denotes location of well on United States Topographic Maps, scale 1 to 62,500, latitude and longitude lines being represented by border lines as shown.

- Denotes one inch spaces on border line of original tracing.