


Latitude 39° 20'

Longitude 80° 45'

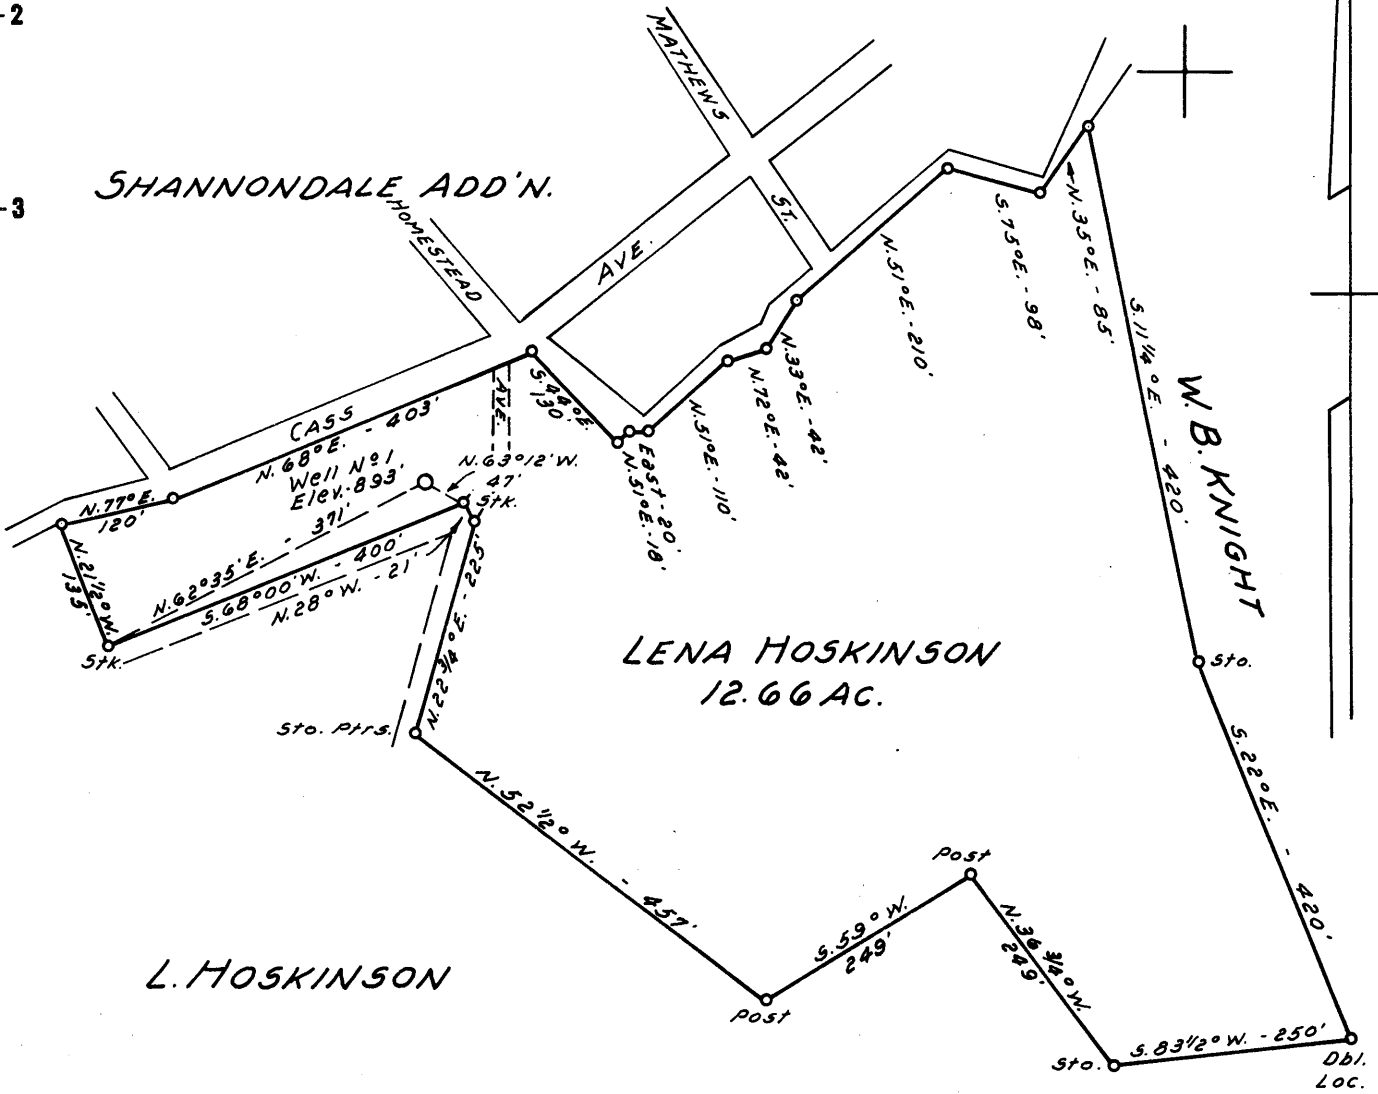

New Location

Drill Deeper

Abandonment

NOTE:

Lena Hoskinson owns the Oil & Gas Rights.

Company C. R. JAMES
 Address PENNSVILLE, OHIO
 Farm LENA HOSKINSON
 Tract _____ Acres 12.66 Lease No. _____
 Well (Farm) No. 1 Serial No. _____
 Elevation (Spirit Level) 893'
 Quadrangle WEST UNION SE
 County DODDRIDGE District WEST UNION
 Engineer JOHN W. HAMILTON
 Engineer's Registration No. 2274
 File No. _____ Drawing No. _____
 Date JULY 23, 1960 Scale 1" = 200'

STATE OF WEST VIRGINIA
 DEPARTMENT OF MINES
 OIL AND GAS DIVISION
 CHARLESTON

WELL LOCATION MAP

FILE NO. DOD-428

+ Denotes location of well on United States Topographic Maps, scale 1 to 62,500, latitude and longitude lines being represented by border lines as shown.

- Denotes one inch spaces on border line of original tracing.

Too Crowded To Plot