


Latitude 39° 15'

Longitude 80° 35'

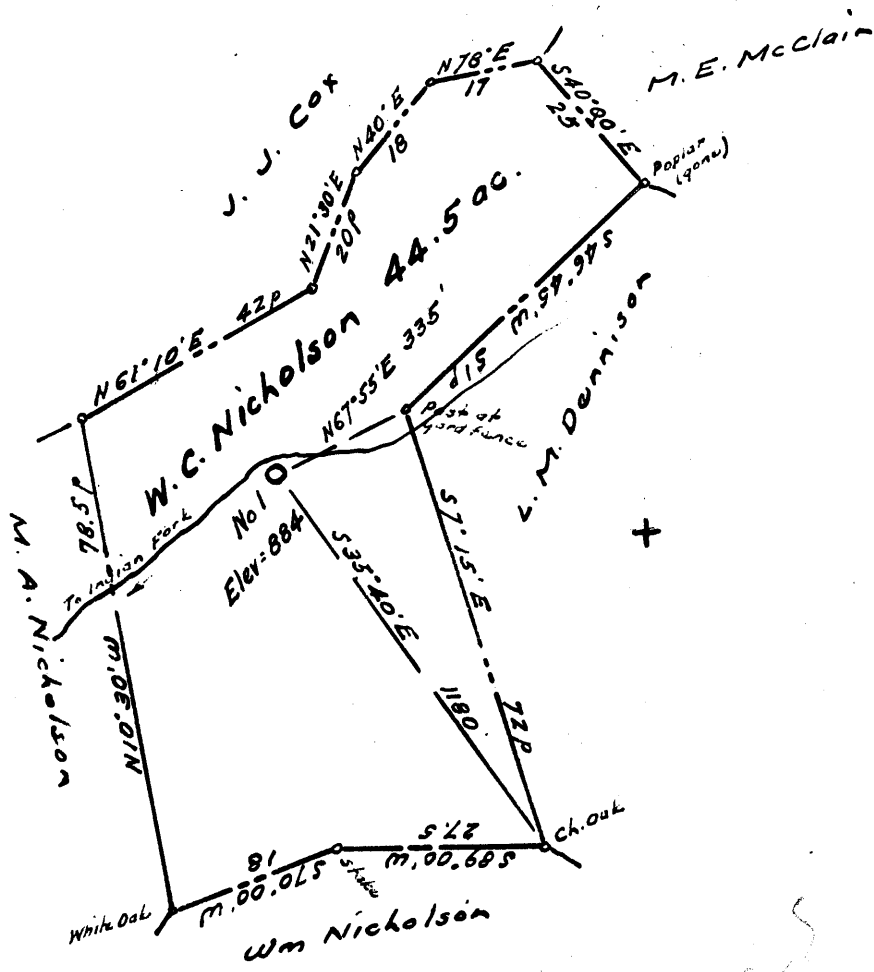

5.425
2.62

New Location
 Drill Deeper
 Abandonment

No coal
 surface: - W. C. Nicholson,
 Jarvisville, W. Va.

Company HALL & STALNAKER
 Address to James H. Hall, Rural Route, Weston, W. Va.
 Farm W. C. Nicholson
 Tract _____ Acres 44.5 Lease No. _____
 Well (Farm) No. One Serial No. _____
 Elevation (Spirit Level) 884
 Quadrangle Yadis NC
 County Doddridge District New Milton
 Engineer W. H. Heston
 Engineer's Registration No. 1227
 File No. _____ Drawing No. _____
 Date August 1960 Scale 1" = 30p.

STATE OF WEST VIRGINIA
 DEPARTMENT OF MINES
 OIL AND GAS DIVISION
 CHARLESTON

WELL LOCATION MAP
 FILE NO. 00D-460

+ Denotes location of well on United States Topographic Maps, scale 1 to 62,500, latitude and longitude lines being represented by border lines as shown.

- Denotes one inch spaces on border line of original tracing.



STATE OF WEST VIRGINIA
DEPARTMENT OF MINES
OIL AND GAS DIVISION 3

Quadrangle Vadis

Permit No. DOD 460

WELL RECORD

Oil or Gas Well DRY
(KIND)


Company HALL AND NEALWICKER
Address 702 W. Second St. Weston, W. Va.
Farm W. C. Nicholson Acres 44.5
Location (waters) INDIAN FORK
Well No. #1 Elev. 884
District New Milton County Dodderidge
The surface of tract is owned in fee by W. C. Nicholson
Big ISSAC Address W. Va.
Mineral rights are owned by W. C. Nicholson
Big ISSAC Address W. Va.
Drilling commenced Aug. 20, 1960
Drilling completed Sept. 20, 1960
Date Shot _____ From _____ To _____
With _____
Open Flow /10ths Water in _____ Inch
/10ths Merc. in _____ Inch
Volume _____ Cu. Ft.
Rock Pressure _____ lbs. _____ hrs.
Oil _____ bbls., 1st 24 hrs.
WELL ACIDIZED _____
WELL FRACTURED _____

Casing and Tubing	Used in Drilling	Left in Well	Packers
Size			
16 Conductor	16 1/2		Kind of Packer _____
13	58		
10	236		Size of _____
8 1/4	877-9		
6 1/4	1971-10		Depth set _____
5 3/16			
3			Perf. top _____
2			Perf. bottom _____
Liners Used			Perf. top _____
			Perf. bottom _____

CASING CEMENTED _____ SIZE _____ No. Ft. _____ Date _____
COAL WAS ENCOUNTERED AT None FEET _____ INCHES
_____ FEET _____ INCHES FEET _____ INCHES
_____ FEET _____ INCHES FEET _____ INCHES

RESULT AFTER TREATMENT _____
ROCK PRESSURE AFTER TREATMENT _____
Fresh Water _____ Feet Salt Water _____ Feet

Formation	Color	Hard or Soft	Top	Bottom	Oil, Gas or Water	Depth	Remarks
GRAVEL			0	2.5	WATER	20 ft	
Red Rock			2.5	135	WATER	70 ft	HOLE full.
SLATE			135	162			
Red Rock			162	228			
SLATE			228	290			
Red Rock			290	325			
SAND			325	342			
Red Rock			342	382			
SLATE & Shells			382	517			
Red Rock			517	523			
CRITTY LIME			523	548			
Black SLATE			548	567			
White SLATE			567	585			
SAND			585	625			
SLATE & shells			625	680			
Red Rock			680	685			
SAND			685	700			
SLATE & Shells			700	710			

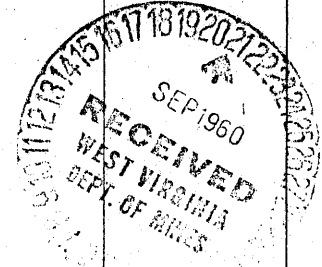

Formation	Color	Hard or Soft	Top 3	Bottom	Oil, Gas or Water	Depth Found	Remarks
<i>Red Rock & Slate</i>			710	827			
Slate and Shells			827	868			
Sand			868	884			
Slate			884	898			
Red Rock			898	930			
Lime			930	960	Little Water at 960'		
Slate & Shells			960	1020			
Sand			1020	1055			
Slate & Shells			1055	1113			
Lime			1113	1140			
Sand			1140	1165			
Slate & Shells			1165	1275			
Gritty Lime			1275	1316			
Slate & Shells			1316	1368			
Sand			1368	1403	Water 1400'	2 8" Bailers every 2 hours	
Slate & Shells			1403	1450			
Sand			1450	1490			
Slate & Shells			1490	1535			
Sand			1535	1567			
Slate & Shells			1567	1625			
Sand			1625	1690			
Slate & Shells			1690	1762			
Gritty Lime			1762	1781			
White Slate			1781	1790			
Red Rock			1790	1838			
Gritty Lime			1838	1850			
Red Rock			1850	1885			
Lime			1885	1893			
Slate			1893	1917			
Little Lime			- 1917	1934			
Slate			1934	1954			
Big Lime			- 1954	2045	S. L. M. on 7" 1971' - 10"		
Sand			2045	2102	Water 2000' - 2009'	22 bailers 7" every 2 hours	
Slate			2102	2123			
TOTAL DEPTH			2123'				

Date _____, 19____

APPROVED _____, Owner

By _____ (Title)