


M

Latitude 39° 10'

Longitude 80° 40'

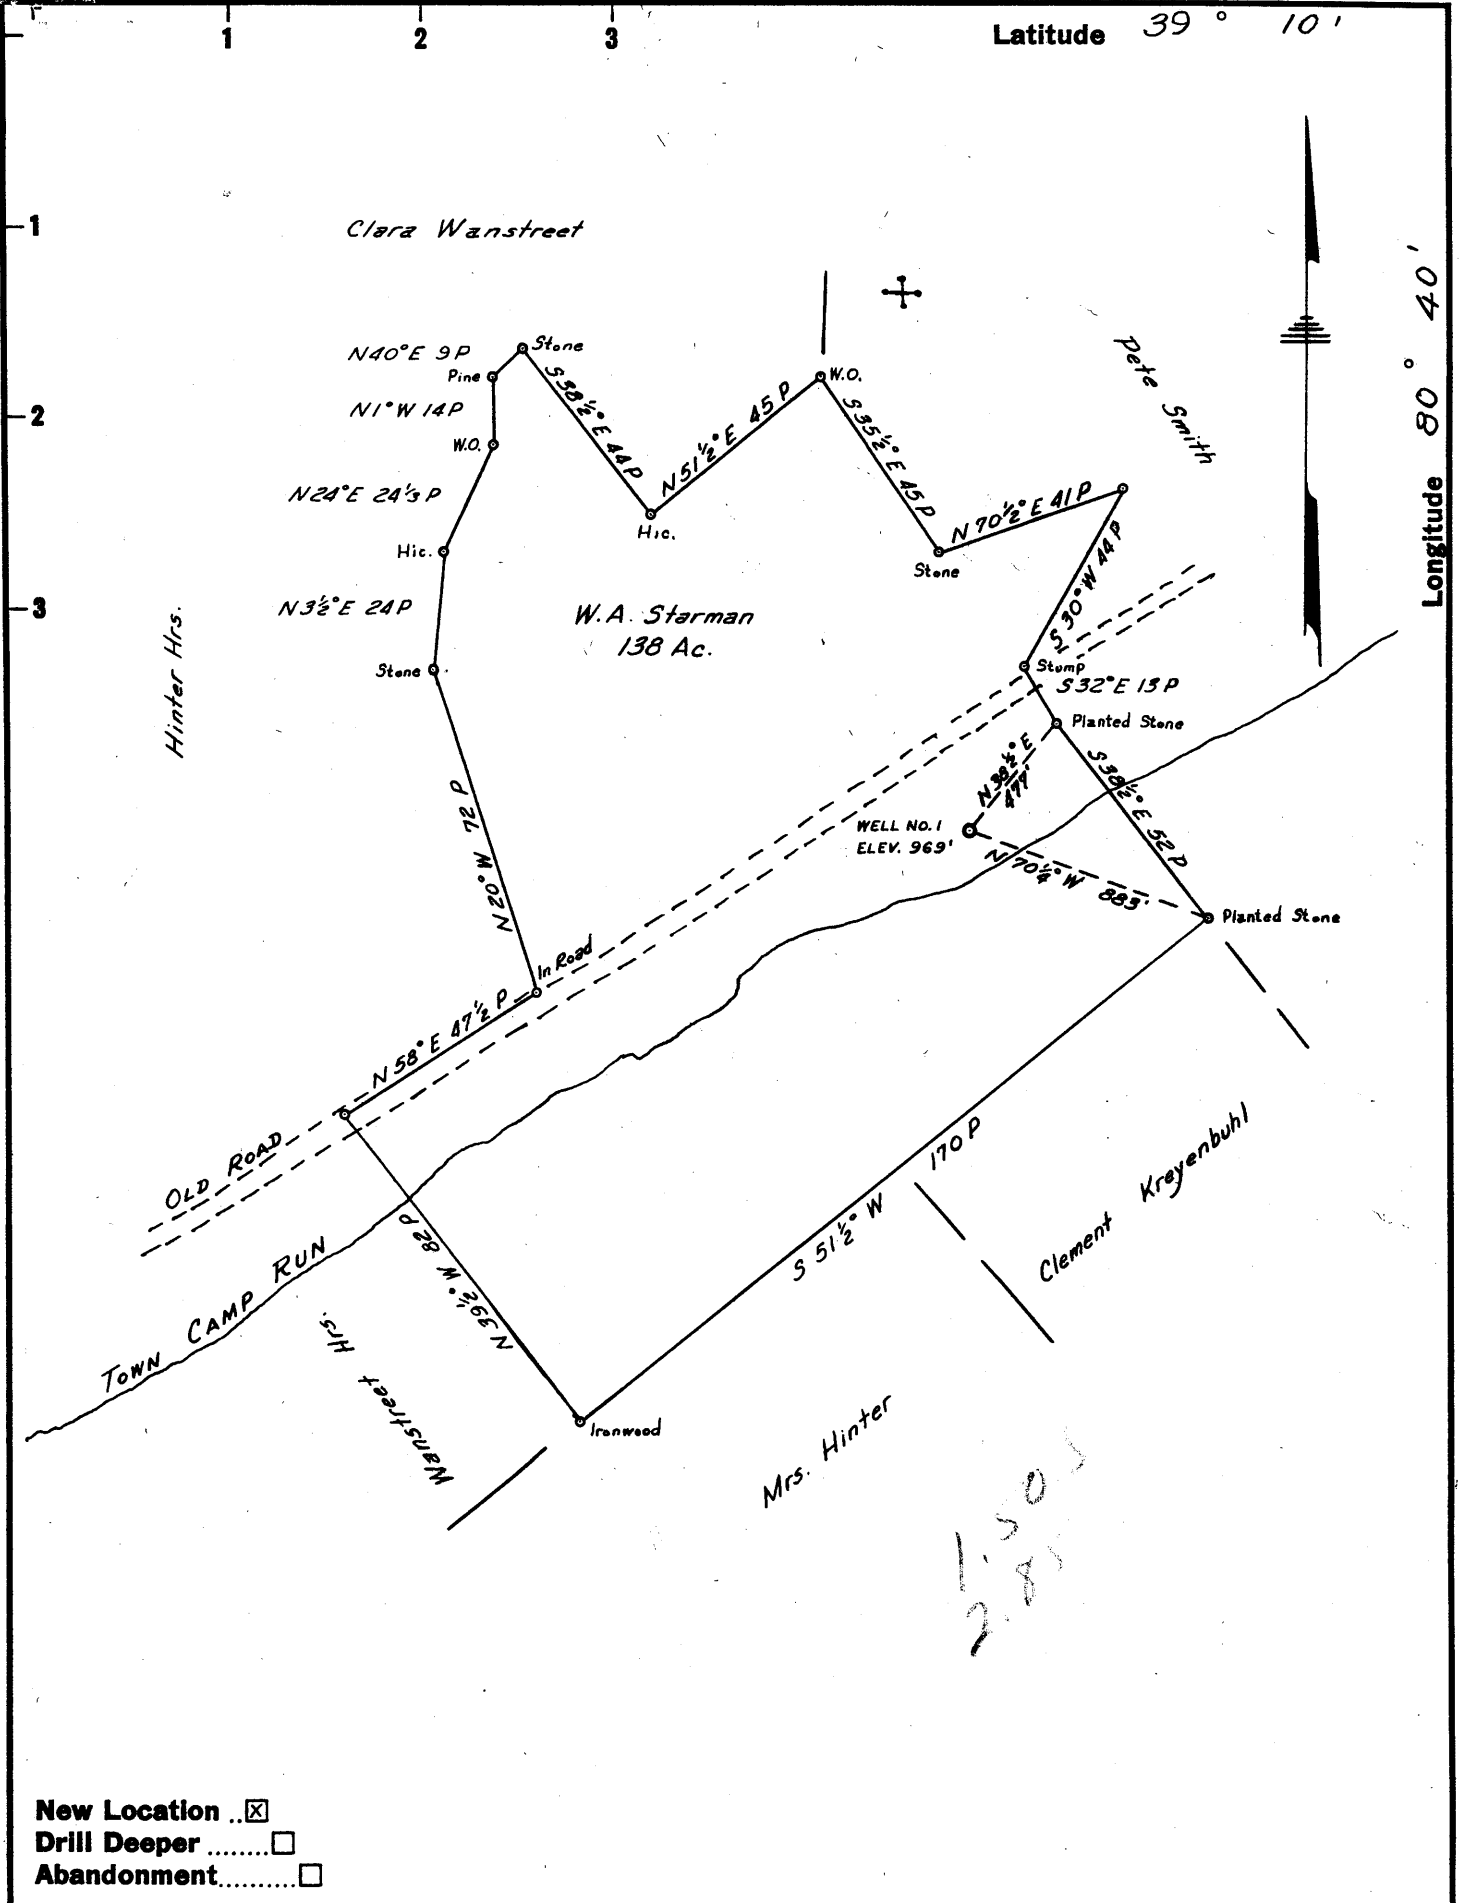

1.50
2.85

- New Location
- Drill Deeper
- Abandonment

Company John Baily

Address P.O. Box 310, Parkersburg, W. Va.

Farm W.A. Starman

Tract 1 Acres 138 Lease No. _____

Well (Farm) No. 1 Serial No. _____

Elevation (Spirit Level) 969'

Quadrangle VADIS

County DODDRIDGE District COVE

Engineer Parker C. Peters
Field - W. R. Ireland

Engineer's Registration No. 485

File No. _____ Drawing No. _____

Date February 11, 1961 Scale 1"=40P

STATE OF WEST VIRGINIA
DEPARTMENT OF MINES
OIL AND GAS DIVISION
CHARLESTON

WELL LOCATION MAP
FILE NO. DOD-530

- + Denotes location of well on United States Topographic Maps, scale 1 to 62,500, latitude and longitude lines being represented by border lines as shown.
- Denotes one inch spaces on border line of original tracing.

306



STATE OF WEST VIRGINIA
DEPARTMENT OF MINES
OIL AND GAS DIVISION 4

Quadrangle VADIS

Permit No. DOD-530

WELL RECORD

Oil or Gas Well DRY
(KIND)

Company JOHN S. BAILEY
Address P. O. BOX 310 - PARKERSBURG, W. VA.
Farm W. A. STARMAN Acres 138
Location (waters) Town Camp Run
Well No. 1 Elev. 969'
District COVE County DODDRIDGE
The surface of tract is owned in fee by W. A. Starman
Address Leopole, W. Va.
Mineral rights are owned by Same
Address same
Drilling commenced 2/18/61
Drilling completed 3/23/61
Date Shot _____ From _____ To _____
With _____
Open Flow _____ /10ths Water in _____ Inch
_____ /10ths Merc. in _____ Inch
Volume _____ Cu. Ft.
Rock Pressure _____ lbs. _____ hrs.
Oil _____ bbls., 1st 24 hrs.
WELL ACIDIZED _____

Casing and Tubing	Used in Drilling	Left in Well	Packers
Size			Kind of Packer
16	17'	17'	
13			
10	305'	305'	Size of
8 3/4	1068'	1068'	
6 3/4			Depth set
5 3/16			
3			Perf. top
2			Perf. bottom
Liners Used			Perf. top
			Perf. bottom

CASING CEMENTED _____ SIZE _____ No. Ft. _____ Date _____

COAL WAS ENCOUNTERED AT _____ FEET _____ INCHES
_____ FEET _____ INCHES FEET _____ INCHES
_____ FEET _____ INCHES FEET _____ INCHES


WELL FRACTURED _____

RESULT AFTER TREATMENT _____

ROCK PRESSURE AFTER TREATMENT _____

Fresh Water _____ Feet Salt Water _____ Feet

Formation	Color	Hard or Soft	Top	Bottom	Oil, Gas or Water	Depth	Remarks
Clay			0	20			
Lime			20	35			
R. Rock			35	45			water
Lime			45	65			hole full
R. Rock			65	70			18 ft.
Lime			70	85			
R. Rock			85	115			
Lime			115	140			
Slate			140	155			
R Rock			155	168			
Lime			168	185			
R Rock			185	220			
R Rock			239	345			
Sand			345	385			water 1 - 10 bailers pr. hr. -360'
Slate			385	395			
Slate & Lime			395	525			
Flint rock			525	535			
R. Rock			535	550			
Slate & Shells			550	585			
Sand			585	611			
Slate-			611	620			
Lime			620	630			
Sand			630	655			
R. Rock			655	687			
Sand			687	708			
R. Rock			708	750			

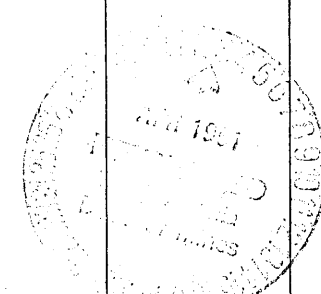

Formation	Color	Hard or Soft	Top 4	Bottom	Oil, Gas or Water	Depth Found	Remarks
Slate & Shells			750	765			
R. Rock			765	790			
Sand - hard			790	855			
Slate Shells			855	885			
R. Rock			885	922			
Slate & Shells			922	960			
R. Rock			960	975			
Slate & Shells			975	990			
R. Rock			990	1000			
H Lime Sand			1000	1009			
Slate & Lime			1009	1017			
Sand			1017	1025			
R. Slate			1025	1075			
Lime			1075	1120			
Slate			1120	1125			
Lime			1125	1160			
Sand			1160	1200			
Slate & Shells			1200	1240			
Sand-			1240	1270			
Slate & Shells			1270	1385			
Sand-			1385	1416			
Slate - Bark			1416	1539			
Sand			1539	1575			
Slate & Shells			1575	1600			
Sand			1600	1700			
Slate & Shells			1700	1715			
Sand			1715	1745			
Pink Rock			1745	1754			
Sandy lime			1754	1806			
Sand-			1806	1838			
R. Rock			1838	1870			
Slate			1870	1880			
Lime			1880	1908			
Sandy lime			1908	1922			
brake pencil			1922	1927			
BIG LIME			1927	2010			
INJUN SAND			2010	2081			
Slate & Shells			2081	2173			
Sand			2173	2295			
Slate & Shells			2295	2385	show gas	2242'	
Sand			2385	2450			
Slate & Shells			2450	2490			
Sand			2490	2505			
Shale			2505	2530			
Slate & Shells			2530	2580			
Sand-			2580	2590	small show oil	2590'	
Shale			2590				
	TOTAL DEPTH		2728'				

Date _____, 19____

APPROVED _____, Owner

By _____
(Title)