

- Redrill.....
- New Location.
- Drill Deeper.....
- Abandonment.....

Company ALLEGHENY LAND & MINERAL CO.
 Address CLARKSBURG, W.VA.
 Farm FLOYD KELLEY
 Tract _____ Acres 33 Lease No. _____
 Well (Farm) No. 2 Serial No. A-155
 Elevation (Spirit Level) 1096' V.A.
 Quadrangle CENTERPOINT SW2E - C
 County DODDRIDGE District M'CLELLAN
 Engineer James D. Jeffries
 Engineer's Registration No. 1084
 File No. 202/112 Drawing No. _____
 Date 8-5-61 Scale 1" = 500'

STATE OF WEST VIRGINIA
 DEPARTMENT OF MINES
 OIL AND GAS DIVISION
 CHARLESTON

WELL LOCATION MAP
 FILE NO. DOD-600

+ Denotes location of well on United States Topographic Maps, scale 1 to 62,500, latitude and longitude lines being represented by border lines as shown.

— Denotes one inch spaces on border line of original tracing.

RDM



STATE OF WEST VIRGINIA
DEPARTMENT OF MINES
OIL AND GAS DIVISION 6

Quadrangle Centerpoint

Permit No. D0d-600

WELL RECORD

Oil or Gas Well Gas
(KIND)


Company Allegheny Land & Mineral Co.
Address Clarksburg, W.Va.
Farm Floyd Kelley Acres 33
Location (waters)
Well No. A-155 Elev. 1096
District McClellan County Doddridge
The surface of tract is owned in fee by Kelley heirs
Address Salem, W.Va.
Mineral rights are owned by Same
Address _____
Drilling commenced August 28, 1961
Drilling completed September 22, 1961
Date Shot _____ From _____ To _____
With _____
Open Flow /10ths Water in No test Inch
/10ths Merc. in Inch
Volume Show only Cu. Ft.
Rock Pressure None taken lbs. hrs.
Oil _____ bbls., 1st 24 hrs.
WELL ACIDIZED _____

Casing and Tubing	Used in Drilling	Left in Well	Packers
Size			Kind of Packer
16	18'	18'	
13			
10			Size of
8 1/4	433'	433'	
6 5/8	1204'		Depth set
5 3/16 4 1/2"	2150'	2150'	
3			Perf. top 2044
2			Perf. bottom 2050
Liners Used			Perf. top 2072
			Perf. bottom 2078

WELL FRACTURED Sept. 29, 1961 By Dowell - Water, sand, acid

RESULT AFTER TREATMENT 8 1/2" Spring gauge 1" 516 M CF - gas
ROCK PRESSURE AFTER TREATMENT 560# in 16 hr. 2nd test
Fresh Water 5-1 Bailer per hr Feet 1090 Salt Water 8 bailers per hr Feet 1575

Formation	Color	Hard or Soft	Top	Bottom	Oil, Gas or Water	Depth	Remarks
Top soil			0	10			
Red Rock			10	50			
Soap stone			50	72			
Red Rock			72	100			
Sand			100	110			
Red Rock			110	135			
Slate & shells			135	180			
lime			180	205			
Red Rock			205	215			
Slate & shells			215	270			
Red Rock			270	290			
Sand			290	320			
Slate & shells			320	340			
Sand			340	380			
Slate & shells			380	430			
lime			430	455			
Slate & shells			455	645			
Slate Black			645	660			
Slate & shells			660	700			
Sand			700	725			
Slate & shells			725	825			
Gritty Lime			825	850			
Slate & shells			850	975			
Red Rock			975	1005			
Slate & shells			1005	1080			
limestone			1080	1105			
lime	Gritty		1105	1140	Water	1090	
lime	Black		1140	1160		5- 8" bailers per 1 1/2 hr	
Slate & shells			1160	1190		Fresh	
Slate			1190	1230			

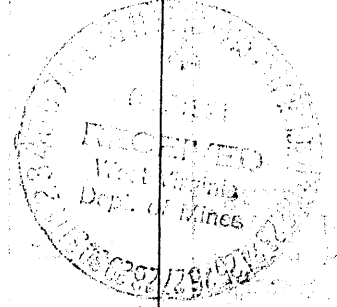

Formation	Color	Hard or Soft	Top ⁶	Bottom	Oil, Gas or Water	Depth Found	Remarks
Slate & shells			1230	1305			
Lime			1305	1335			
Lime		Gritty	1335	1370			
Slate & shells			1370	1425			
Sand			1425	1455			
Slate & shells			1455	1480			
Lime		Gritty	1480	1510			
Slate	Black		1510	1540			
Sand			1540	1720	Water	1575	Fresh
Black Lime			1720	1740			8- 6" bailers:
Sand			1740	1805			per 2 hr.
Pink Rock			1805	1820			Salty
Slate & shells			1820	1835			
Pink Rock			1835	1845			
Slate			1845	1853			
Red Rock			1853	1890			
Slate			1890	1907			
Pencil Cave			1907	1910			
Slate			1910	1945			
Big Lime			1945	2009			
Sand			2009	2034			
Lime			2034	2044			
Sand			2044	2135	Gas	2055-2065	Small show
Slate			2135	2137			
Sand			2137				
Total depth				2150			

Date October 11, 1961

APPROVED Allegheny Land & Mineral Co., Owner

By Claron Dawson, Mahone, W. Va.
(Title)

STATE OF WEST VIRGINIA
DEPARTMENT OF ENVIRONMENTAL PROTECTION
OFFICE OF OIL AND GAS

AFFIDAVIT OF PLUGGING AND FILLING WELL

AFFIDAVIT SHOULD BE IN TRIPLICATE, one copy mailed to the Department, one copy to be retained by the Well Operator and the third copy (and extra copies if required) should be mailed to each coal operator at their respective addresses.

Farm name: Conway, John T. Operator Well No.: Kelly #2 10607

LOCATION: Elevation: 1102' Quadrangle: Smithburg 7.5'
District: McClellan County: Doddridge
Latitude: 8900 Feet South of 39 Deg. 22 Min. 30 Sec.
Longitude: 1690 Feet West of 80 Deg. 37 Min. 30 Sec.

Well Type: OIL _____ GAS X

Company: Dominion Exploration & Production, Inc Coal Operator John T Conway
445 W Main St. or Owner 1407 Gramby Street
Clarksburg, WV 26301 Temperance, Mi 48182

Agent: Rodney J. Biggs Coal Operator _____
or Owner _____

Permit Issued Date: '06/05/2001

AFFIDAVIT

STATE OF WEST VIRGINIA,
County of Doddridge ss:

David L. Johnson being first duly sworn according to law depose and say that they are experienced in the work of plugging and filling oil and gas wells and were employed by the above named well operator, and participated in the work of plugging and filling the above well, and Mike Underwood Oil and Gas Inspector representing the Director, say that said work was commenced on the 14th day of August, 2001, and that the well was plugged and filled in the following manner:

TYPE	FROM	TO	PIPE REMOVED	LEFT
Cement	2150	1900		
Gel	1900	953	4 1/2" -985'	4 1/2' -1165'
Cement	953	803		
Gel	803	476		
Cement	476	376		
Gel	376	159		
Cement	159	Surface		16" - 18'

Description of monument: 2" Tbg. W/ 1/4" x 12" x 12" plate w/Well No., Co. Name, API No., Date and that the work of plugging and filling said well was completed on the 16th day of August, 2001.

And further deponents saith not. David L. Johnson

Sworn and subscribe before me this 22nd day of August, 2001

My commission expires: December 26, 2010
Linda E. Riffle
Notary Public

Oil and Gas Inspector: Tom Barnett 11-18-03
for Mike Underwood

Office of Chief
NOV 25 2003
WV Department
Environmental Protection

OFFICIAL SEAL
NOTARY PUBLIC
STATE OF WEST VIRGINIA
LINDA E. RIFFLE
RT. 1, BOX 271-A
WESTON, WV 26452
My Commission Expires December 26, 2010

0000 0600 P