

NOTE:
 H.C. CHAPMAN HRS, % EDW. CHAPMAN, 100 MARIE ST,
 WEST UNION, W. VA. OWN 1/2 O & G RIGHTS.
 DECO VAN HORN HRS, % GARNET WEBSTER 336 LABEL AVE,
 ACADIA, CAL. OWN 1/2 O & G RIGHTS

New Location
 Drill Deeper
 Abandonment

Company A. A. KELLEY
 Address P.O. BOX 309, CLARKSBURG, W.VA.
 Farm ROY RUPPERT HRS.
 Tract _____ Acres 120 1/4 Lease No. _____
 Well (Farm) No. 1 Serial No. _____
 Elevation (Spirit Level) 1042'
 Quadrangle HOLBROOK. - EC
 County DODDRIDGE District COVE
 Engineer John W. Hamilton
 Engineer's Registration No. 2274
 File No. _____ Drawing No. _____
 Date AUGUST 11, 1961 Scale 1" = 40 P

STATE OF WEST VIRGINIA
 DEPARTMENT OF MINES
 OIL AND GAS DIVISION
 CHARLESTON

WELL LOCATION MAP
 FILE NO. DOD-603

+ Denotes location of well on United States Topographic Maps, scale 1 to 62,500, latitude and longitude lines being represented by border lines as shown.

- Denotes one inch spaces on border line of original tracing.



STATE OF WEST VIRGINIA
DEPARTMENT OF MINES
OIL AND GAS DIVISION

Quadrangle Holbrook

Permit No. DOD-603

WELL RECORD

Oil or Gas Well Dry (KIND)


Company A. A. Kelly
 Address West Union, W. Va.
 Farm Roy Rupert Heirs Acres 120 1/4
 Location (waters) Hughes River
 Well No. One Elev. 1042'
 District Cove County Doddridge
 The surface of tract is owned in fee by Roy Rupert Heirs
 Address Grove, W. Va.
 Mineral rights are owned by Same
 Address _____
 Drilling commenced 8/25/61
 Drilling completed 9/26/61
 Date Shot _____ From _____ To _____
 With _____
 Open Flow _____ /10ths Water in _____ Inch
 _____ /10ths Merc. in _____ Inch
 Volume _____ Cu. Ft.
 Rock Pressure _____ lbs. _____ hrs.
 Oil _____ bbls., 1st 24 hrs.
 WELL ACIDIZED _____
 WELL FRACTURED _____

Casing and Tubing	Used in Drilling	Left in Well	Packers
Size			Kind of Packer
16			
13			
10	173'		Size of
8 3/4" 8"	780'		
6 5/8"			Depth set
5 3/16"			
3			Perf. top
2			Perf. bottom
Liners Used			Perf. top
			Perf. bottom

CASING CEMENTED _____ SIZE _____ No. Ft. _____ Date _____
 COAL WAS ENCOUNTERED AT None FEET _____ INCHES
 _____ FEET _____ INCHES FEET _____ INCHES
 _____ FEET _____ INCHES FEET _____ INCHES

RESULT AFTER TREATMENT _____
 ROCK PRESSURE AFTER TREATMENT _____
 Fresh Water None Feet _____ Salt Water None Feet _____

Formation	Color	Hard or Soft	Top	Bottom	Oil, Gas or Water	Depth	Remarks
0'	25'	Soil					
25'	120	Sand					
120	285	Shale					
285	335	Sand					
335	360	Shale					
360	375	Sand					
375	440	Shale					
440	470	Sand					
470	478	Shale					
478	485	Sand					
485	737	Shale					
737	756	Sand					
756	835	Shale					
835	863	Sand					
863	990	Shale					
990	1025	Sand					
1025	1045	Shale					
1045	1170	Sand					
1170	1190	Shale					
1190	1210	Sand					
1210	1238	Shale					
1238	1260	Sand					
1260	1272	Shale					
1272	1335	Sand					
1335	1370	Shale					
1370	1390	Sand					
1390	1425	Shale					
1425	1450	Sand					
1450	1497	Shale					
1497	1565	Sand					

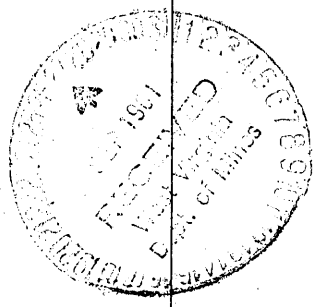

Formation	Color	Hard or Soft	Top ζ	Bottom	Oil, Gas or Water	Depth Found	Remarks
1565'	1625'	Shale					
1625	1674	Sand					
1674	1725	Shale					
1725	1796-	Lime					
1796	1820	Shale					
1820	1876 -	Lime (Big Lime)					
1876	1945	Sand (Big Injun)					
1945	1955	Shale					
	1955'	T. D.					

Date _____, 19____

APPROVED _____, Owner

By _____
(Title)