


M

Handwritten initials

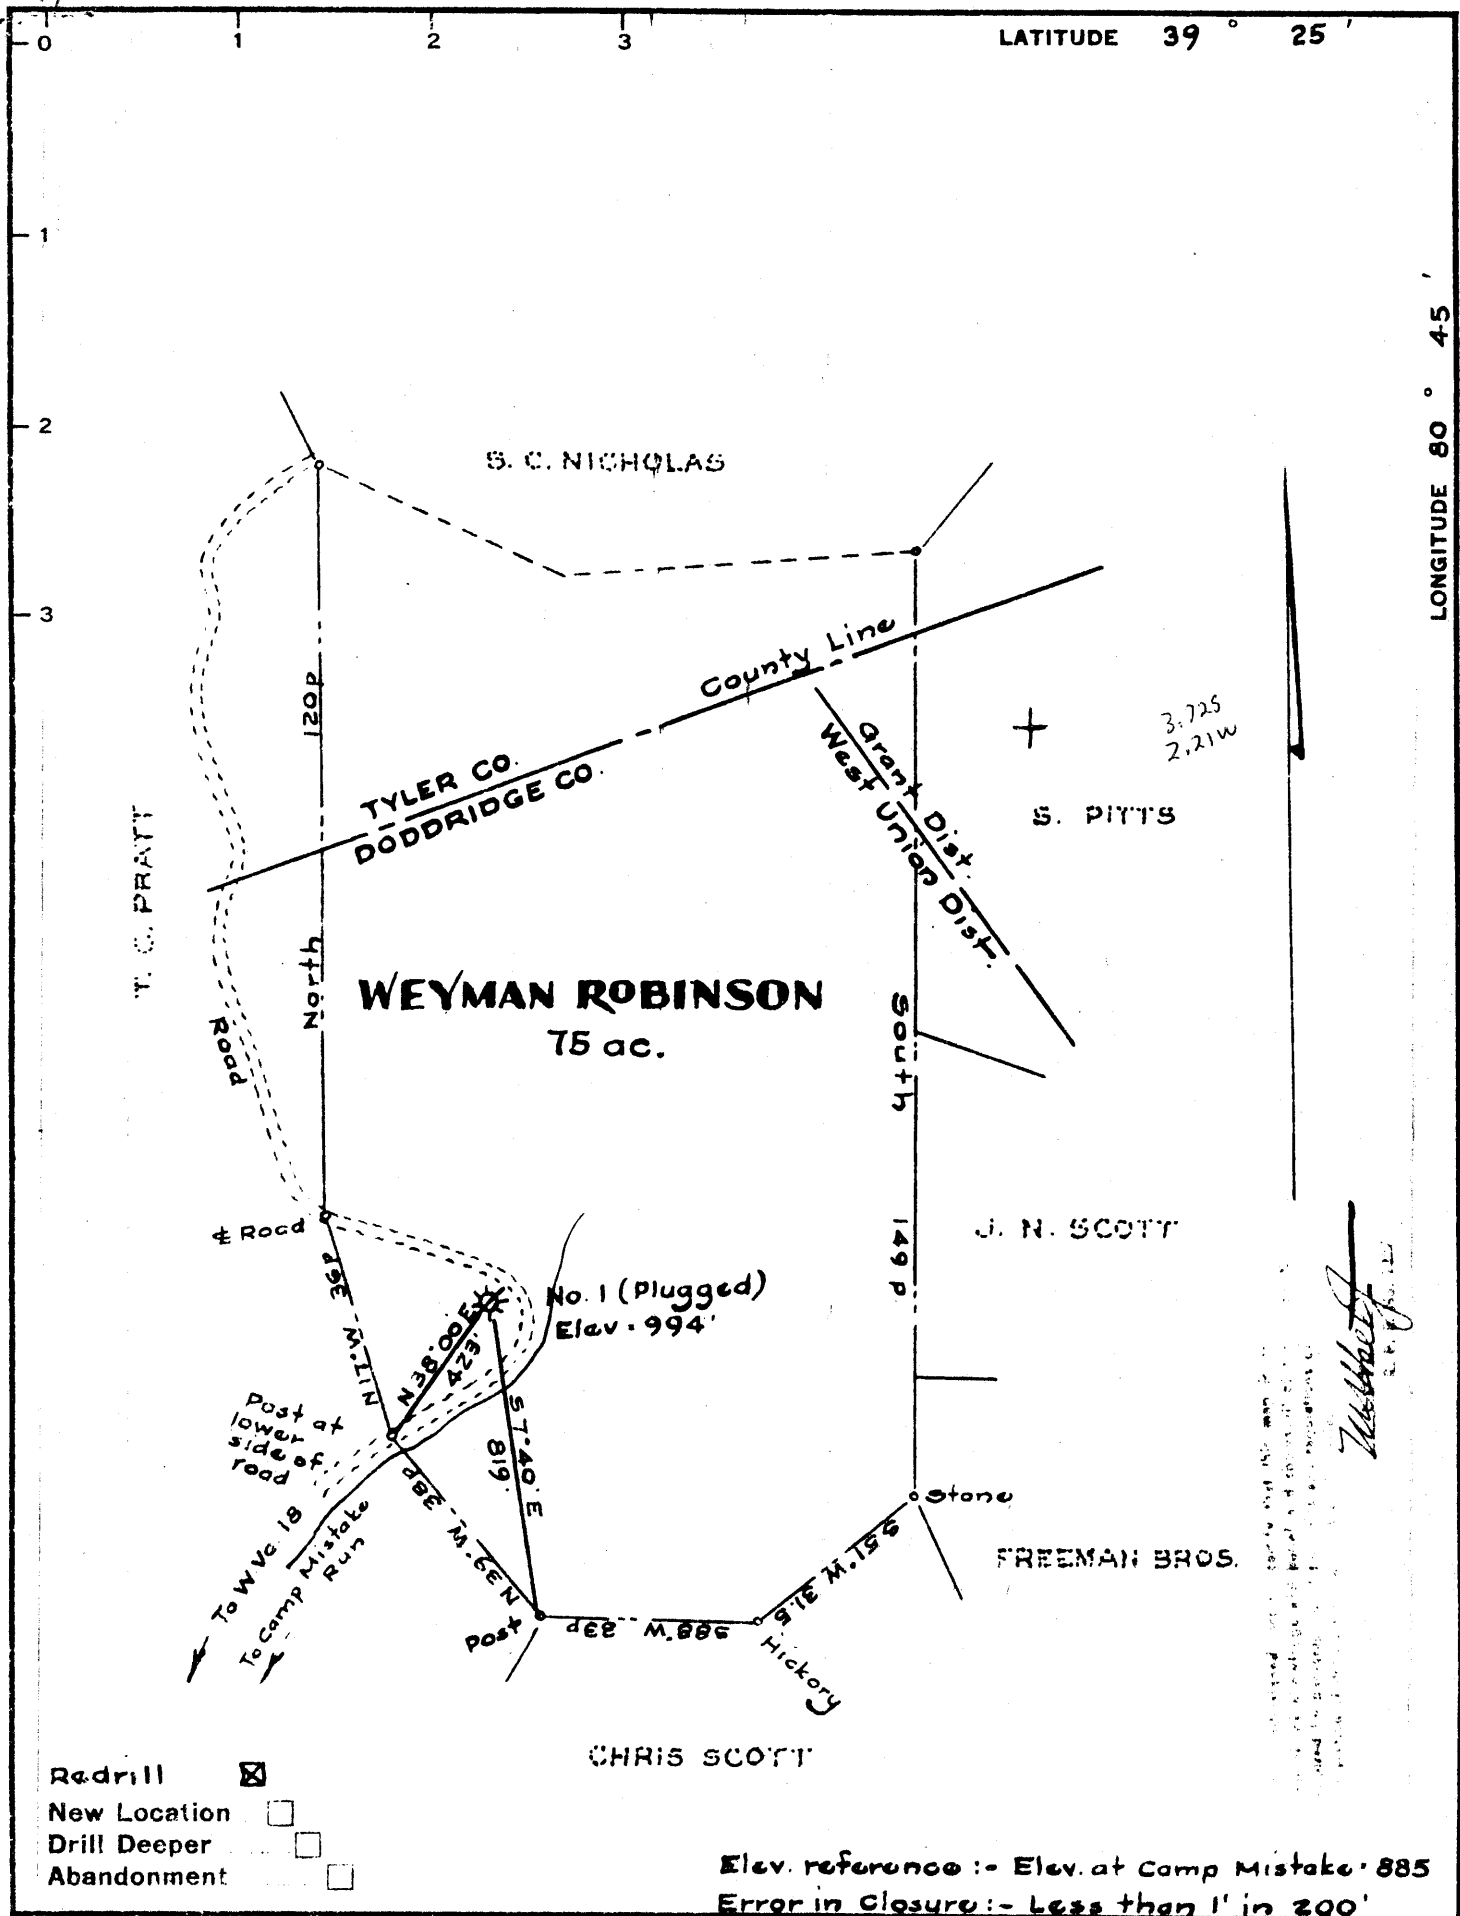

Handwritten signature

Company BUCK AND DWYER, INC.

Address Aldie, Virginia.

Farm Weyman Robinson

Tract Acres 75 Lease No. _____

Well (Farm) No. One Serial No. _____

Elevation (Spirit Level) 994

Quadrangle West Union-EC

County Doddridge District West Union

Engineer [Signature]

Engineer's Registration No. 1227

File No. _____ Drawing No. _____

Date Jan. 7, 1966 Scale 1" = 300' = 495'

STATE OF WEST VIRGINIA
DEPARTMENT OF MINES
OIL AND GAS DIVISION
CHARLESTON

WELL LOCATION MAP
FILE NO. DOD-~~XXXX~~
607-Redrill

+ Denotes location of well on United States Topographic Maps, scale 1 to 62,500, latitude and longitude lines being represented by border lines as shown.

- Denotes one inch spaces on border line of original tracing.



STATE OF WEST VIRGINIA
DEPARTMENT OF MINES
OIL AND GAS DIVISION

West Union

WELL RECORD

Permit No. Dod-607

Oil or Gas Well Dry
(1975)

Company Ole Colony Development Co.
 Address Box 158, West Union, W.Va.
 Farm Weyman Robinson Acres 75
 Location (waters) _____
 Well No. one Elev. 994
 District West Union County Doddridge
 The surface of tract is owned in fee by Gale Scott
West Union Address W.Va.
 Mineral rights are owned by Robinson Hrs.
 Address _____
 Drilling commenced Sept. 7, 1961.
 Drilling completed Oct. 10, 1961.
 Date Shot _____ From _____ To _____
 With _____
 Open Flow _____ /10ths Water in _____ Inch
 _____ /10ths Merc. in _____ Inch
 Volume show of gas _____ Cu. Ft.
 Rock Pressure _____ lbs. _____ hrs.
 Oil _____ bbls., 1st 24 hrs.
 Fresh water _____ feet _____ feet
 Salt water _____ feet _____ feet

Casing and Tubing	Used in Drilling	Left in Well	Packers
Size			Kind of Packer
16			
13			
10	270'		Size of
8 1/2	1005'		Depth set
6 1/2			
5 3/16			
3			Perf. top
2			Perf. bottom
Liners Used			Perf. top
			Perf. bottom

CASING CEMENTED _____ SIZE _____ No. Ft. _____ Date _____

COAL WAS ENCOUNTERED AT _____ FEET _____ INCHES
 _____ FEET _____ INCHES FEET _____ INCHES
 _____ FEET _____ INCHES FEET _____ INCHES

Formation	Color	Hard or Soft	Top	Bottom	Oil, Gas or Water	Depth Found	Remarks
Top soil			0	10			
Sand & Gravel			10	28	25		
Slate & shells			28	993			
Sand & Lime			993	1021			
Slate & Shells			1021	1313			
Sand & Lime Shells			1313	1580			
Slate			1580	1590			
Sand & Lime			1590	1714			
Lime			1714	1793 - 1793			
Slate		1793	1793	1811			
Lime	Big Lime		1811	1895			
Slate	Big Lime	1895	1895	1993			
Big Injun Sand		1895	1993	1998	Gas show	at 1399'	
Slate & Shells			1993	2040			
Total Depth				2040			



STATE OF WEST VIRGINIA
DEPARTMENT OF MINES
OIL AND GAS DIVISION

WELL RECORD

Permit No. DOD-607-RED.

Oil or Gas Well **GAS**
(KIND)

Company BUCK & DWYER, INC.
 Address ALDIE VIRGINIA
 Farm WEYMAN ROBINSON Acres 75
 Location (waters) CAMP MISTAKE
 Well No. 1 Elev. 994'
 District WEST UNION County DODDRIDGE
 The surface of tract is owned in fee by G.S. SCOTT
WEST UNION W. VA. Address _____
 Mineral rights are owned by WEYMAN ROBINSON
MANNINGTON, W. VA. Address _____
 Drilling commenced JAN. 30/66
 Drilling completed MAR. 12/66
 Date Shot _____ From _____ To _____
 With _____
 Open Flow _____ /10ths Water in _____ Inch
 _____ /10ths Merc. in _____ Inch
 Volume 150,000 *gallon* Cu. Ft.
 Rock Pressure 280 lbs. 24 hrs.
 Oil _____ bbls., 1st 24 hrs.
 Fresh water _____ feet
 Salt water 10' feet

Casing and Tubing	Used in Drilling	Left in Well	Packers
Size			
16	20'	20'	Kind of Packer
18			
10	280		Size of
8 1/4	1005		
6 3/8			Depth set
5 3/16			
4 1/2"	2020	2020	Perf. top <u>1900</u>
2			Perf. 1926 <u>1926</u>
Liners Used			Perf. 1968 <u>1968</u>
			Perf. bottom

CASING CEMENTED 4 1/2" SIZE J55 No. Ft. 2020 Date MARCH 14/66

COAL WAS ENCOUNTERED AT None FEET INCHES
 FEET INCHES FEET INCHES
 FEET INCHES FEET INCHES

Formation	Color	Hard or Soft	Top	Bottom	Oil, Gas or Water	Depth Found	Remarks
CEMENT SLAB							
RED MUD			0	190	WATER	10'	
CEMENT & STONE			190	200			
RED MUD			200	335			
CEMENT			335	350			
RED MUD			350	392			
STONE AND CEMENT			392	405			
RED MUD AND STONE			405	1010			
CEMENT			1010	1020			
RED MUD			1020	1060			
STONE AND CEMENT			1060	1075			
CEMENT			1285	1295			
RED MUD			1295	1335			
STONE AND CEMENT			1335	1345			
STONE AND CEMENT			1880	1900	GAS	1900	
RED MUD (probably Big Lignite)			1900	2040	GAS	1926	
					GAS	1968	

T. D. 2015

