


271

P

Latitude 39° 15'

Longitude 80° 35'

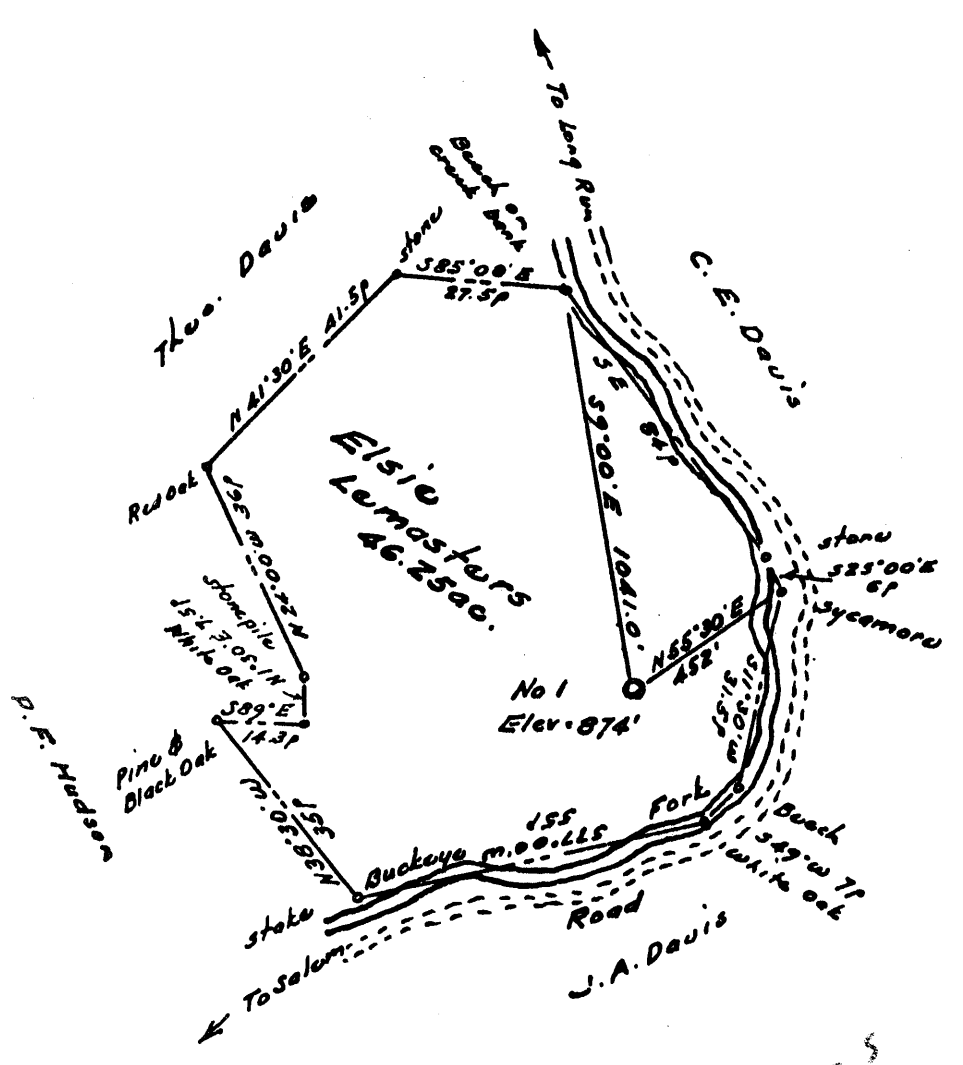

0.225
3.18

- New Location ..
- Drill Deeper
- Abandonment.....

Company	J. H. HOLT
Address	Wells Hotel, Sistersville, W. Va.
Farm	Elsie Lemasters
Tract	Acres 46.25 Lease No. _____
Well (Farm) No.	One Serial No. _____
Elevation (Spirit Level)	874'
Quadrangle	Vadis - NC -
County	Doddridge District Greenbriar
Engineer	<i>[Signature]</i>
Engineer's Registration No.	1227
File No.	_____ Drawing No. _____
Date	Aug 1961 Scale 1" = 30p

STATE OF WEST VIRGINIA
DEPARTMENT OF MINES
OIL AND GAS DIVISION
CHARLESTON

WELL LOCATION MAP
FILE NO. Dod-619

+ Denotes location of well on United States Topographic Maps, scale 1 to _____ latitude and longitude lines being represented by border lines as shown.

- Denotes one inch spaces on border line of original tracing.



STATE OF WEST VIRGINIA
DEPARTMENT OF MINES
OIL AND GAS DIVISION 4

Quadrangle Valley

Permit No. DOD-619

WELL RECORD

Oil or Gas Well Dry

Company <u>J. H. Holt</u>	Casing and Tubing	Used in Drilling	Left in Well	Packers
Address <u>Hotel Wells, Sistersville, W. Va.</u>				
Farm <u>Elsie Lemasters</u> Acres <u>46 25/100</u>	Size			Kind of Packer
Location (waters) <u>Buckeye Fork</u>				
Well No. <u>1</u> Elev. <u>874</u>	16			
District <u>Greenbrier</u> County <u>Doddridge</u>	13			
The surface of tract is owned in fee by <u>Elsie Lemasters</u> Address <u>Salem</u>	10	323'	none	Size of
Mineral rights are owned by <u>Gus Kelly heirs</u> Address _____	8 1/4	1098'		Depth set
	6 3/4	1407'		
Drilling commenced <u>Sept. 22, 1961</u>	5 3/16	1969'		
Drilling completed <u>April 5, 1962</u>	3			Perf. top
Date Shot _____ From _____ To _____	2			Perf. bottom
With _____	Liners Used			Perf. top
Open Flow _____ /10ths Water in _____ Inch				Perf. bottom
_____ /10ths Merc. in _____ Inch				
Volume _____ Cu. Ft.	CASING CEMENTED _____ SIZE _____ No. Ft. _____ Date _____			
Rock Pressure _____ lbs. _____ hrs.				
Oil _____ bbls., 1st 24 hrs.	COAL WAS ENCOUNTERED AT <u>625</u> FEET <u>to</u> <u>632</u> INCHES			
WELL ACIDIZED _____	_____ FEET _____ INCHES _____ FEET _____ INCHES			
WELL FRACTURED _____	_____ FEET _____ INCHES _____ FEET _____ INCHES			


RESULT AFTER TREATMENT

ROCK PRESSURE AFTER TREATMENT

Fresh Water _____ Feet Salt Water _____ Feet

Formation	Color	Hard or Soft	Top	Bottom	Oil, Gas or Water	Depth	Remarks
Sand stone		0	12				
Red Rock		12	40				
Slate		40	50				
Sand		50	75		Water		
Slate		75	110				
Sand		110	130				
Red Rock		130	175				
Sand		175	200				
Slate		200	225				
Sand		225	260		H F Water		
Slate		260	300				
Red Rock		300	310				
Slate & shell		310	454				
Sand		454	500		Water-1 bailer		
Slate & shell		500	625				
Coal		625	632				
Slate & shell		632	655				
Sand		655	700				
Slate		700	705				
Lime		705	725				
Red Rock		725	760				
Slate & Shell		760	800				
Red Rock		800	815				
Slate & Shell		815	835				
Sand		835	860				
Lime		860	885				
Red Rock		885	890				
Slate & Shell		890	1075				
White Slate		1075	1125				

(over)

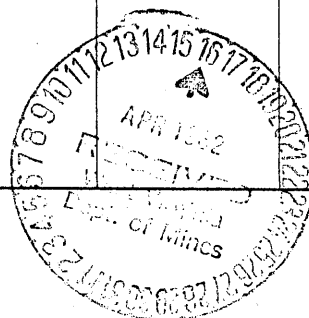

Formation	Color	Hard or Soft	Top 4	Bottom	Oil, Gas or Water	Depth Found	Remarks
Black Slate		1175 x	1175	1175			
Sand			1175	1215			
Slate & Shell			1215	1220			
Sand			1220	1235			
Black Slate			1235	1290			
Sand			1290	1325			
Slate			1325	1380			
Sand			1380	1442			
Slate			1442	1520			
Sandy Lime			1520	1530			
White Slate			1530	1545			
Sand			1545	1580			
Slate & Shell			1580	1700			
Sand			1700	1740			
Slate & Shell			1740	1845			
Sand			1845	1850			
Slate			1850	1880			
Sand			1880	1894			
Red Rock			1894	1900			
Slate			1900	1915			
Sandy Lime			1915	1938			
Slate			1938	1966			
Big Lime			1966	2010			
Sandy Lime			2010	2020			
Lime			2020	2040			
Sand			2040	2104			
Slate			2104	2175			
Bottom hole			2175				

Date....., 19.....

APPROVED....., Owner

By.....
(Title)