

New Location
 Drill Deeper
 Abandonment

Issued 8-30-74

Company FERRELL L. PRIOR
 Address 700 Union Trust Bldg., Parkersburg W. Va.
 Farm Mary P Walton
 Tract _____ Acres 5.75 Lease No. _____
 Well (Farm) No. One Serial No. _____
 Elevation (Spirit Level) 828
 Quadrangle Kadis 1-34 NW
 County Doddridge District New Milton
 Engineer W. H. H. H. H.
 Engineer's Registration No. 1227
 File No. _____ Drawing No. _____
 Date Nov 1961 Scale 1" = 10 poles

STATE OF WEST VIRGINIA
 DEPARTMENT OF MINES
 OIL AND GAS DIVISION
 CHARLESTON

WELL LOCATION MAP
 FILE NO. Dod-674-P

+ Denotes location of well on United States Topographic Maps, scale 1 to 62,500, latitude and longitude lines being represented by border lines as shown.
 - Denotes one inch spaces on border line of original tracing.



STATE OF WEST VIRGINIA
DEPARTMENT OF MINES
OIL AND GAS DIVISION 5

Vadis

Quadrangle _____

Permit No. DOD - 674

WELL RECORD

Oil or Gas Well Oil

(KIND)

Company Ferrell L. Prior
Address 720 Union Trust Building-Parkersburg, W. Va.
Farm Mary Walton Acres 6
Location (waters) Tom's Fork
Well No. One Elev. 828
District New Milton County Doddridge
The surface of tract is owned in fee by Mary P. Walton
New Milton Address West Virginia
Mineral rights are owned by Mary P. Walton
New Milton Address West Virginia
Drilling commenced December 7, 1961
Drilling completed December 13, 1961
Date Shot _____ From _____ To _____
With _____
Open Flow _____ /10ths Water in _____ Inch
_____ /10ths Merc. in _____ Inch
Volume Not taken Cu. Ft.
Rock Pressure Not taken lbs. _____ hrs.
Oil Show bbls., 1st 24 hrs.
WELL ACIDIZED 250 gal. MCA

Casing and Tubing	Used in Drilling	Left in Well	Packers
Size			
16			Kind of Packer _____
13			
10	42'	42'	Size of _____
8 3/4			
7 1/2	2001	2001	Depth set _____
5 3/16			
3			Perf. top <u>1940</u>
2			Perf. bottom <u>1942</u>
Liners Used			Perf. top _____
			Perf. bottom _____

CASING CEMENTED 2001 SIZE 4 1/2" No. Ft. 12-12-61 Date
40 sks. cement - LAWSON

COAL WAS ENCOUNTERED AT None FEET _____ INCHES
_____ FEET _____ INCHES FEET _____ INCHES
_____ FEET _____ INCHES FEET _____ INCHES


WELL FRACTURED 31000 lbs. sand 700 bbls. water
Well drilled with Rotary circulating gel

RESULT AFTER TREATMENT 80 bbls. oil per day

ROCK PRESSURE AFTER TREATMENT 525 lbs. 24 hours

Fresh Water _____ Feet _____ Salt Water _____ Feet _____

Formation	Color	Hard or Soft	Top	Bottom	Oil, Gas or Water	Depth	Remarks
Surface			0	42			
Sand & shale			42	74			
Shale			74	160			
Sand			160	185			
Shale			185	381			
Sand			381	495			
Shale & sand			495	800			
Sandy shale			800	892			
Shale			892	1307			
Sand			1307	1355			
Sand			1355	1490			
Shale			1490	1568			
Lime & sand			1568	1602			
Shale			1602	1615			
Lime & shale			1615	1627			
Lime			1627	1682			
Shale			1682	1695			
Lime			1695	1765			
Sand			1765	1792	Show gas	1780'	
Shale			1792	1795			
Sand			1795	1810	Show oil		
Sand			1810	1820			
Lime			1820	1830			
Lime			1830	1860			
Lime & sand			1860	1870			
Sand			1870	1875	Oil		
Sand			1875	1880	Oil		
Sand			1880	1885			
Lime			1885	1900			

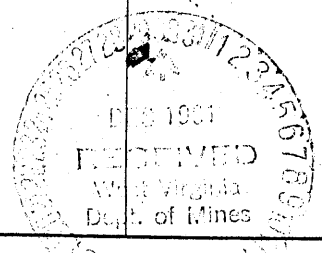

Formation	Color	Hard or Soft	Top ⁵	Bottom	Oil, Gas or Water	Depth Found	Remarks
Lime			1900	1915			
Lime			1915	1925	Oil		
Sand			1925	1950	Oil		
Lime			1950	1955	Oil		
Sand & shell			1955	1983			

Date December 21, 19 61

APPROVED _____, Owner

By [Signature]
(Title)