


M

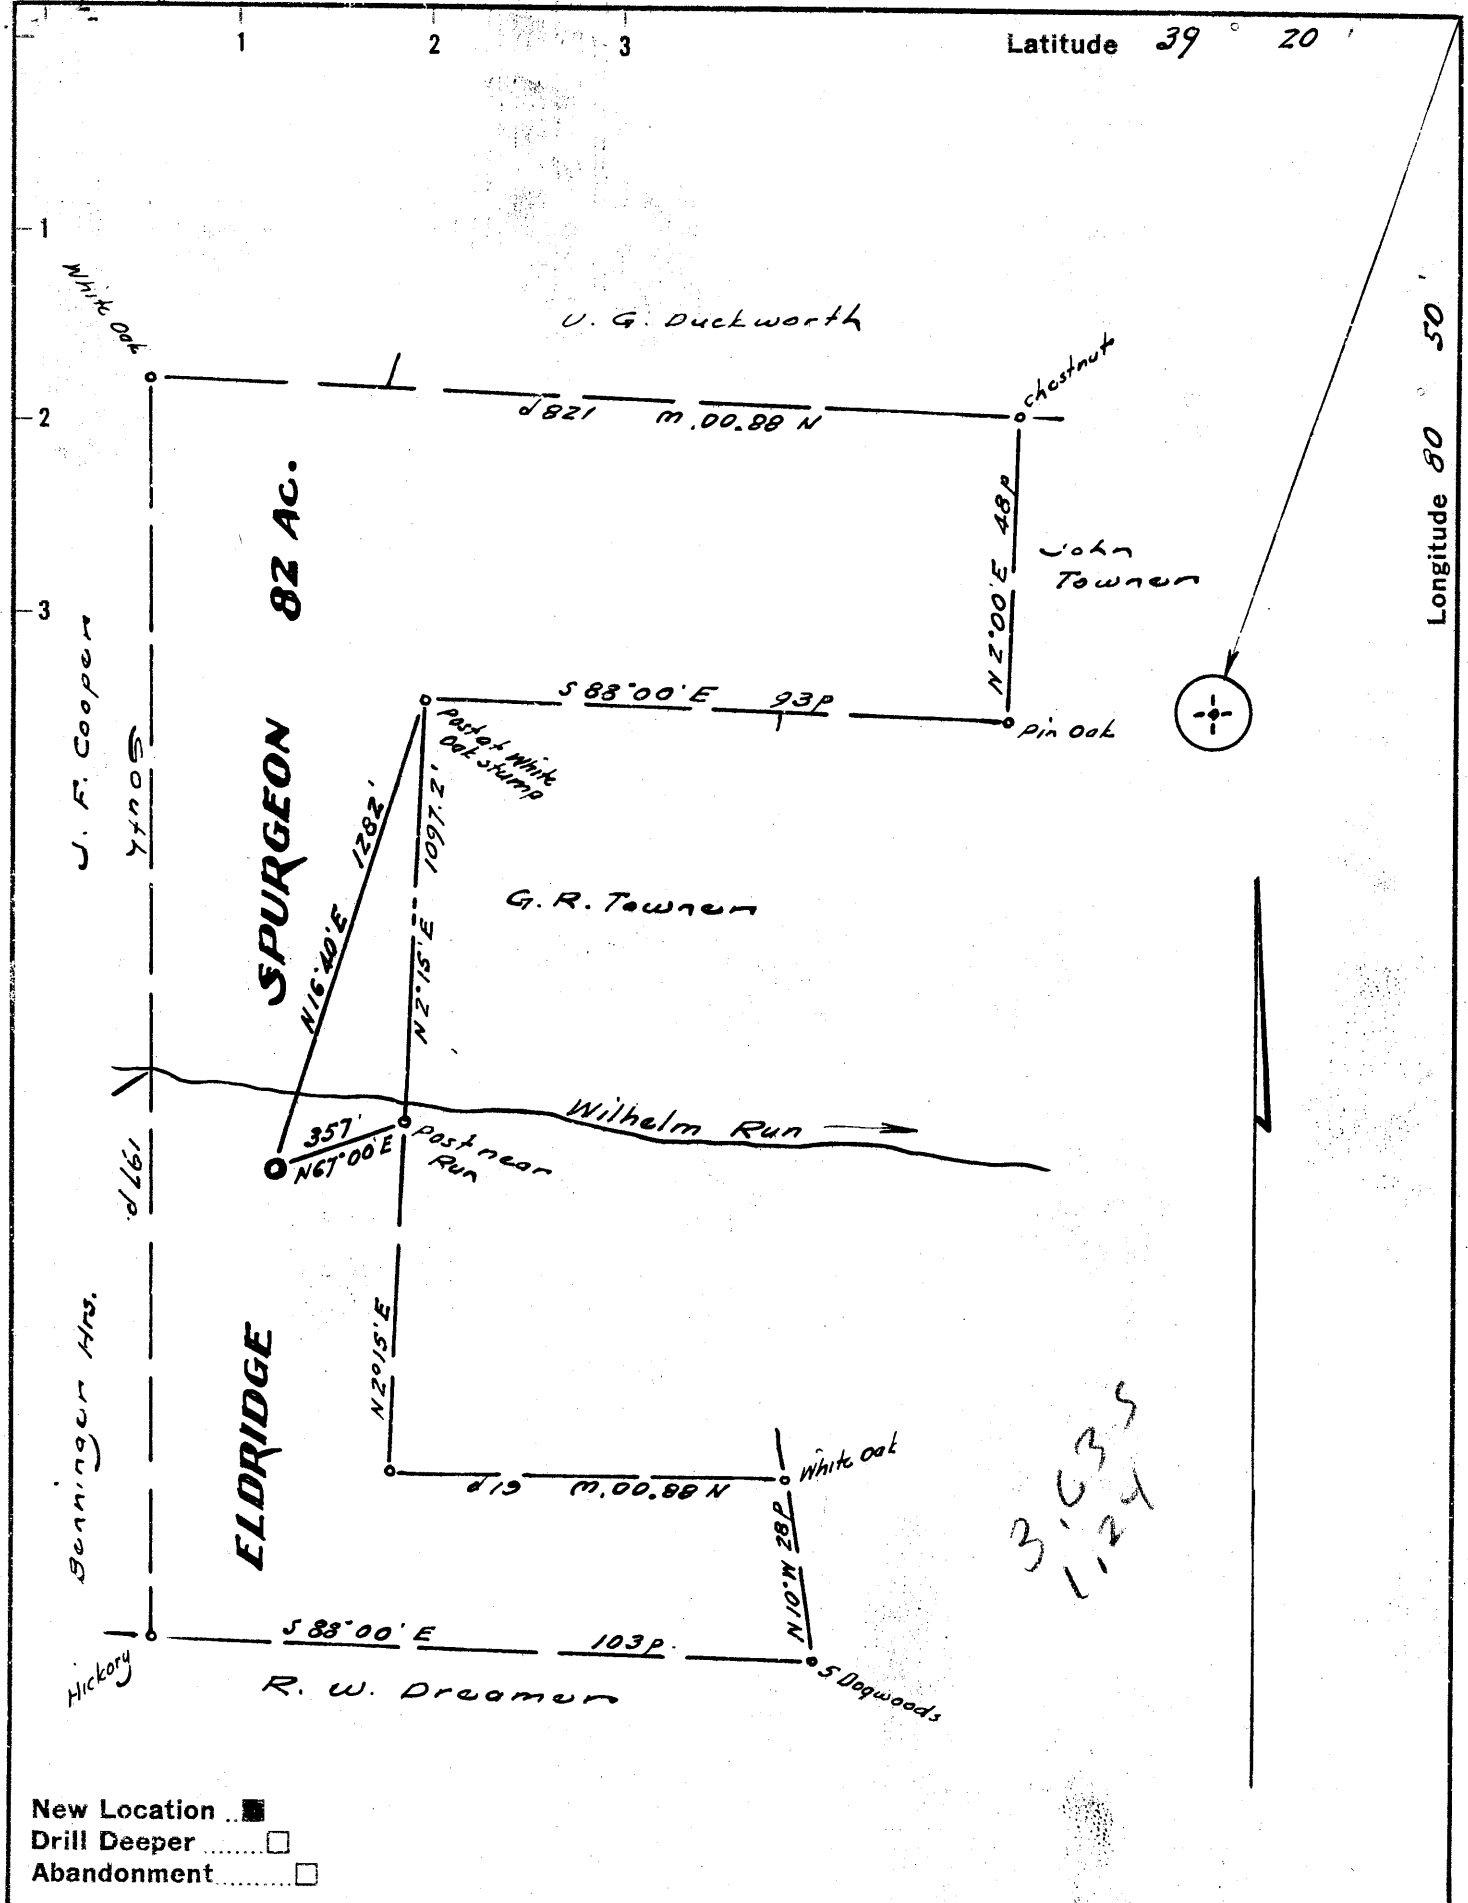

- New Location
- Drill Deeper
- Abandonment

Company OLE COLONY DEVELOPM'T CO.
 Address Box 158, West Union, West Va.
 Farm Eldridge Spurgeon
 Tract _____ Acres 82 Lease No. _____
 Well (Farm) No. One Serial No. _____
 Elevation (Spirit Level) 953'
 Quadrangle West Union SC
 County Doddridge District Central
 Engineer W. S. [Signature]
 Engineer's Registration No. 1227
 File No. _____ Drawing No. _____
 Date January 1962 Scale 1" = 30P

STATE OF WEST VIRGINIA
 DEPARTMENT OF MINES
 OIL AND GAS DIVISION
 CHARLESTON

WELL LOCATION MAP
 FILE NO. Dod-697

+ Denotes location of well on United States Topographic Maps, scale 1 to 62,500, latitude and longitude lines being represented by border lines as shown.
 - Denotes one inch spaces on border line of original tracing.

STATE OF WEST VIRGINIA
DEPARTMENT OF MINES
OIL AND GAS DIVISION 10

Quadrangle West Union

WELL RECORD

Permit No. DD-697

Oil or Gas Well Oil
(KIND)

Company Ole Colony Development Co.
Address West Union, West Virginia
Farm Eldridge Spurgeon Acres 82
Location (waters) Welhelm Run
Well No. One Elev. 953
District Central County Doddridge
The surface of tract is owned in fee by Eldridge Spurgeon
Address West Union, W. Va.
Mineral rights are owned by E. Spurgeon et al
Address W. Va.
Drilling commenced Jan. 27th, 1962
Drilling completed March 26th, 1962
Date Shot None From _____ To _____
With _____
Open Flow /10ths Water in _____ Inch
/10ths Merc. in _____ Inch
Volume None Cu. Ft.
Rock Pressure _____ lbs. _____ hrs.
Oil None bbls., 1st 24 hrs.
WELL ACIDIZED No

Casing and Tubing	Used in Drilling	Left in Well	Packers
Size			Kind of Packer
16			
14"	40'		
10	425'	None	Size of
8 1/2	1160'	None	
6 3/4			Depth set
5 3/16			
3			Perf. top
2			Perf. bottom
Liners Used			Perf. top
			Perf. bottom


CASING CEMENTED None SIZE _____ No. Ft. _____ Date _____

COAL WAS ENCOUNTERED AT None FEET _____ INCHES
FEET _____ INCHES FEET _____ INCHES
FEET _____ INCHES FEET _____ INCHES

WELL FRACTURED No

RESULT AFTER TREATMENT Not treated.
ROCK PRESSURE AFTER TREATMENT Not taken.
Fresh Water 30'-80'-1425' Feet Salt Water None Feet

Formation	Color	Hard or Soft	Top	Bottom	Oil, Gas or Water	Depth	Remarks
Clay			0	10			
Slate			10	20			
Sand			20	30			
Sand			30	35	Fresh water		
Slate & Lime Shells			35	80			
Sand			80	82	Fresh water		
Lime			82	102			
Red Rock			102	118			
Sand			118	138			
Slate & Lime Shells			138	200			
Sand			200	222			
Red Rock			222	240			
Sand			240	306			
Red Rock			306	360			
Lime			360	440			
Red Rock			440	495			
Lime			495	700			
Shale	Black		700	720			
Lime			720	791			
Red Rock			791	865			

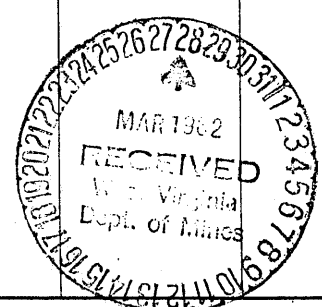

Formation	Color	Hard or Soft	Top / 0	Bottom	Oil, Gas or Water	Depth Found	Remarks
Sand			865	923			
Red Rock			923	1035			
Shale	Black		1035	1084			
Sand			1084	1112			
Pink Rock			1112	1130			
Sand			1130	1320			
Slate			1320	1392			
Lime			1392	1411			
Sand			1411	1425	Salt Sand		
Sand			1425	1432	Water		
Slate			1432	1530			
Lime			1530	1555			
Sand			1555	1623			
Lime			1623	1635			
Sand			1635	1690			
Slate			1690	1700			
Lime			1700	1715			
Shale & Lime Shell			1715	1770			
Lime	Black		1770	1867			
Slate			1867	1876			
Lime	Brown		1876	1956	Top Big Injan 1956'		
Sand			1956	2018			
Slate			2018	2021	T.D.		

Date March 28, 1962, 19__

APPROVED Ole Colony Development Co., Owner

By H. T. Patterson, Superintendent
(Title)