


Latitude 39° 15'

Longitude 80° 40'

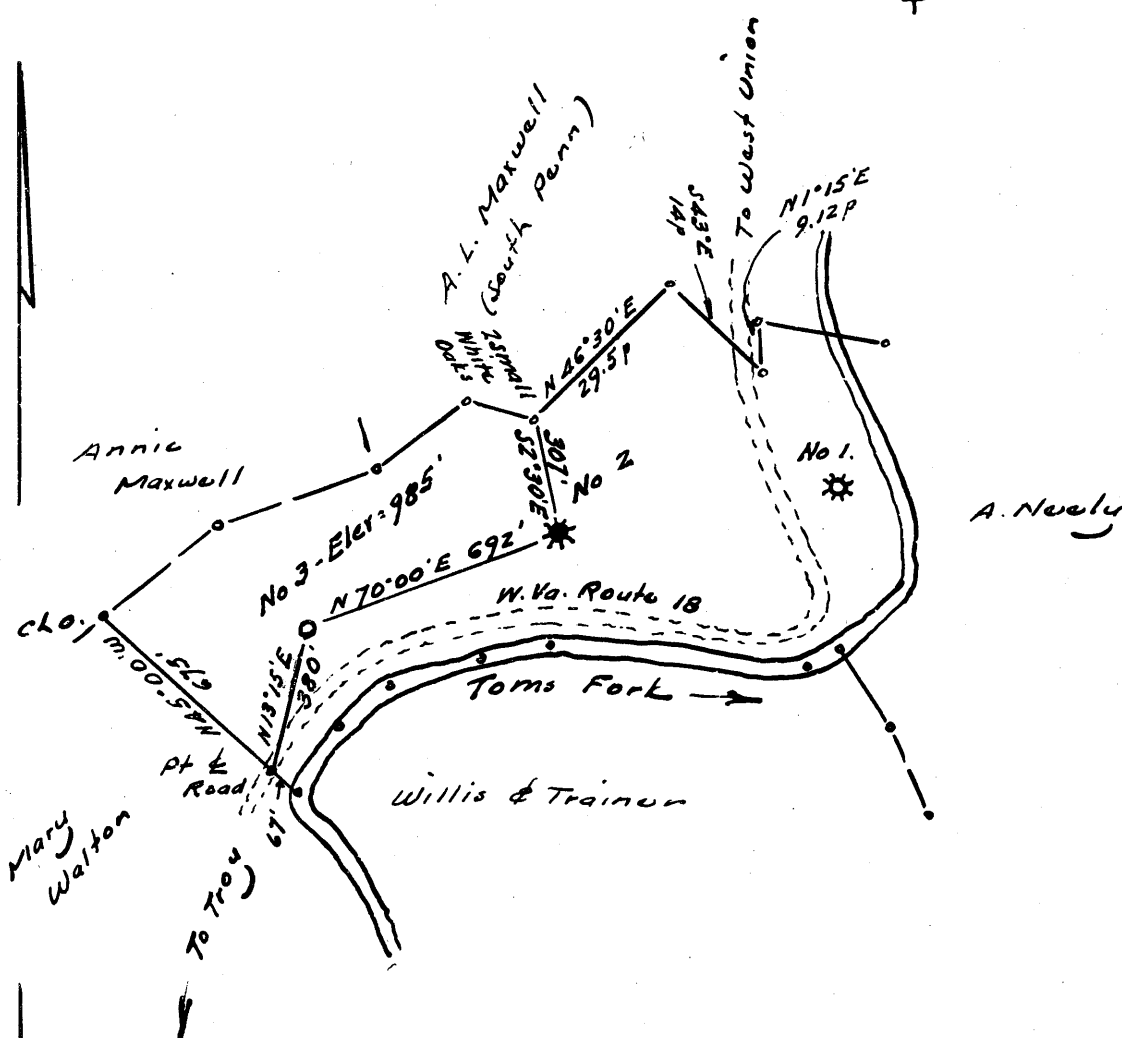

1.975
1.90

- New Location ..
- Drill Deeper
- Abandonment

Company Farrell L. Prior
 Address 700 Union Trust Bldg., Parkersburg
 Farm John Walton
 Tract _____ Acres 50 Lease No. _____
 Well (Farm) No. Three Serial No. _____
 Elevation (Spirit Level) 985
 Quadrangle Kadis NW
 County Doddridge District New Milton
 Engineer W. H. [Signature]
 Engineer's Registration No. 1227
 File No. _____ Drawing No. _____
 Date Feb 1962 Scale 1" = 30 P

STATE OF WEST VIRGINIA
 DEPARTMENT OF MINES
 OIL AND GAS DIVISION
 CHARLESTON

WELL LOCATION MAP
 FILE NO. Dod-716

+ Denotes location of well on United States Topographic Maps, scale 1 to 62,500, latitude and longitude lines being represented by border lines as shown.

- Denotes one inch spaces on border line of original tracing.



STATE OF WEST VIRGINIA
DEPARTMENT OF MINES
OIL AND GAS DIVISION 5

Quadrangle Vadis

Permit No. DOD-716

WELL RECORD

Oil or Gas Well Oil
(KIND)

Company Prior Oil Company
Address 720 Union Trust Bldg. Parkersburg, W. Va.
Farm John Walton Acres 50
Location (waters) Tom's Fork
Well No. Three Elev. 985'
District New Milton County Doddridge
The surface of tract is owned in fee by John Walton
New Milton Address West Virginia
Mineral rights are owned by John Walton
New Milton Address West Virginia
Drilling commenced 3/9/62
Drilling completed 4/10/62
Date Shot _____ From _____ To _____
With _____
Open Flow _____ /10ths Water in _____ Inch
_____ /10ths Merc. in _____ Inch
Volume _____ Cu. Ft.
Rock Pressure Not taken lbs. _____ hrs.
Oil Show _____ bbls., 1st 24 hrs.
WELL ACIDIZED 200 gallons


Casing and Tubing	Used in Drilling	Left in Well	Packers
Size			
16			Kind of Packer
13			
10			Size of
8 1/2 4 1/2		2065'	Depth set
6 5/8			
5 3/16			Perf. top <u>2017'</u>
3			Perf. bottom <u>2019'</u>
2			Perf. top _____
Liners Used			Perf. bottom _____

CASING CEMENTED 4 1/2 SIZE ~~8 1/2~~ No. Ft. 3/29/62 Date
35 sks. cement. LAWSON
COAL WAS ENCOUNTERED AT None FEET _____ INCHES
_____ FEET _____ INCHES FEET _____ INCHES
_____ FEET _____ INCHES FEET _____ INCHES

WELL FRACTURED 600 barrells water 30,000 lbs. sand
RESULT AFTER TREATMENT 40 bbls. oil
ROCK PRESSURE AFTER TREATMENT 645 24 hours
Fresh Water 431' Feet _____ Salt Water _____ Feet _____

Formation	Color	Hard or Soft	Top	Bottom	Oil, Gas or Water	Depth	Remarks
R. Clay			0	18			
Sand			18	30			
Red rock & sand			30	149			
Shale & sand			149	245			
Red rock			245	291			
Sand			291	311			
Sandy shale			311	342			
Red rock			342	356			
Sand & broken sand			356	431			
Red rock			431	437			
Broken sand			437	470			
Sand			470	490			
Shale			490	569			
Sandy shale			569	721			
Slate & shells			721	775			
Red rock			775	790			
Lime			790	830			
Slate & shells			830	940			
Lime			940	950			
Slate			950	980			
Lime			980	1020			
Slate & shells			1020	1063			
Shally sand			1063	1289			
Lime			1289	1303			
Shale			1303	1352			
Lime			1352	1361			
Sandy shale			1361	1502			
Sand			1502	1553			

Fresh water H.F.

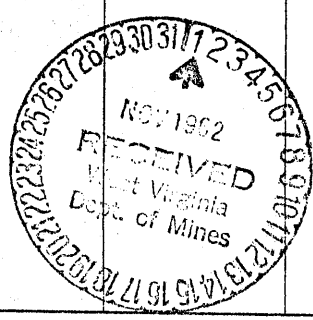

Formation	Color	Hard or Soft	Top ⁵	Bottom	Oil, Gas or Water	Depth Found	Remarks
Sand & shale			1553	1697			
Sand			1697	1725			
Shale			1725	1799			
Lime			1799	1862			
Sandy Lime			1862	1949			
Sand			1949	1957	show oil		
Sand & lime			1957	2010			
Sand S			2010	2025	oil & gas		
Slate			2025	2065	T. D.		

Date 30 May Oct., 19 62

APPROVED Prior Oil Company, Owner

By _____ (Title)