


Latitude 39 ° 15 '

Longitude 80 ° 40 '

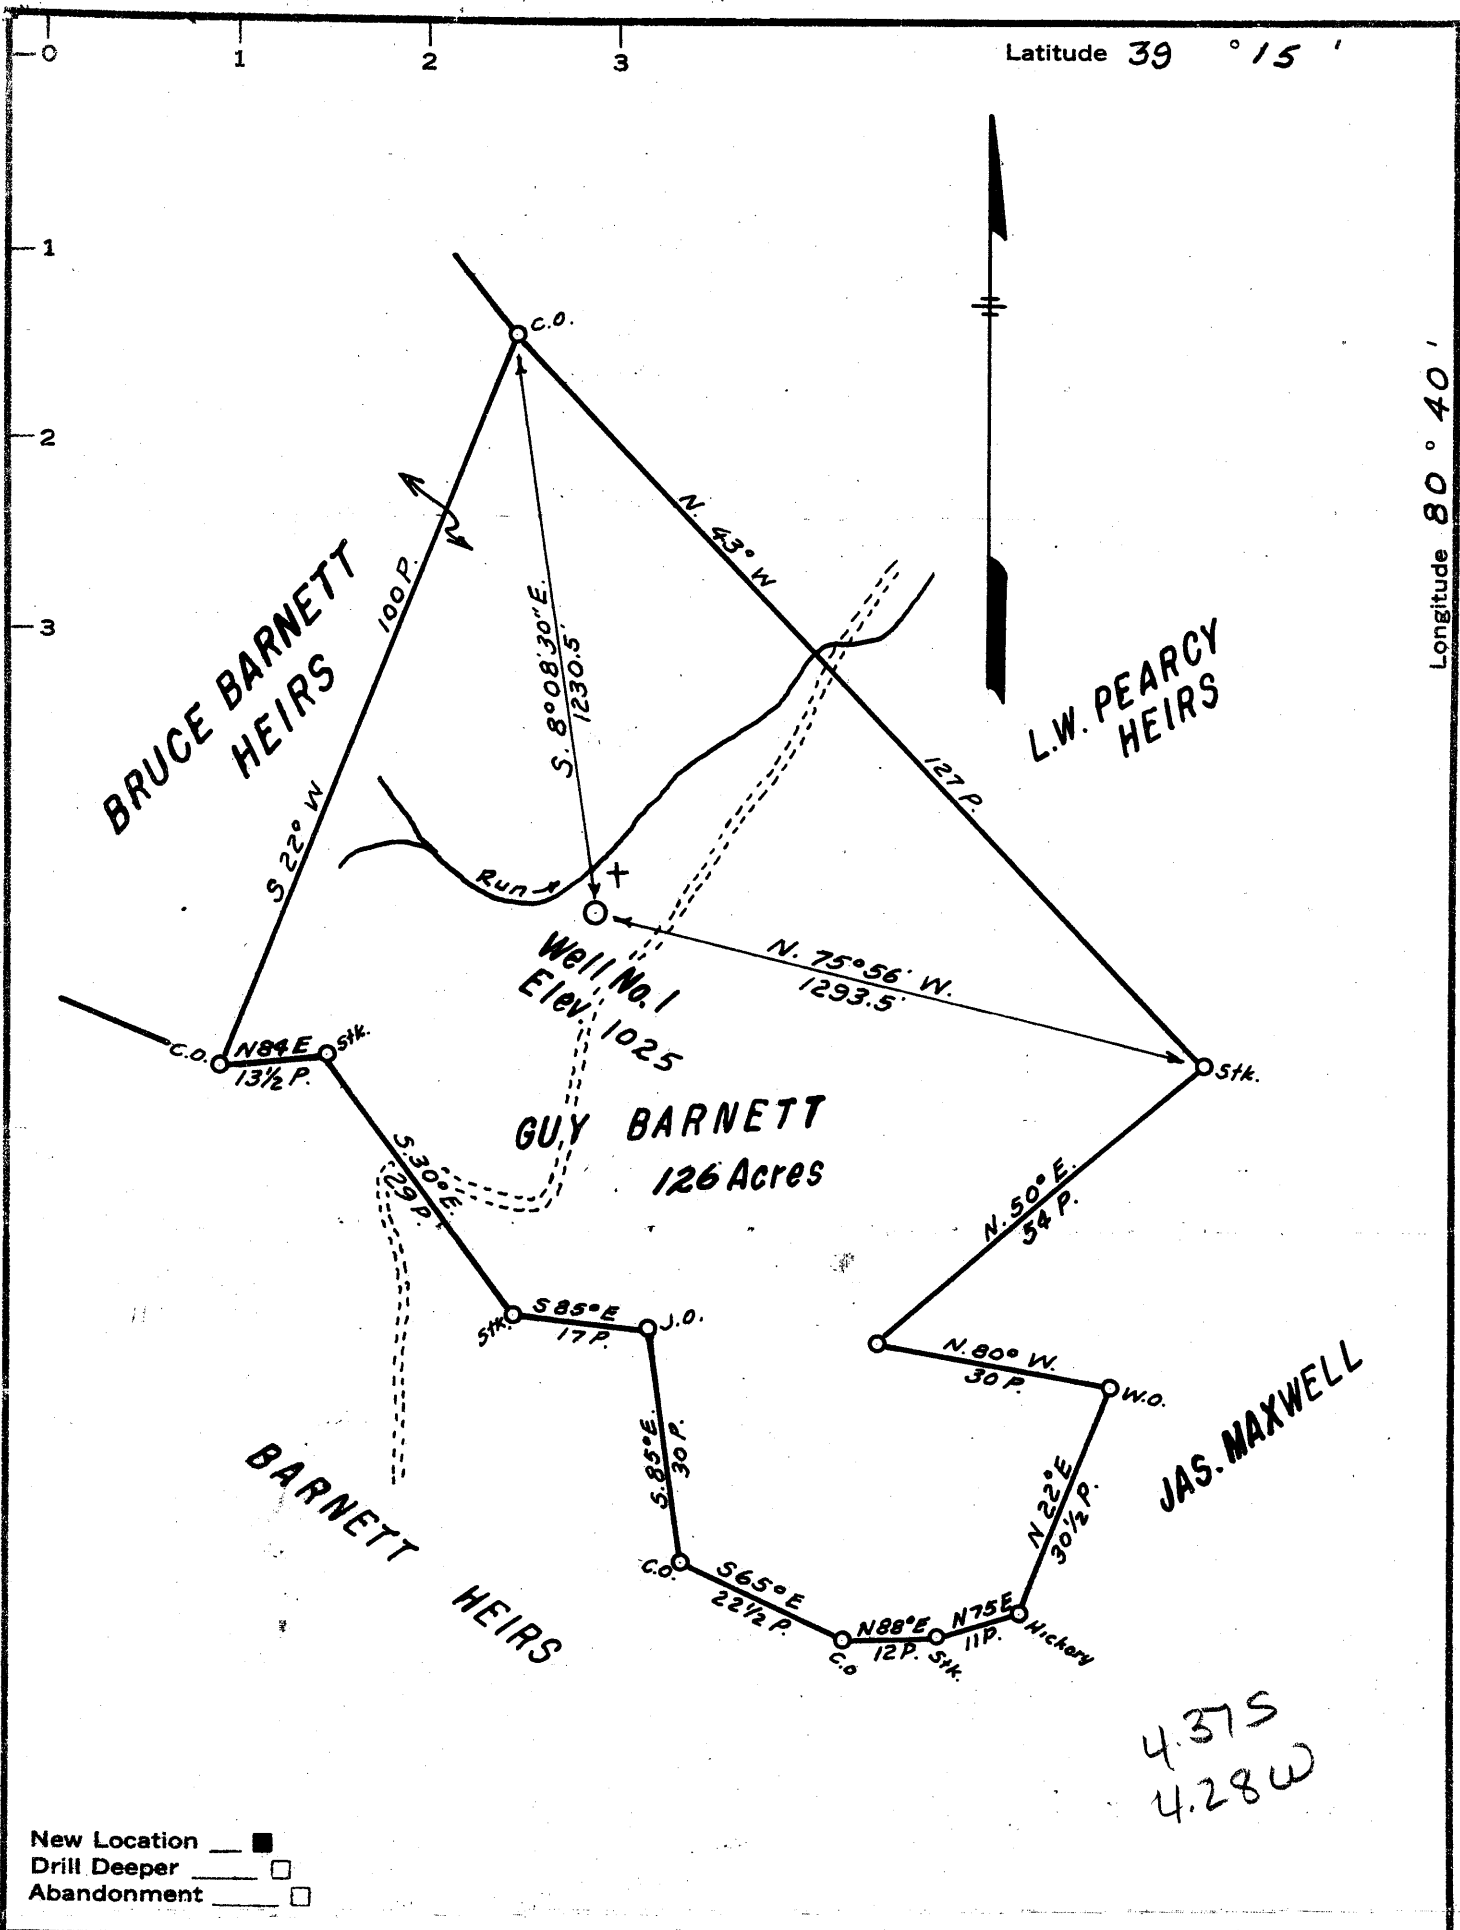

- New Location
- Drill Deeper
- Abandonment

Compan OFFSET DRILLING CO
 Address BOX 1651 PARKERSBURG, WVA
 Farm GUY BARNETT
 Tract _____ Acres 59.25 Lease No. _____
 Well (Farm) No. 1 Serial No. _____
 Elevation (Spirit Level) 1025
 Quadrangle VADIS NW
 County DODDRIDGE District NEW MILTON
 Engineer QC Rall
 Engineer's Registration No. OHIO 27583
 File No. _____ Drawing No. _____
 Date FEB. 17, 1962 Scale 1" = 400'

STATE OF WEST VIRGINIA
 DEPARTMENT OF MINES
 OIL AND GAS DIVISION
 CHARLESTON

WELL LOCATION MAP
 FILE NO. DOD-733

+ Denotes location of well on United States Topographic Maps, scale 1 to 62,500, latitude and longitude lines being represented by border lines as shown.

— Denotes one inch spaces on border line of original tracing.