

New Location   
 Drill Deeper   
 Abandonment

Company TRIO OIL & GAS CO.  
 Address 90 P.B. DAVIS, WEST UNION, W. VA.  
 Farm AMOS E. NICHOLSON (SURF)  
 Tract \_\_\_\_\_ Acres 118 Lease No. \_\_\_\_\_  
 Well (Farm) No. 2 Serial No. \_\_\_\_\_  
 Elevation (Spirit Level) 899' 1000' 1697.5 4000  
 Quadrangle VADIS NW  
 County DODDRIDGE District NEW MILTON  
 Engineer John W. Hamilton  
 Engineer's Registration No. 2274  
 File No. \_\_\_\_\_ Drawing No. \_\_\_\_\_  
 Date MAR. 20, 1962 Scale 1" = 660'

STATE OF WEST VIRGINIA  
 DEPARTMENT OF MINES  
 OIL AND GAS DIVISION  
 CHARLESTON

WELL LOCATION MAP  
 FILE NO. DOD-749

+ Denotes location of well on United States Topographic Maps, scale 1 to 62,500, latitude and longitude lines being represented by border lines as shown.

- Denotes one inch spaces on border line of original tracing.



STATE OF WEST VIRGINIA  
DEPARTMENT OF MINES  
OIL AND GAS DIVISION 9

Quadrangle Vadis

WELL RECORD

Permit No. DOD-749

Oil or Gas Well Dry


(KIND)

Company Trio Oil & Gas Co., Inc.  
 Address West Union, W. Va.  
 Farm Amos E. Nicholson Acres 118  
 Location (waters) Toms Fork 1000' x 1016' Size  
 Well No. 2 Elev. 842 75 496  
 District New Milton County Doddridge 13  
 The surface of tract is owned in fee by G. F. Baker, Hrs. 10  
J. C. Dicks Address Petroluem, W. Va. 8 1/4  
 Mineral rights are owned by \_\_\_\_\_  
 Address \_\_\_\_\_  
 Drilling commenced April 16, 1962  
 Drilling completed May 6, 1962  
 Date Shot \_\_\_\_\_ From \_\_\_\_\_ To \_\_\_\_\_  
 With \_\_\_\_\_  
 Open Flow \_\_\_\_\_ /10ths Water in \_\_\_\_\_ Inch  
 \_\_\_\_\_ /10ths Merc. in \_\_\_\_\_ Inch  
 Volume \_\_\_\_\_ Cu. Ft.  
 Rock Pressure \_\_\_\_\_ lbs. \_\_\_\_\_ hrs.  
 Oil \_\_\_\_\_ bbls., 1st 24 hrs.  
 WELL ACIDIZED \_\_\_\_\_  
 WELL FRACTURED \_\_\_\_\_  
 RESULT AFTER TREATMENT \_\_\_\_\_  
 ROCK PRESSURE AFTER TREATMENT \_\_\_\_\_  
 Fresh Water None Feet \_\_\_\_\_ Salt Water \_\_\_\_\_ Feet 1925, ft.

Casing and Tubing	Used in Drilling	Left in Well	Packers
			Kind of Packer _____
			Size of _____
			Depth set _____
			Perf. top _____
			Perf. bottom _____
			Perf. top _____
			Perf. bottom _____
CASING CEMENTED _____ SIZE _____ No. Ft. _____ Date _____			
COAL WAS ENCOUNTERED AT <u>none</u> FEET _____ INCHES _____			
_____ FEET _____ INCHES _____ FEET _____ INCHES			
_____ FEET _____ INCHES _____ FEET _____ INCHES			

Formation	Color	Hard or Soft	Top	Bottom	Oil, Gas or Water	Depth	Remarks
Soil			0	15			
Slate			15	60			
Red Rock			60	75			
Slate			75	120			
Red Rock			120	210			
Lime & Sand			210	235			
Red Rock			235	300			
Lime			300	315			
Sand			315	335			
Slate			335	345			
Red Rock			345	395			
Sand			395	415			
Slate			415	495			
Sand			495	530			
Lime			530	570			
Slate			570	615			
Sand			615	660			
Slate			660	675			
Red Rock			675	700			
Sand & Lime			700	740			
Red Rock			740	765			
Sand			765	775			
Shale			775	784			
Red Rock			784	795			
Slate			795	820			
Lime & Shell			820	828			
Red Rock			828	845			
Slate & Shells			845	935			
Red Rock			935	975			

(over)

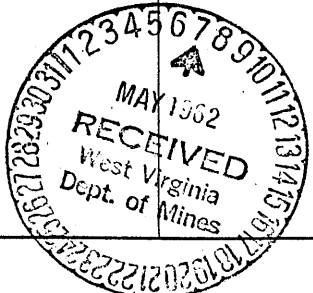

Formation	Color	Hard or Soft	Top <sup>9</sup>	Bottom	Oil, Gas or Water	Depth Found	Remarks
Black Slate			975	1005			
Lime			1005	1055			
Sand			1055	1085			
Shells & Slate			1085	1160			
Lime			1160	1250			
Slate & Shells			1250	1370			
Sand			1370	1455			
Black Slate			1455	1495			
Lime			1495	1520			
Black Slate			1520	1585			
Lime			1585	1630			
Sand			1630	1675			
Black Lime			1675	1698			
Sand			1698	1710			
Black Shale			1710	1765			
Black Lime			1765	1780			
Slate			1780	1830			
Slate & Shells			1830	1880			
L. Lime			- 1880	1894			
Blue Monday			1894	1931			
Big Lime			- 1931	1979			
Kener Sand			1979	2001			
Engin Sand			2001	2060			
Lime			2060	2070			
Slate & Shells			2070	2111			

Date APR 7 1962

APPROVED Tri-Oil & Gas Co., Inc. Owner

By \_\_\_\_\_ (Title)