

New Location   
 Drill Deeper   
 Abandonment

Company **FERRELL L. PRIOR**  
 Address **710 Union Trust Building, Parkersburg, West Va.**  
 Farm **Mary Walton**  
 Tract \_\_\_\_\_ Acres **211.945** Lease No. \_\_\_\_\_  
 Well (Farm) No. **Ten** Serial No. \_\_\_\_\_  
 Elevation (Spirit Level) **935** **1110-116-754200**  
 Quadrangle **Yadis** **NW**  
 County **Doddridge** District **New Milton**  
 Engineer **W. H. Heston**  
 Engineer's Registration No. **1227**  
 File No. \_\_\_\_\_ Drawing No. \_\_\_\_\_  
 Date **April 1962** Scale **1" = 40 P = 660'**

STATE OF WEST VIRGINIA  
 DEPARTMENT OF MINES  
 OIL AND GAS DIVISION  
 CHARLESTON

**WELL LOCATION MAP**  
 FILE NO. **DDP-767**

+ Denotes location of well on United States Topographic Maps, scale 1 to 62,500, latitude and longitude lines being represented by border lines as shown.

- Denotes one inch spaces on border line of original tracing.

P(4)

2.705  
2.711

1018103



STATE OF WEST VIRGINIA  
DEPARTMENT OF MINES  
OIL AND GAS DIVISION 7

Quadrangle Vadis

Permit No. DOD-703 767

WELL RECORD


Oil or Gas Well Oil  
(KIND)

Company Ferrell L. Prior  
 Address 720 Union Trust Bldg. Parkersburg, W. Va.  
 Farm Mary Walton Acres 211.945  
 Location (waters) 1110' klg. Size  
 Well No. 10 Elev. 1032  
 District New Milton County Doddridge  
 The surface of tract is owned in fee by Mary Walton, et als  
New Milton Address W. Va.  
 Mineral rights are owned by Mary Walton, et als  
New Milton Address W. Va.  
 Drilling commenced 5/14/62  
 Drilling completed 5/21/62  
 Date Shot From To  
 With  
 Open Flow /10ths Water in Inch  
 /10ths Merc. in Inch  
 Volume Not taken Cu. Ft.  
 Rock Pressure Not taken lbs. hrs.  
 Oil show bbls., 1st 24 hrs.  
 WELL ACIDIZED 600 gallon  
 WELL FRACTURED 900 bbls. water 40,000 lbs. sand  
Drilled with Rotary - Circulating Gel  
 RESULT AFTER TREATMENT 50 bbls.  
 ROCK PRESSURE AFTER TREATMENT 645 lbs. 24 hrs.  
 Fresh Water Feet Salt Water Feet

Casing and Tubing	Used in Drilling	Left in Well	Packers
Size			Sand Drill
13			Kind of Packer
10			Size of
8 5/8	30'	30'	Depth set
6 5/8			
5 3/16			
3			Perf. top <u>2126'</u>
2			Perf. bottom <u>2134'</u>
Liners Used			Perf. top <u>2142'</u>
			Perf. bottom <u>1984'</u>
			<u>1994'</u>

CASING CEMENTED 4 1/2 SIZE 2190' No. Ft. 5/21/62 Date  
9 Sacks Cement by Lawson Oil & Gas Well Cem. Co  
 COAL WAS ENCOUNTERED AT None FEET INCHES  
 FEET INCHES FEET INCHES  
 FEET INCHES FEET INCHES

Formation	Color	Hard or Soft	Top	Bottom	Oil, Gas or Water	Depth	Remarks
Clay			0	32			
Sand rock			32	64			
Sand			64	89			
Sand & shale			89	132			
Shale			132	425			
Shaley Sand			425	605			
Sand & shale			605	760			
Shale			760	795			
Shaley sand			795	855			
Sand & shale			855	1045			
Shale			1045	1130			
Shaley sand			1130	1325			

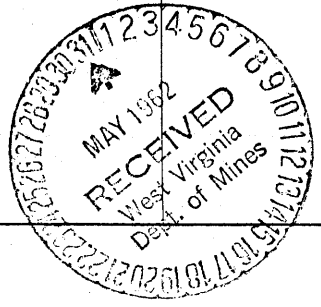

Formation	Color	Hard or Soft	Top 7	Bottom	Oil, Gas or Water	Depth Found	Remarks
Sand			1325	1345			
Sandy shale			1345	1474			
Sand			1475	1570			
Sand & shale			1570	1760			
Shaley sand			1760	1916			
Lime			1916	1919			
Shaley sand			1919	1925			
Shaley sand & lime			1925	1932			
Shaley sand			1932	1949			
Little Lime			1949	1952			
Shaley sand			1952	1977			
Sandy lime			1977	1983			
Hard sand			1983	2002			
Sandy lime			2002	2072			
Shaley shale			2072	2095			
Sandy lime			2095	2109			
Sand			2109	2160			
Sand & shale			2160	2192			
Shale			2192	2200	T. D.		

Date May 28, 1962

APPROVED \_\_\_\_\_, Owner

By \_\_\_\_\_  
(Title)