


Latitude 39° 15'

Longitude 80° 40'

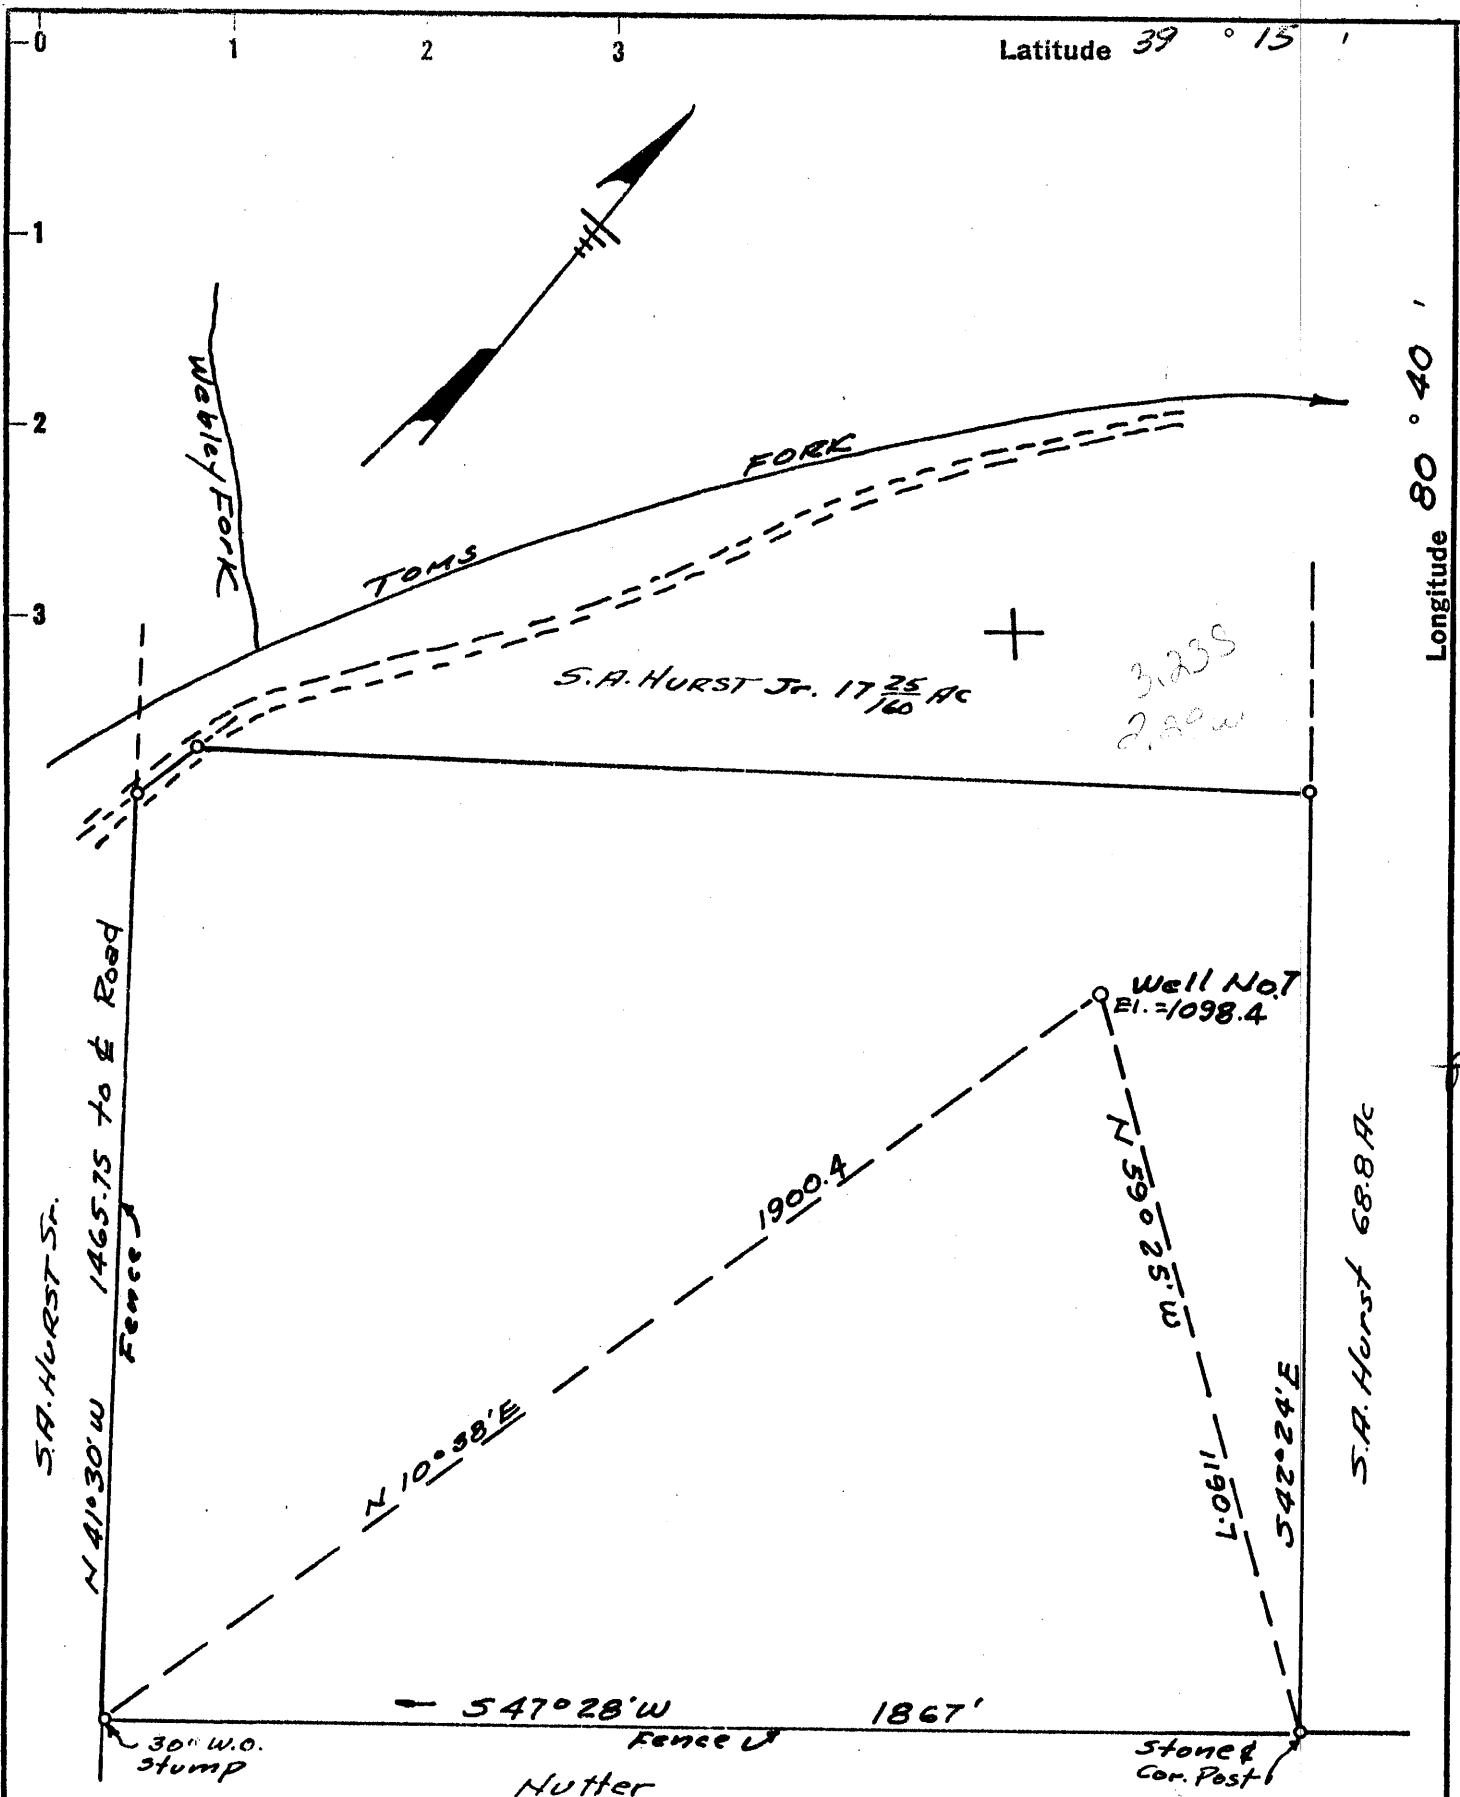

New Location   
 Drill Deeper   
 Abandonment

Company DEVONIAN GAS & OIL CO.  
 Address 2003-COMMON WEALTH BLDG. PITTSBURG, 22 PA.  
 Farm S.A. HURST Jr.  
 Tract \_\_\_\_\_ Acres 69 Lease No. \_\_\_\_\_  
 Well (Farm) No. 7 Serial No. \_\_\_\_\_  
 Elevation (Spirit Level) 1098.4  
 Quadrangle VADIS NW  
 County Doddridge District New Milton  
 Engineer H. S. Johnston  
 Engineer's Registration No. 2492  
 File No. \_\_\_\_\_ Drawing No. \_\_\_\_\_  
 Date MAY 4, 1962 Scale 1" = 300'

STATE OF WEST VIRGINIA  
 DEPARTMENT OF MINES  
 OIL AND GAS DIVISION  
 CHARLESTON

**WELL LOCATION MAP**  
 FILE NO. DOD-786

+ Denotes location of well on United States Topographic Maps, scale 1 to 62,500, latitude and longitude lines being represented by border lines as shown.

- Denotes one inch spaces on border line of original tracing.

# DRILLER'S RECORD

Previously Requested, but NOT  
AVAILABLE

DATE: \_\_\_\_\_

017  
COUNTY

786  
PERMIT

ID: COUNTY: 017 (DODDRIDGE) PERMIT: 786 SFX: 0 (New Location)

REASSIGNED ID #: ()

COMPLETION INFO: ELEVATION: 1098 COMP REC FLAG: (not@DOE/DGIS)  
ELEVATION TYPE: G RIG TYPE: 0  
(Ground Lvl) (unknown)

\* LOCATION TAX DST: 6 (New Milton)  
\* INFO: DEGREES MINUTES MILES  
\* 7.5' LATITUDE: 00 00.0 0.00S  
\* LONGITUDE: 00 00.0 0.00W  
\* QUADRANGLE: (?)  
\* 15' LATITUDE: 39 15 3.23S  
\* LONGITUDE: 80 40 2.29W  
\* QUADRANGLE: 123 (Vadis)  
\* 5' SECT: 1 (Northwest)

CLASSIFICATION: DATES: MM/DD/YYYY  
INITIAL: (unclassified) SFUD: / / WELL TYPE:  
FINAL: (unclassified) COMP: / / (  
FIELD: 000 BATCH: / / CMPL METH: 0  
(Unnamed) YEAR RPTD: (unknown)

OPEN GAS-BEFORE TREATMENT: (MCFPD) OIL-BEFORE TREATMENT: (BOPD)  
FLOW: GAS-AFTER TREATMENT: (MCFPD) OIL-AFTER TREATMENT: (BOPD)

UTM: EASTING: 525088.5 NORTHING: 4339142.0  
COORDINATE DIGITIZED (Y/N): N

ROCK NATURAL (PSI): 0 TIME (NATURAL, IN HOURS): 0  
PRESSURE: TREATED (PSI): 0 TIME (TREATED, IN HOURS): 0

\* OWNER STATUS: C (Cmplt) DATE: / /  
\* INFO: SURFACE OWNER: Stokes A Hurst Jr 7  
\* OIL&GAS OWNER:  
\* COMPANY NUMBER:  
\* OPERATOR: 3706 (Devonian G&O)  
\*

DEPTHS: TOTAL FTG: 0 NEW FTG: 0 EXPL FTG: 0

DEEPEST FM: AT TOTAL DEPTH: 000 TESTED:  
( ) ( )

MECHANICAL LOG INFO:

STATUS: RANGE OF INTERVALS: 0- 2189 DEEPEST FM LOGGED:  
LOGS AVAILABLE: GR,N,D,\* MICROFILM ROLL NUMBER(S): 11  
COMMENT:

LOG TYPES: GR-gamma ray; D-density; T-temperature; I-induction; N-neutron; S-sonic, \*Other types not noted