

New Location    
 Drill Deeper    
 Abandonment

Company Southwestern Development Co.   
 Address Union Trust Bldg. Parkersburg, W.Va.   
 Farm C.L. Percy   
 Tract \_\_\_\_\_ Acres 107± Lease No. \_\_\_\_\_   
 Well (Farm) No. 1- Serial No. \_\_\_\_\_   
 Elevation (Spirit Level) 833.0   
 Quadrangle Vadis NW   
 County Doddridge District New Milton   
 Engineer H.F. Johnston   
R.L. Marshall - S.O.R.   
 Engineer's Registration No. 2492   
 Drawing No. \_\_\_\_\_   
 Date May 25 1962 Scale 1" = 400

STATE OF WEST VIRGINIA   
 DEPARTMENT OF MINES   
 OIL AND GAS DIVISION   
 CHARLESTON   
**WELL LOCATION MAP**   
 FILE NO. DOD-802   
 + Denotes location of well on United States Topographic Maps, scale 1 to 62,500, latitude and longitude lines being represented by border lines as shown.   
 - Denotes one inch spaces on border line of original tracing.

6-0 144



STATE OF WEST VIRGINIA  
DEPARTMENT OF MINES  
OIL AND GAS DIVISION 8

Quadrangle New Milton

WELL RECORD

Permit No. DOD 802

Oil or Gas Well Dry  
(KIND)

Company <u>Southwestern Development Company</u>	Casing and Tubing	Used in Drilling	Left in Well	Packers
Address <u>314 Union Trust Bldg., Parkersburg, W.Va.</u>	Size			
Farm <u>Pearcy</u> Acres <u>106</u>	16	20'		Kind of Packer
Location (waters) <u>Meathouse Fork</u>	13			
Well No. <u>One</u> Elev. <u>833</u>	10	342'		Size of
District <u>New Milton</u> County <u>Doddridge</u>	8 1/4	987'		Depth set
The surface of tract is owned in fee by <u>Bland Heirs</u>	6 3/8			
Address <u>West Union, W.Va.</u>	5 3/16			Perf. top
Mineral rights are owned by <u>Cox-Pearcy, et al.</u>	3			Perf. bottom
Address <u>West Union, W.Va.</u>	2			Perf. top
Drilling commenced <u>6/2/62</u>	Liners Used			Perf. bottom
Drilling completed <u>7/12/62</u>				
Date Shot From To				
With				
Open Flow /10ths Water in Inch				
/10ths Merc. in Inch				
Volume Cu. Ft.				
Rock Pressure lbs. hrs.				
Oil bbls., 1st 24 hrs.				
WELL ACIDIZED				
WELL FRACTURED				

CASING CEMENTED SIZE No. Ft. Date


COAL WAS ENCOUNTERED AT 494 FEET INCHES  
FEET INCHES FEET INCHES  
FEET INCHES FEET INCHES

RESULT AFTER TREATMENT

ROCK PRESSURE AFTER TREATMENT

Fresh Water 36' Feet Salt Water 1854-1860 Feet

Formation	Color	Hard or Soft	Top	Bottom	Oil, Gas or Water	Depth	Remarks
Surface Soil			0	27			
Red Rock			27	70			
Slate Shells			70	83			
Red Rock			83	98			
Red Rock			98	100			
Slate Shells			100	112			
Red Rock			112	133			
Slate Shells			133	150			
Red Rock			150	170			
Slate Shells			170	205			
Red Rock			205	225			
Sand			225	228			
Slate Shells			228	230			
Sand			230	240			
Lime			240	252			
Slate Shells			252	265			
Sand			265	272			
Red Rock			272	315			
Slate Shells			315	335			
Lime			335	344			
Sand			344	366			
Slate Shells			366	390			
Red Rock			390	396			
Lime			396	420			
Slate Shells			420	494			
Coal			494	499			
Slate Shells			499	590			
Red Rock			590	622			
Lime			622	635			

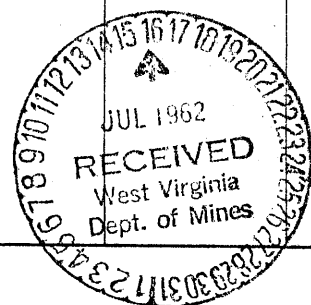

(over)

Formation	Color	Hard or Soft	Top <i>f</i>	Bottom	Oil, Gas or Water	Depth Found	Remarks
Sand			635	652			
Red Rock			652	708			
Slate Shells			708	745			
Red Rock			745	758			
Lime			758	777			
Slate Shells			777	792			
Slate			792	806			
Slate Shells			806	908			
White Slate			908	928			
Pink Rock			928	940			
Sand			940	970			
Slate			970	992			
Lime			992	1006			
Sand			1006	1040			
Slate Shells			1040	1060			
Sand			1060	1085			
Slate Shells			1085	1180			
Slate			1180	1210			
Slate Shells			1210	1230			
Sand			1230	1250			
Slate			1250	1255			
Sand			1255	1365	smell oil	1255-1260	
Slate			1365	1380			
Sand			1380	1410			
Slate			1410	1415			
Sand			1415	1444			
Broken Sand			1444	1491			
Slate Shells			1491	1528			
Sand			1528	1598			
Slate Shells			1598	1647			
Slate			1647	1680			
Slate Shells			1680	1698			
Sand			1698	1714			
Slate Shells			1714	1742			
Red Rock			1742	1756			
Sand			1756	1762			
Slate Shells			1762	1775			
Lime 1775			1775	1775			
Slate			1775	1795			
Sand			1800	1860			
Lime			1860	1893	water	1/2 blr/hr	
sand			1893	1970	show oil	1894-99	
Slate Shells			1970	2094			
Sand			2094	2135			
Slate Shells			2135	2145			
Sand			2145	2195			
Slate Shells			2195	2310			
Sand			2310	2330			
Slate Shells			2330	2520			
Broken Sand			2520	2530			
Slate Shells			2530	2638	TD		

*This log is probably entirely unreliable  
- lithology all wrong  
OKH*

Date 6-12-62, 19

APPROVED Southwestern Development Co., Owner

By Wesley L. Prather  
(Title) Div. Mgr.