

New Location ..    
 Drill Deeper .....    
 Abandonment.....

Company DOCO FIVE OIL & GAS CO. 1006  
 Address c/o J.W. Scott, 144 Valley Street, Salem, West Va.  
 Farm Early L. & Della Cain  
 Tract \_\_\_\_\_ Acres 37.5 Lease No. \_\_\_\_\_  
 Well (Farm) No. Two Serial No. \_\_\_\_\_  
 Elevation (Spirit Level) 1094'  
 Quadrangle Centerpoint SC  
 County Doddridge District Grant  
 Engineer W. H. Hester  
 Engineer's Registration No. 1227  
 File No. \_\_\_\_\_ Drawing No. \_\_\_\_\_  
 Date June 25, 1962 Scale 1" = 200' = 330'

STATE OF WEST VIRGINIA  
 DEPARTMENT OF MINES  
 OIL AND GAS DIVISION  
 CHARLESTON  
**WELL LOCATION MAP**  
 FILE NO. DOD-824

+ Denotes location of well on United States Topographic Maps, scale 1 to 62,500, latitude and longitude lines being represented by border lines as shown.  
 - Denotes one inch spaces on border line of original tracing.



STATE OF WEST VIRGINIA  
DEPARTMENT OF MINES  
OIL AND GAS DIVISION **3**

Quadrangle Centerpoint

Permit No. DOD-824

### WELL RECORD

Oil or Gas Well Gas  
(KIND)

Company Doco Five Oil & Gas Company  
 Address 144 Valley St., Salem, W. Va.  
 Farm Early L. & Della Cain Acres 37.5  
 Location (waters) Buckeye run  
 Well No. 2 Elev. 1094'  
 District Grant County Doddridge  
 The surface of tract is owned in fee by Early L. & Della Cain, Salem, Address West Virginia  
 Mineral rights are owned by Same Address 8-10-62  
 Drilling commenced 8-10-62  
 Drilling completed 9-16-62  
 Date Shot \_\_\_\_\_ From \_\_\_\_\_ To \_\_\_\_\_  
 With \_\_\_\_\_  
 Open Flow \_\_\_\_\_ /10ths Water in \_\_\_\_\_ Inch  
 \_\_\_\_\_ /10ths Merc. in \_\_\_\_\_ Inch  
 Volume \_\_\_\_\_ Cu. Ft.  
 Rock Pressure \_\_\_\_\_ lbs. \_\_\_\_\_ hrs.  
 Oil \_\_\_\_\_ bbls., 1st 24 hrs.  
 WELL ACIDIZED \_\_\_\_\_

Casing and Tubing	Used in Drilling	Left in Well	Packers
Size	✓	✓	Kind of Packer _____
16			Size of _____
13			Depth set _____
10	385'	Pulled	Perf. top _____
8%		1258'	Perf. bottom _____
x 8% 7"		2050'	Perf. top _____
5 3/16			Perf. bottom _____
3			
2			
Liners Used		29' conductor	

CASING CEMENTED \_\_\_\_\_ SIZE \_\_\_\_\_ No. Ft. \_\_\_\_\_ Date \_\_\_\_\_

COAL WAS ENCOUNTERED AT \_\_\_\_\_ FEET \_\_\_\_\_ INCHES  
 \_\_\_\_\_ FEET \_\_\_\_\_ INCHES \_\_\_\_\_ FEET \_\_\_\_\_ INCHES  
 \_\_\_\_\_ FEET \_\_\_\_\_ INCHES \_\_\_\_\_ FEET \_\_\_\_\_ INCHES

WELL FRACTURED  No

RESULT AFTER TREATMENT  2,000,000

ROCK PRESSURE AFTER TREATMENT 350# 32 hours


Fresh Water none Feet \_\_\_\_\_ Salt Water none Feet \_\_\_\_\_

Formation	Color	Hard or Soft	Top	Bottom	Oil, Gas or Water	Depth	Remarks

(37)  
 Early L. Cain Well Number 2, sand log  
 Doco Five Oil and Gas Company

Permit #DOD-824  
 Completed: September 16, 1962

Formation	Top	Bottom	Formation	Top	Bottom
Sand Soil	19	25	Sand	1030	1065
Slate	25	30	Slate and shells	1065	1078
Slate (Black)	30	40	Redrock	1078	1092
Red rock	40	52	Slate and shells	1092	1160
Slate and shells	52	68	Sand	1160	1170
Sand	68	106	Slate and shells	1170	1180
Slate (Black)	106	115	Slate (Black)	1180	1210
Sand	115	130	Lime	1210	1238
Slate and Shells	130	145	Sand	1238	1295
Sand	145	168	Slate (Black)	1295	1305
Slate and Shells	168	240	Dark lime	1305	1320
Redrock	240	250	Slate and shells	1320	1370
Slate and Shells	250	297	Sand	1370	1433
Redrock and shells	297	318	Slate (Black)	1433	1465
Gritty lime	318	325	Sand	1465	1480
Sand	325	357	Slate and shells	1480	1510
Slate and shells	357	462	Gritty lime	1510	1525
Redrock and lime shells	462	485	Black slate and shells	1525	1545
Slate and shells	485	500	Sand	1545	1560
Lime (Red)	500	514	Dark gritty lime	1560	1570
Slate and shells	514	532	Sand	1570	1576
Lime	532	556	Lime (Hard)	1576	1608
Lime shells	556	620	Sand	1608	1645
Slate and shells	620	665	Slate	1645	1660
Lime	665	710	Lime	1660	1710
Slate	710	715	Sand	1710	1818
Coal	715	721	Dark lime	1818	1835
Slate (Black)	721	730	Sand	1835	1853
Slate (Grey)	730	755	Slate	1853	1857
Slate and shells	755	759	Dark lime	1857	1867
Sand	759	778	Black slate	1867	1896
Slate	778	788	Slate and shells	1896	1915
Lime	788	850	Maxon	1915	1925
Redrock	850	855	Gritty lime	1925	1933
Slate	855	860	Broken lime	1933	1950
Sand	860	875	Red lime	1950	1975
Lime (Dark)	875	885	Lime (Hard)	1975	2004
Slate (Grey)	885	911	Black slate shells	2004	2018
Lime	911	922	Hard lime	2018	2031
Pink rock	922	926	Cave	2031	2033
Lime	926	938	Lime	2033	2078
Lime (Grey)	938	955	Sand	2078	2131
Slate and shells	955	995			
Lime (Grey)	995	1018			
Slate and shells	1018	1030			

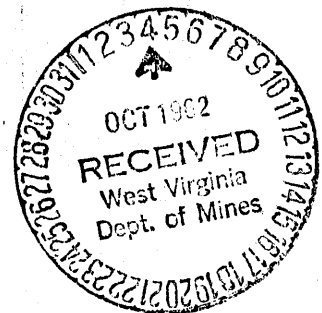

Date....., 19.....

APPROVED....., Owner

By.....  
 (Title)