

New Location ..
 Drill Deeper
 Abandonment

Company EDWARD LEE DOLLEY
 Address 364 E. Vernas St. Farmington, Ill.
 Farm H. C. Chapman
 Tract _____ Acres 120.25 Lease No. _____
 Well (Farm) No. one Serial No. _____
 Elevation (Spirit Level) 1068
 Quadrangle Holbrook EC
 County Doddridge District Cow
 Engineer W. H. [Signature]
 Engineer's Registration No. 1227
 File No. _____ Drawing No. _____
 Date July 8, 1962 Scale 1" = 300' = 495'

STATE OF WEST VIRGINIA
 DEPARTMENT OF MINES
 OIL AND GAS DIVISION
 CHARLESTON

WELL LOCATION MAP
 FILE NO. DOD-835

+ Denotes location of well on United States Topographic Maps, scale 1 to 62,500, latitude and longitude lines being represented by border lines as shown.

- Denotes one inch spaces on border line of original tracing.

6-6-35



STATE OF WEST VIRGINIA
DEPARTMENT OF MINES
OIL AND GAS DIVISION

Quadrangle HOLBROOK L-19

Permit No. DOD-835

ROTARY

WELL RECORD

Oil or Gas Well Oil (KIND)

Company Edward Lee Dolly
 Address 354 E. Vernon, Farmington, Illinois
 Farm H. C. Chapman Acres 120.25
 Location (waters) Middle Fork of Hughes River
 Well No. One Elev. 1068
 District Cove County Doddridge
 The surface of tract is owned in fee by Roy Ruppert
Cove Address West Virginia
 Mineral rights are owned by H. C. Chapman Heirs and
Deco VanHorn Heirs Address West Union, W. Va.
 Drilling commenced 7-12-62
 Drilling completed 7-23-62
 Date Shot From To
 With
 Open Flow /10ths Water in Inch
 /10ths Merc. in Inch
 Volume Cu. Ft.
 Rock Pressure Not taken lbs. hrs.
 Oil Show bbls., 1st 24 hrs.
 WELL ACIDIZED 250 gal.
 WELL FRACTURED 250 Bbls. oil

Casing and Tubing	Used in Drilling	Left in Well	Packers
Size			Kind of Packer
16			
13			
10			Size of
8 5/8"	130'	130'	
6 3/4"		2076	Depth set
3			Perf. top
2			Perf. bottom
Liners Used			Perf. top 1974
			Perf. bottom 1976

CASING CEMENTED 4 1/2" SIZE 2076 No. Ft. 7-24-62 Date
75 sks. cement, LAWSON

COAL WAS ENCOUNTERED AT FEET INCHES
 FEET INCHES FEET INCHES
None FEET INCHES FEET INCHES


RESULT AFTER TREATMENT 300,000 & 5 bbls. of oil

ROCK PRESSURE AFTER TREATMENT Not taken

Fresh Water 38' and 139' Feet Salt Water none Feet

Formation	Color	Hard or Soft	Top	Bottom	Oil, Gas or Water	Depth	Remarks
Surface			0	14			
Red Rock			14	26			
Sand			26	37			
Sand & Shale			37	68			
Shale			68	79			
Sandy-Shale			79	93			
Sand			93	121			
Sand & Shale			121	142			
Sand			142	153			
Red Rock			153	169			
Shale			169	213			
Sand & Shale			213	415			
Sand			415	439			
Red Rock			439	792			
Sandy Lime			792	813			

(over)

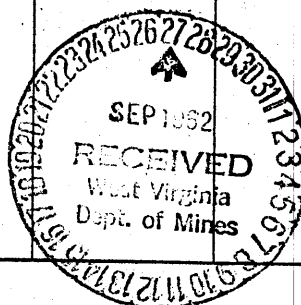

Formation	Color	Hard or Soft	Top δ	Bottom	Oil, Gas or Water	Depth Found	Remarks
Lime			813	869			
Red Rock			869	902			
Sandy Shale			902	972			
Red Rock			972	1072			
Sand			1072	1078			
Shale			1078	1117			
Sandy Lime			1117	1186			
Shale & Sand			1186	1213			
Sandy Shale			1213	1342			
Sandy Lime			1342	1362			
Black Shale			1362	1419			
Sand & Shells			1419	1476			
Sandy Shale			1476	1513			
Sandy Lime			1513	1587			
Sand			1587	1619			
Sandy Shale			1619	1747			
Shale			1747	1805			
Sandy Lime			1805	1870			
Sand & Lime			1870	1941			
Sand			1941	2024	Oil, & Gas		
Shale			2024	2084	T.D.		

Date Sept. 24th, 1962

APPROVED Edward Lee Dally, Owner

By _____ (Title)