


M

Latitude 39° + 15'

Longitude 80° 40'

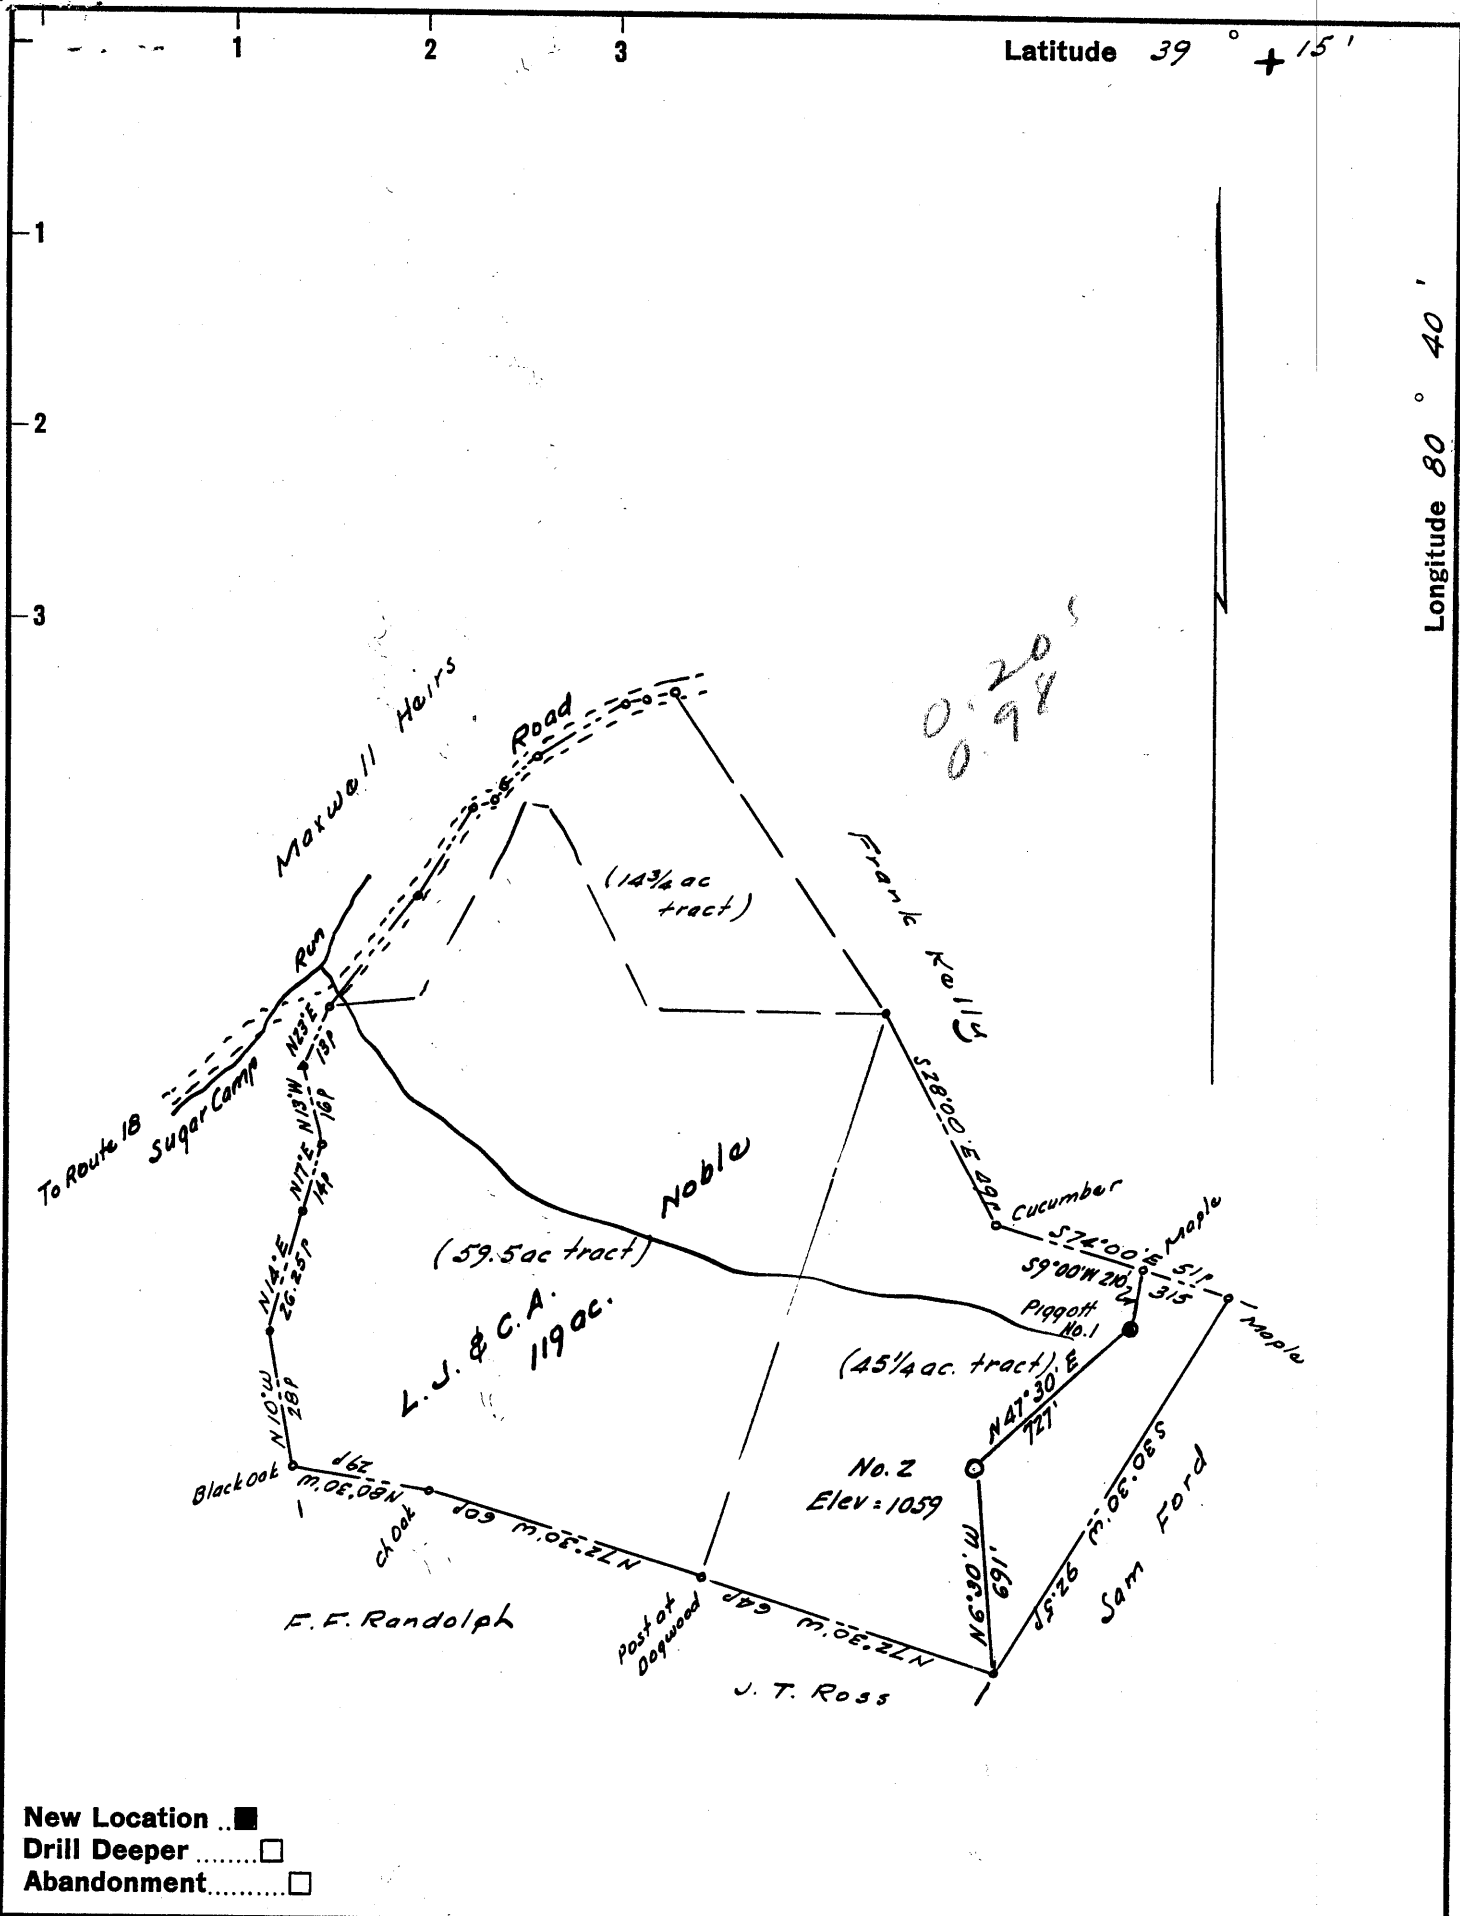

New Location ..
 Drill Deeper
 Abandonment.....

Company G. E. Travis
 Address West Union, West Va.
 Farm L. J. & C. A. Noble
 Tract _____ Acres 119 Lease No. _____
 Well (Farm) No. Two Serial No. _____
 Elevation (Spirit Level) _____
 Quadrangle Vadis NW
 County Doddridge District New Milton
 Engineer W. H. [Signature]
 Engineer's Registration No. 1227
 File No. _____ Drawing No. _____
 Date August 15, 1962 Scale 1" = 40 p = 660'

STATE OF WEST VIRGINIA
 DEPARTMENT OF MINES
 OIL AND GAS DIVISION
 CHARLESTON

WELL LOCATION MAP
 FILE NO. Dod-856

+ Denotes location of well on United States Topographic Maps, scale 1 to 62,500, latitude and longitude lines being represented by border lines as shown.

- Denotes one inch spaces on border line of original tracing.

20 194

Formation	Color	Hard or Soft	Top 5	Bottom	Oil, Gas or Water	Depth Found	Remarks
Lime	G	H	633	656			
R-Rock	R	S	656	670			
Sand		H	670	700			
R-Rock	R	S	700	750			
Lime	G	H	750	765			
R-Rock	R	S	765	790			
Lime	G	H	790	845			
Slate	G	S	845	860			
R-Rock	R	S	860	882			
Lime	G	H	882	930			
Slate	G	S	930	945			
R-Rock	R	S	945	930			
Lime	G	H	930	997			
Slate	G	H	997	1007			
Lime	G	H	1007	1030			
Slate	G	H	1030	1040			
Sand		H	1040	1055			
Slate	G	S	1055	1063			
Lime	G	H	1063	1077			
Sand		H	1077	1104			
Lime	G	H	1104	1183			
Slate & Shells		H	1183	1206			
Sand		H	1206	1246			
Slate & Shells		H	1246	1285			
Sand		H	1285	1334			
Slate & Shells		H	1334	1364			
Sand		H	1364	1425			
Slate	G	S	1425	1445			
Sand		H	1445	1496			
Lime	G	H	1496	1520			
Slate & Shells		H	1520	1562			
Sand		H	1562	1653			
Slate & Shells		H	1653	1689			
Lime	G	H	1689	1730			
Slate & Shells		H	1730	1800			
Lime	G	H	1800	1819			
R-Rock	R	S	1819	1827			
Slate & Shells		H	1827	1838			
Lime	G	H	1838	1850			
Slate	G	S	1850	1860			
Lime	Blue	H	1860	1885			
Lime	Big	H	1885	1929			
Sand		H	1929	2010	Gas	1929 to 1937	

Date _____, 19____

APPROVED _____, Owner

By _____ (Title)