

Latitude 39 ° 20 '

Longitude 80 ° 50 '

- New Location ..
- Drill Deeper .....
- Abandonment .....

Company Petroleum Promotions  
 Address 212 Nelson Bldg. Charleston, W. Va.  
 Farm G. B. Davis  
 Tract \_\_\_\_\_ Acres 65 Lease No. \_\_\_\_\_  
 Well (Farm) No. One Serial No. \_\_\_\_\_  
 Elevation (Spirit Level) 1087  
 Quadrangle West Union SC  
 County Doddridge District Central  
 Engineer W. H. Harts  
 Engineer's Registration No. 1227  
 File No. \_\_\_\_\_ Drawing No. \_\_\_\_\_  
 Date August 28, 1962 Scale 1" = 300' = 495'

STATE OF WEST VIRGINIA  
 DEPARTMENT OF MINES  
 OIL AND GAS DIVISION  
 CHARLESTON

WELL LOCATION MAP  
 FILE NO. Dod-859

+ Denotes location of well on United States Topographic Maps, scale 1 to 62,500, latitude and longitude lines being represented by border lines as shown.

- Denotes one inch spaces on border line of original tracing.

4225  
076

6-6 79



STATE OF WEST VIRGINIA  
DEPARTMENT OF MINES  
OIL AND GAS DIVISION 6

Quadrangle West Union

Permit No. DOD 859

WELL RECORD

Oil or Gas Well Oil

Company Petroleum Promotions, Inc.  
Address 1154 Cora Drive Flint, Michigan  
Farm G.B. Davis Acres. 65  
Location (waters) Wilhelm Run  
Well No. 1- Elev. 1087  
District Central County Doddridge  
The surface of tract is owned in fee by Thomas Hyatt  
Address West Union, W.Va.  
Mineral rights are owned by Same  
Address \_\_\_\_\_  
Drilling commenced September 10, 1962  
Drilling completed October 17, 1962  
Date Shot \_\_\_\_\_ From \_\_\_\_\_ To \_\_\_\_\_  
With \_\_\_\_\_  
Open Flow /10ths Water in \_\_\_\_\_ Inch  
/10ths Merc. in \_\_\_\_\_ Inch  
Volume Show of Gas and Oil Cu. Ft.  
Rock Pressure \_\_\_\_\_ lbs. hrs.  
Oil 20 bbls., 1st 24 hrs.  
WELL ACIDIZED \_\_\_\_\_

Casing and Tubing	Used in Drilling	Left in Well	Packers
Size			Kind of Packer
16			
13	23'	23'	
10	700'	Out	Size of
8 1/4			
6 5/8	1606'	441'	Depth set
<del>5 7/8</del> 4 1/2	2216'	2216'	
3			Perf. top
2			Perf. bottom
Liners Used			Perf. top
			Perf. bottom

CASING CEMENTED 4 1/2 SIZE 2216 No. Ft. 10/17/62 Date  
The Western Co. 50 sks Cement, 10 sks Gel

COAL WAS ENCOUNTERED AT \_\_\_\_\_ FEET \_\_\_\_\_ INCHES  
\_\_\_\_\_ FEET \_\_\_\_\_ INCHES FEET \_\_\_\_\_ INCHES  
\_\_\_\_\_ FEET \_\_\_\_\_ INCHES FEET \_\_\_\_\_ INCHES


WELL FRACTURED Two Pumpers, 20,000 gals. conditioned water, 21,188 lbs. sand  
21,500 lbs. Sand

RESULT AFTER TREATMENT

ROCK PRESSURE AFTER TREATMENT 575 psi. 24 hrs. 150 mcf

Fresh Water \_\_\_\_\_ Feet Salt Water \_\_\_\_\_ Feet

Formation	Color	Hard or Soft	Top	Bottom	Oil, Gas or Water	Depth	Remarks
Red Rock			00	05			
Sand			05	15			
Red Rock			15	21			
Sand			21	35			
Red Rock			35	57			
Lime			57	74			
Red Rock			74	85			
Sand			85	97			
Red Rock & Lime			97	125			
Slate			125	150			
Red Rock, Lime			150	170	Water	170	
Lime			170	174			
Sand			174	197			
Lime			197	208			
Red Rock			208	214			
Slate			214	227			
Lime			227	265			
Red Rock			265	270			
Lime			270	325			
Red Rock			325	335			
Lime			335	345			
Red Rock			345	350			
Lime			350	365			
Shale & Red Rock			365	385			
Lime			385	412			
Shale & Shells			412	424			
Red Rock			424	474			
Sand			474	480			
Shale			480	500			
Sand			500	535			

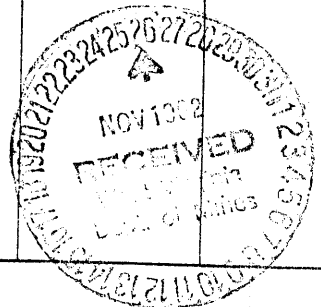

Formation	Color	Hard or Soft	Top <sup>6</sup>	Bottom	Oil, Gas or Water	Depth Found	Remarks
Shale			535	545			
Lime & Shale			545	606			
Shale			606	617			
Lime			617	635			
Sand			635	682			
Shale			682	687			
Lime			687	714			
Shale			714	745			
Lime			745	750			
Slate			750	755			
Lime			755	821			
Slate			821	846			
Red Rock			846	852			
Sand			852	861			
Lime			862	890			
Red Rock			890	900			
Shale			900	920			
Red Rock (Cave)			920	970			
Lime			970	1082			
Red Rock (Cave)			1082	1095			
Sand			1095	1110			
Red Rock & Lime			1110	1135			
Sand			1135	1155			
Lime			1155	1200			
Sand			1200	1236			
Slate			1236	1264			
Sand			1264	1300			
Lime			1300	1328			
Slate & Shells			1328	1344			
Sand			1344	1375			
Lime			1375	1413			
Sand			1413	1445			
Slate			1445	1455			
Lime			1455	1465			
Sand			1465	1495			
Slate & Shells			1495	1520			
Sand			1520	1540			
Lime			1540	1564			
Sand			1564	1585	Water	1585	
Sand, Hard			1585	1658			
Slate & Shells			1685	1703			
Sand			1703	1710			
Slate			1710	1713			
Sand			1713	1739			
Slate			1739	1795			
Sand			1795	1907			
Slate & Shells			1907	1953			
Red Rock			1953	1976			
Slate & Shells			1976	1990			
Lime			1990	2102			
Lime & Sandy			2102	2130	Show of Oil	2130	
Lime & Shaley			2130	2140			
Lime & Sandy			2140	2158			
Sandy			2158	2165			
Shale & Shells			2165	2216			
Total Depth			2216'				

Date 11-23, 1922

APPROVED [Signature], Owner

By \_\_\_\_\_ (Title)