

- Redrill.....
- New Location.
- Drill Deeper.....
- Abandonment.....

Company DEE DRILLING CO.

Address Box 352 MT. CARMEL, ILL

Farm GAINS HRS.

Tract \_\_\_\_\_ Acres 22 Lease No. \_\_\_\_\_

Well (Farm) No. 1 Serial No. \_\_\_\_\_

Elevation (Spirit Level) 1020' V.A.

Quadrangle CENTERPOINT C & W 9<sup>s</sup>

County DODDRIDGE District M<sup>c</sup>CLELLAN

Engineer Jama P. Jeffries

Engineer's Registration No. 1084

File No. 205/74 Drawing No. \_\_\_\_\_

Date 8-18-62 Scale 1" = 300'

STATE OF WEST VIRGINIA  
DEPARTMENT OF MINES  
OIL AND GAS DIVISION  
CHARLESTON

**WELL LOCATION MAP**

FILE NO. Doc - 868

+ Denotes location of well on United States Topographic Maps, scale 1" to 62,500, latitude and longitude lines being represented by border lines as shown.

— Denotes one inch spaces on border line of original tracing.

600



STATE OF WEST VIRGINIA  
DEPARTMENT OF MINES  
OIL AND GAS DIVISION 14

Quadrangle Center Point

Permit No. DOD-868

WELL RECORD

Oil or Gas Well DRY  
(KIND)


Company Dee Drilling Company  
Address Marietta, Ohio  
Farm Clyde Gains, et al Acres 22  
Location (waters) Broad Run  
Well No. 1 Elev. 1020  
District McClellan County Doddridge  
The surface of tract is owned in fee by Gains Heirs  
Address \_\_\_\_\_  
Mineral rights are owned by Gains Heirs  
Address \_\_\_\_\_  
Drilling commenced September 11, 1962  
Drilling completed October 24, 1962  
Date Shot \_\_\_\_\_ From \_\_\_\_\_ To \_\_\_\_\_  
With \_\_\_\_\_  
Open Flow 0 /10ths Water in \_\_\_\_\_ Inch  
\_\_\_\_\_ /10ths Merc. in \_\_\_\_\_ Inch  
Volume None Cu. Ft.  
Rock Pressure None lbs. \_\_\_\_\_ hrs.  
Oil \_\_\_\_\_ bbls., 1st 24 hrs.  
Fresh water \_\_\_\_\_ feet \_\_\_\_\_ feet  
Salt water \_\_\_\_\_ feet \_\_\_\_\_ feet

Casing and Tubing	Used in Drilling	Left in Well	Packers
Size			
16	16'	0	Kind of Packer _____
13			
10	390'	0	Size of _____
8 1/4	1101'	0	
6 1/2			Depth set _____
5 3/16			
3			Perf. top _____
2			Perf. bottom _____
Liners Used			Perf. top _____
			Perf. bottom _____

CASING CEMENTED No SIZE \_\_\_\_\_ No. Ft. \_\_\_\_\_ Date \_\_\_\_\_

COAL WAS ENCOUNTERED AT 242 FEET \_\_\_\_\_ INCHES  
\_\_\_\_\_ FEET \_\_\_\_\_ INCHES FEET \_\_\_\_\_ INCHES  
\_\_\_\_\_ FEET \_\_\_\_\_ INCHES FEET \_\_\_\_\_ INCHES

Formation	Color	Hard or Soft	Top	Bottom	Oil, Gas or Water	Depth Found	Remarks
Red Rock			0	20			
Slate			20	35			
Red Rock			35	60			
Sand			60	70			
Slate			70	80			
Red Rock			80	90			
Slate			90	120			
Red Rock			120	180			
Slate & Shells			180	242			
Coal			242	247			
Slate & Shells			247	350			
Red Rock			350	360			
Slate & Lime			360	440			
Sand			440	485			
Lime			485	525			
Slate & Shells			525	535			
Red Rock			535	540			
Sand			540	580			
Slate & Shells			580	720			
Lime			720	749			
Slate & Lime			749	785			
Sand			785	840			
Slate			840	842			
Lime			842	892			
Sand			892	928			
Lime			928	940			
Red Rock			940	950			
Lime			950	1020			
Slate & Shells			1020	1068			
Red Rock			1068	1085			
Slate & Shells			1085	1184			
Sand			1184	1245			
Slate			1245	1308			
Sand			1308	1327			
Slate			1327	1387			
Lime			1387	1425			

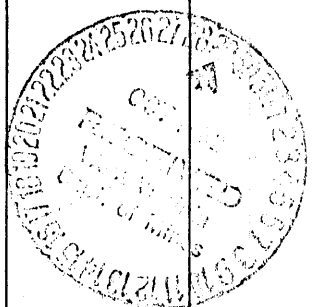

Formation	Color	Hard or Soft	Top 14	Bottom	Oil, Gas or Water	Depth Found	Remarks
Shale			1425	1456			
Sand			1456	1495			
Broken Sand			1495	1626			
Sand		Hard	1626	1760	Gas - 1679	8/10 - 1"	Water
Slate & Shells			1760	1905	Gas - 1682	1.5/10 - 1"	
Red Rock			1905	1999	Water - 1 1/2	Bailers per	Hour
Slate			1999	2020			
Lime			2020	2032			
Slate			2032	2048			
Lime			2048	2115			
Big Injun Sand			2115	2142			
Lime			2142	2163	Scum of Oil - 2149 -	Smell of Gas	
Sand			2163	2257	Water - 2243 -	4 Bailers per	Hour
Shale Break			2257	2264			
Sand			2264	2287			
Shale			2287	2304			
Lime			2304	2322			
Slate & Shells			2322	2376 - TOTAL DEPTH			

Date October 27, 1962

APPROVED Dee Drilling Company, Owner

By Edward A. Hamilton  
Geologist (Title)