

New Location
 Drill Deeper
 Abandonment

Company PETROLEUM PROMOTIONS
 Address 212 Nelson Bldg. Charleston, West Va.
 Farm Sherwood Lease
 Tract _____ Acres 32 Lease No. _____
 Well (Farm) No. One Serial No. _____
 Elevation (Spirit Level) 1075
 Quadrangle West Union SC
 County Doddridge District Central
 Engineer [Signature]
 Engineer's Registration No. 1227
 File No. _____ Drawing No. _____
 Date Oct. 11, 1962 Scale 1" = 300' = 495'

STATE OF WEST VIRGINIA
 DEPARTMENT OF MINES
 OIL AND GAS DIVISION
 CHARLESTON

WELL LOCATION MAP
 FILE NO. Dod- 879 (Revised)
10-26-62

+ Denotes location of well on United States Topographic Maps, scale 1 to 62,500, latitude and longitude lines being represented by border lines as shown.
 - Denotes one inch spaces on border line of original tracing.

6-6-87



STATE OF WEST VIRGINIA
DEPARTMENT OF MINES
OIL AND GAS DIVISION //

Quadrangle West Union

Permit No. DOD-879

WELL RECORD

Oil or Gas Well oil, gas
(KIND)


Company Petroleum Promotions Inc.
Address Box 105 Weston, W. Virginia
Farm Sherwood, ET AL Acres 32
Location (waters) Wilhelm Run
Well No. 1 Elev. 1075'
District Central County Doddridge
The surface of tract is owned in fee by Clarence Hyatt, ET AL - Rt. 1, Address West Union, W. VA.
Mineral rights are owned by Clarence Hyatt, ET AL Rt. 1 Address West Union, W. VA.
Drilling commenced October 25, 1962
Drilling completed December 9, 1962
Date Shot _____ From _____ To _____
With _____
Open Flow /10ths Water in _____ Inch
/10ths Merc. in _____ Inch
Volume Show of Gas & Oil Cu. Ft.
Rock Pressure _____ lbs. _____ hrs.
Oil _____ bbls., 1st 24 hrs.
WELL ACIDIZED _____

Casing and Tubing	Used in Drilling	Left in Well	Packers
Size			
16			Kind of Packer _____
18	19'	19'	
10	191'	None	Size of _____
8"	980'	None	
7"	1575'	None	Depth set _____
4 1/2"	2161'	Cemented	
3			Perf. top <u>2063'</u>
2			Perf. bottom <u>2067'</u>
Liners Used			Perf. top <u>2103'</u>
			Perf. bottom <u>2105'</u>

WELL FRACTURED 2 Pumpers 13,000 gals. Water 25,000# Sand

RESULT AFTER TREATMENT 20bbls. & 150Mcf Gas
ROCK PRESSURE AFTER TREATMENT 575PSI 24 Hrs.
Fresh Water _____ Feet 40' Salt Water 460' 1500' Feet 1555'

Formation	Color	Hard or Soft	Top	Bottom	Oil, Gas or Water	Depth	Remarks
Clay			00	20			
Shale			20	30			
Sand			30	87	Water	40'	
Red Rock			87	95			
Slate			95	110			
Lime			110	121			
Shale			121	125			
Sand			125	157			
Slate			157	166			
Red Rock			156	174			
Lime & Sandy			174	191			
Slate			191	246			
Sand			246	255			
Red Rock			255	260			
Lime			260	290			
Red Rock			290	316			
Sand			316	328			
Red Rock			328	350			
Lime			350	353			
Red Rock			353	364			
Shale & Shells			364	413			
Sand			413	429			
Red Rock			429	434			
Sand			434	445			
Red Rock & Shells			445	460			
Sand			460	490	Water		
Lime			490	512			
Red Rock			512	542			
Sand			542	554			
Red Rock			554	570			

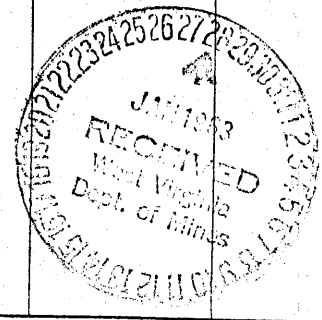

Formation	Color	Hard or Soft	Top //	Bottom	Oil, Gas or Water	Depth Found	Remarks
Shale			570	602			
Sand			602	651			
Lime			651	670			
Sand			670	700			
Shale & Shells			700	728			
Lime			728	739			
Shale & Shells			739	770			
Sand			770	795			
Slate			795	825			
Lime			825	840			
Shale & Shells			840	875			
Red Rock			875	933			
Lime			933	943			
Red Rock			943	961			
Lime			961	965			
Red Rock & Shells			965	980			
Sand			980	1030			
Lime			1030	1047			
Red Rock & Shells			1047	1055			
Lime			1055	1093			
Red Rock			1093	1095			
Lime			1095	1122			
Slate			1122	1125			
Lime			1125	1135			
Slate			1135	1150			
Lime			1150	1163			
Slate			1163	1168			
Sand			1168	1194			
Lime			1194	1205			
Slate & Shells			1205	1220			
Sand			1220	1250			
Lime			1250	1275			
Sand			1275	1295			
Slate & Shells			1295	1315			
Sand			1315	1403			
Slate			1403	1419			
Lime			1419	1427			
Sand			1427	1440			
Slate & Shells			1440	1500			
Sand			1500	1538	Water		
Lime			1538	1550			
Sand			1550	1622			
Slate			1622	1669			
Sand			1669	1682			
Slate & Shells			1682	1690			
Sand			1690	1713			
Slate			1713	1722			
Sand			1722	1732			
Slate & Shells			1732	1752			
Sand			1752	1771			
Slate			1771	1785			
Sand			1785	1801			
Slate			1801	1838			
Sand			1838	1862			
Slate			1862	1893			
Sand			1893	1903			
Lime			1903	1906			
Slate			1906	1910			
Sand			1910	1918			
Slate & Shells			1918	1949			
Lime			1949	2063	Water		
Lime			2063	2090	Oil	2063'	
Sand			2090	2095			
Lime			2095	2100			
Sand & Lime			2100	2103			
Sand			2103	2123	Oil & Gas		
Shale			2123	2161			
Total Depth				2161			

Date Jan 24, 1963

APPROVED Petroleum Promotions, Inc., Owner

By Jerry M. ...
(Title)