


SEP 1 1 1978

Date Oct. 20, 1962 Scale 1": 40p = 660'

K-E 1860 IMPERIAL 60286

1840 IMPERIAL 60286

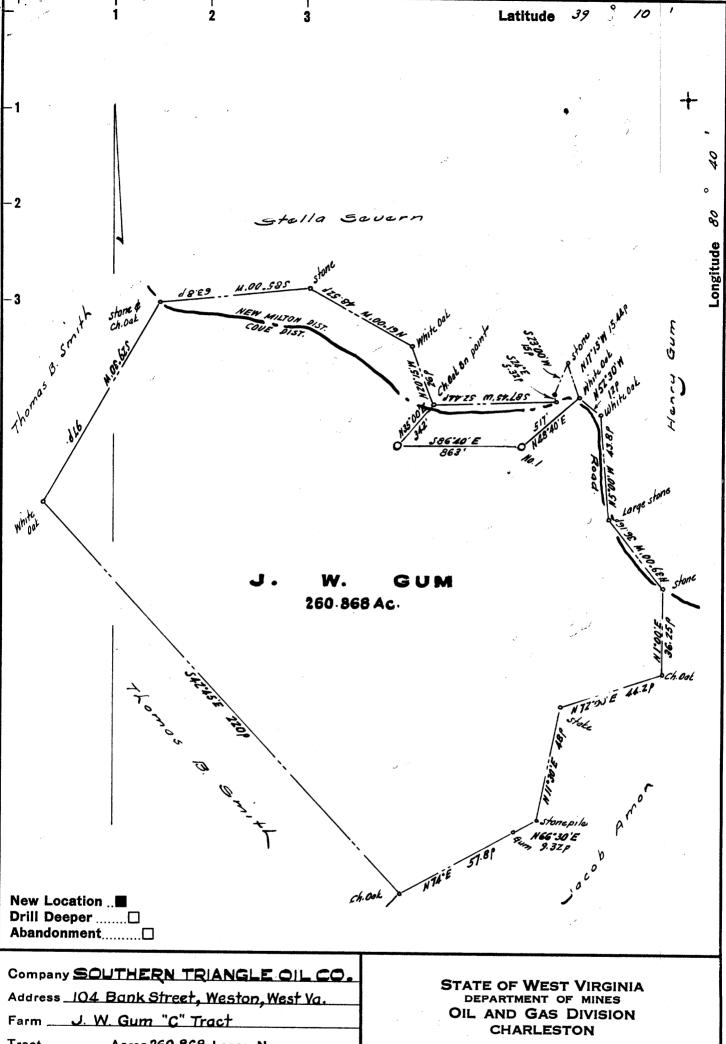

Address 104 Bank Street, Weston, West Va. Farm J. W. Gum "C" Tract Tract Acres 260.868 Lease No. Well (Farm) No. Two Serial No. Elevation (Spirit Level) 1153 Quadrangle Vadis FC County Doddridge District Cove Engineer District Cove Engineer's Registration No. 1227 File No. Drawing No. Date Oct. 20, 1962 Scale 1": 40p = 660'

WELL LOCATION MAP

P

- + Denotes location of well on United States Topographic Maps, scale 1 to 62,500, latitude and longitude lines being represented by border lines as shown.
- Denotes one inch spaces on border line of original tracing.