

New Location ...    
 Drill Deeper .....    
 Abandonment .....

Company Prior Oil Company  
 Address 720 Union Trust Bldg., Parkersburg  
 Farm Alice Fitzwilliams  
 Tract \_\_\_\_\_ Acres 70 Lease No. \_\_\_\_\_  
 Well (Farm) No. One Serial No. \_\_\_\_\_  
 Elevation (Spirit Level) 1176'  
 Quadrangle Vadis NW  
 County Doddridge District New Milton  
 Engineer Walter J. [Signature]  
 Engineer's Registration No. 1227  
 File No. \_\_\_\_\_ Drawing No. \_\_\_\_\_  
 Date Oct. 27, 1962 Scale 1" = 300' = 495'

STATE OF WEST VIRGINIA  
 DEPARTMENT OF MINES  
 OIL AND GAS DIVISION  
 CHARLESTON

**WELL LOCATION MAP**  
 FILE NO. Dod - 897

+ Denotes location of well on United States Topographic Maps, scale 1 to 62,500, latitude and longitude lines being represented by border lines as shown.

- Denotes one inch spaces on border line of original tracing.

6-6-134



STATE OF WEST VIRGINIA  
DEPARTMENT OF MINES  
OIL AND GAS DIVISION 4

Quadrangle Vadis

Permit No. DOD-897

**WELL RECORD**

Oil or Gas Well Oil

Company Prior Oil Company  
Address 720 Union Trust, Parkersburg, W. Va.  
Farm Fitzwilliams Acres 70  
Location (waters) \_\_\_\_\_  
Well No. One Elev. 1176  
District New Milton County Doddridge  
The surface of tract is owned in fee by Robert Holland  
Address West Union, W. Va.  
Mineral rights are owned by Robert Holland  
Address West Union, W. Va.  
Drilling commenced 1-7-63  
Drilling completed 1-28-63  
Date Shot \_\_\_\_\_ From \_\_\_\_\_ To \_\_\_\_\_  
With \_\_\_\_\_  
Open Flow \_\_\_\_\_ /10ths Water in \_\_\_\_\_ Inch  
\_\_\_\_\_ /10ths Merc. in \_\_\_\_\_ Inch  
Volume Not taken Cu. Ft.  
Rock Pressure Not taken lbs. \_\_\_\_\_ hrs.  
Oil \_\_\_\_\_ bbls., 1st 24 hrs.  
WELL ACIDIZED 200 gal.

Casing and Tubing	Used in Drilling	Left in Well	Packers
Size			Kind of Packer _____
16			Size of _____
13			Depth set _____
10			Perf. top <u>2119'</u>
8 3/4			Perf. bottom <u>2121'</u>
6 3/4			Perf. top _____
5 3/16			Perf. bottom _____
3			
<del>X</del> 4 1/2"		<u>2778'</u>	
Liners Used			

CASING CEMENTED 4 1/2" SIZE 2778' No. Ft. 1-28-63 Date  
109 sks. H.E. cement-36 sks. regular cement  
1 sk. calcium chloride-Dowell  
COAL WAS ENCOUNTERED AT \_\_\_\_\_ FEET \_\_\_\_\_ INCHES  
\_\_\_\_\_ FEET \_\_\_\_\_ INCHES FEET \_\_\_\_\_ INCHES  
\_\_\_\_\_ FEET \_\_\_\_\_ INCHES FEET \_\_\_\_\_ INCHES

WELL FRACTURED 600 bbls. wtr. - 30,000 sand

Drilled with rotary circulating gel.


RESULT AFTER TREATMENT 50 bbls. oil - 24 hrs.

ROCK PRESSURE AFTER TREATMENT 645# - 24 hrs.

Fresh Water \_\_\_\_\_ Feet Salt Water \_\_\_\_\_ Feet

Formation	Color	Hard or Soft	Top	Bottom	Oil, Gas or Water	Depth	Remarks
Surface			0	19			
Red rock			19	47			
Sand & sh.			47	91			
Sand			91	117			
Shale			117	146			
Sand			146	172			
Shale			172	263			
Sand			263	339			
Shale & sand			339	562			
Sdy. shale			562	639			
Sand & shale			639	692			
Sand			692	718			
Sand & shale			718	820			
Shale			820	1133			
Sand & shale			1133	1192			
Shly. sand			1192	1289			
Sand & shale			1289	1293			
Shly. sand			1293	1314			
Sand			1314	1405			
Sand & shale			1405	1482			
Shale & sand			1482	1623			
Sand			1623	1687			
Sand & shale			1687	1749			
Sdy. lime			1749	1793			
Shale			1793	1867			
Shly. sand			1867	1917			
Sand & shale			1917	1942			
Shly. sand			1942	1995			
Lime			1995	2036			

(over)

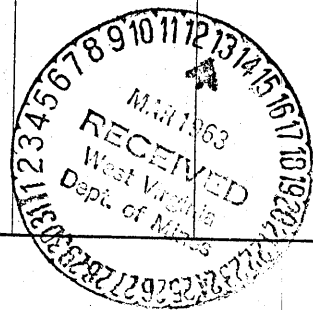

Formation	Color	Hard or Soft	Top 4	Bottom	Oil, Gas or Water	Depth Found	Remarks
Sand & lime			2036	2045	Oil		
Sand			2045	2099			
Shly. sand			2099	2119	Oil		
Sand			2119	2268			
Shly. sand			2268	2271			
Sand			2271	2289			
Sh. & sand			2289	2293			
Sand			2293	2462			
Shly. sand			2462	2475			
Sh. & sand			2475	2713			
Sand			2713	2725	Oil		
Shale			2725	2740	T.D.		

Date Mar 12, 1963

APPROVED Prinn Oil Co, Owner

By Joe M. Laughlin  
(Title)